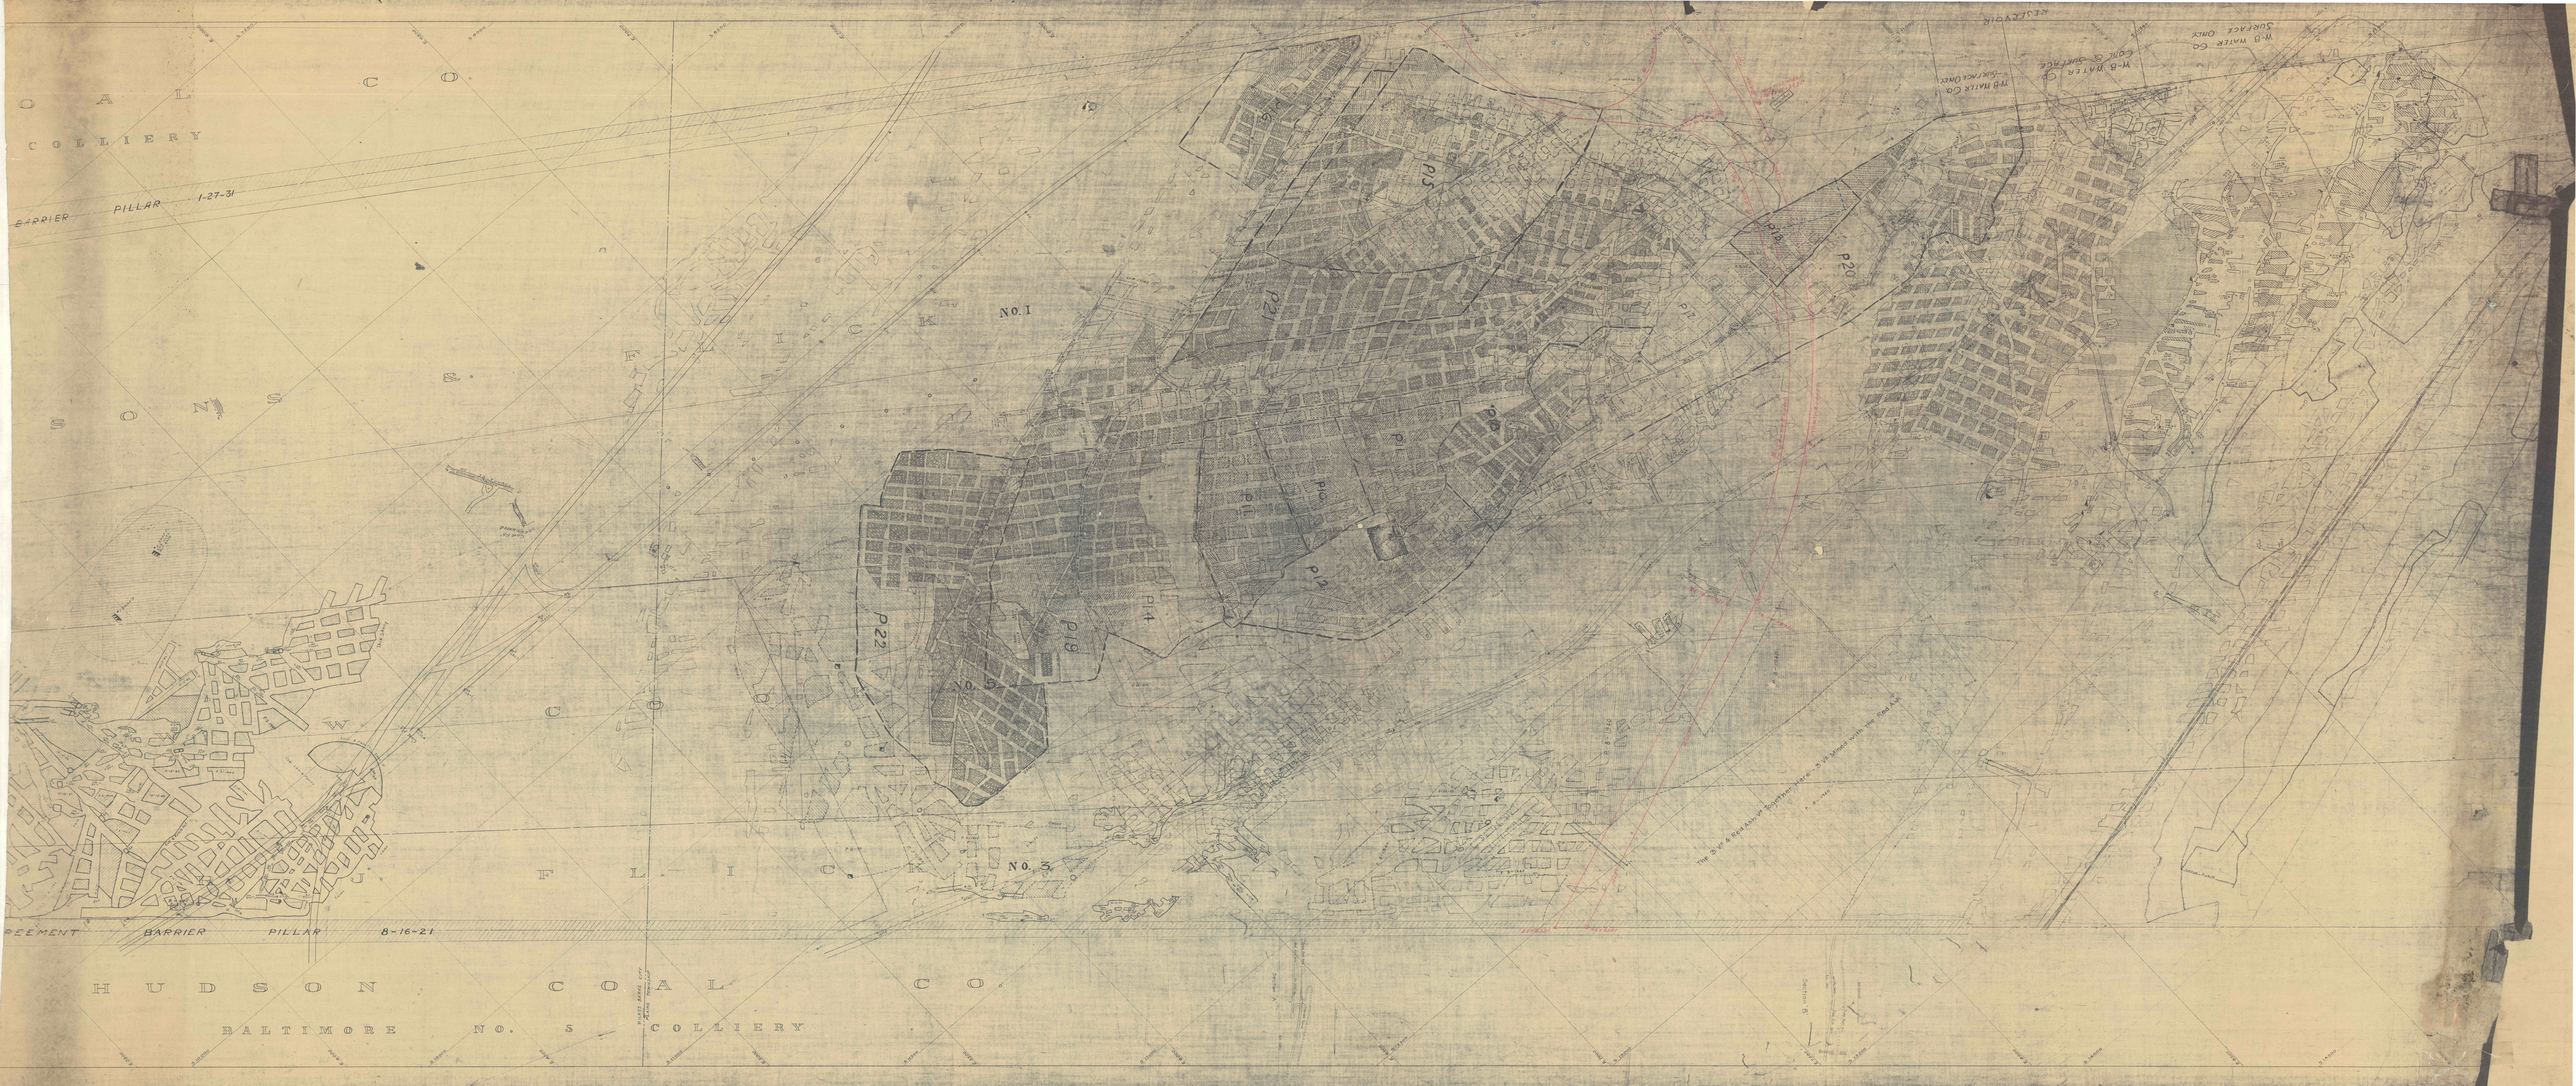
COLLIERY
BARRIER PILLAR 1-27-31
NO. 1
P22
P15
P16
P20
P12
P14
P19
P22
NO. 3
BARRIER PILLAR 8-16-21
HUDSON COAL CO.
BALTIMORE NO. 5 COLLIERY