


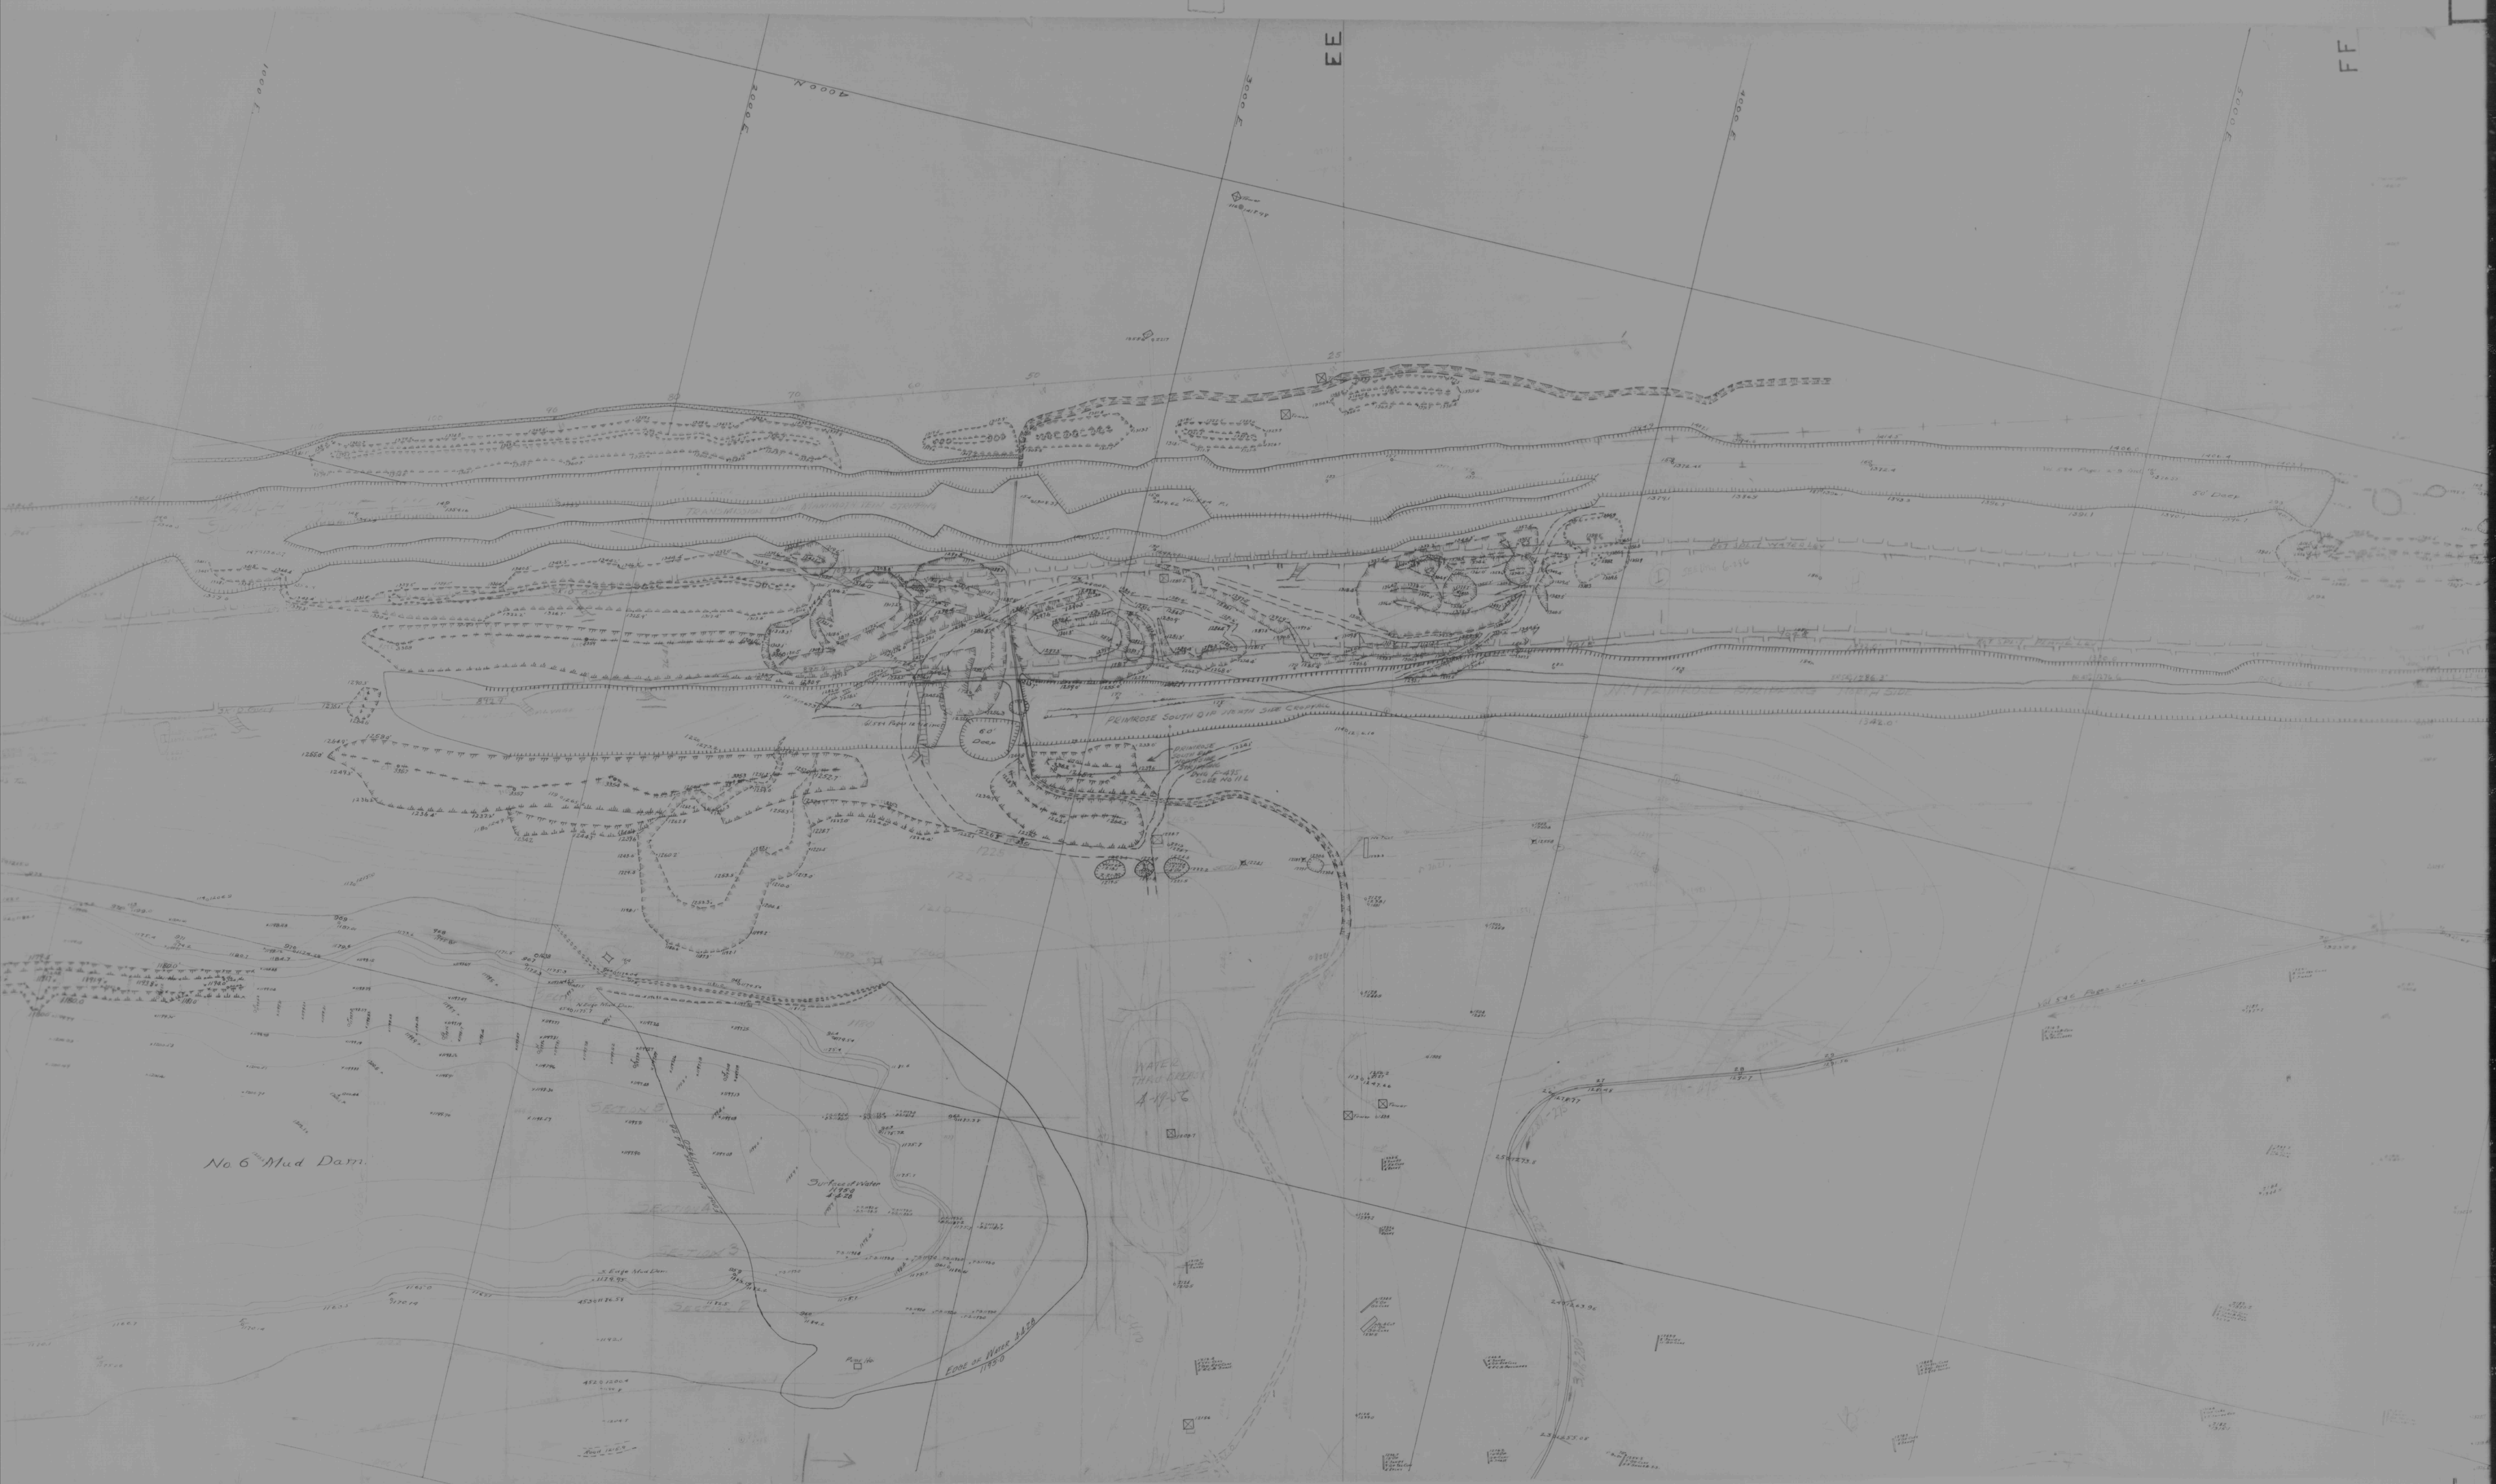

S048-00124-1/10030

FIELD

U.S. DEPT. OF INTERIOR

BUREAU OF MINES

1 2 3 4 5 6 7 8 9 10 11 12

INCHES

MAP NUMBER

FRAME REPEAT

SCALE

REDUCTION

RATIO

CONFIDENTIAL

FOR USE ONLY BY FEDERAL

AGENCIES AND ONLY FOR

TECHNICAL, ECONOMIC,

OR STATISTICAL PURPOSES

AND STUDIES NOT RE-

LATED WITH ANY INVESTI-

GATION, REGULATION,

OR LITIGATION

PURPOSES.