


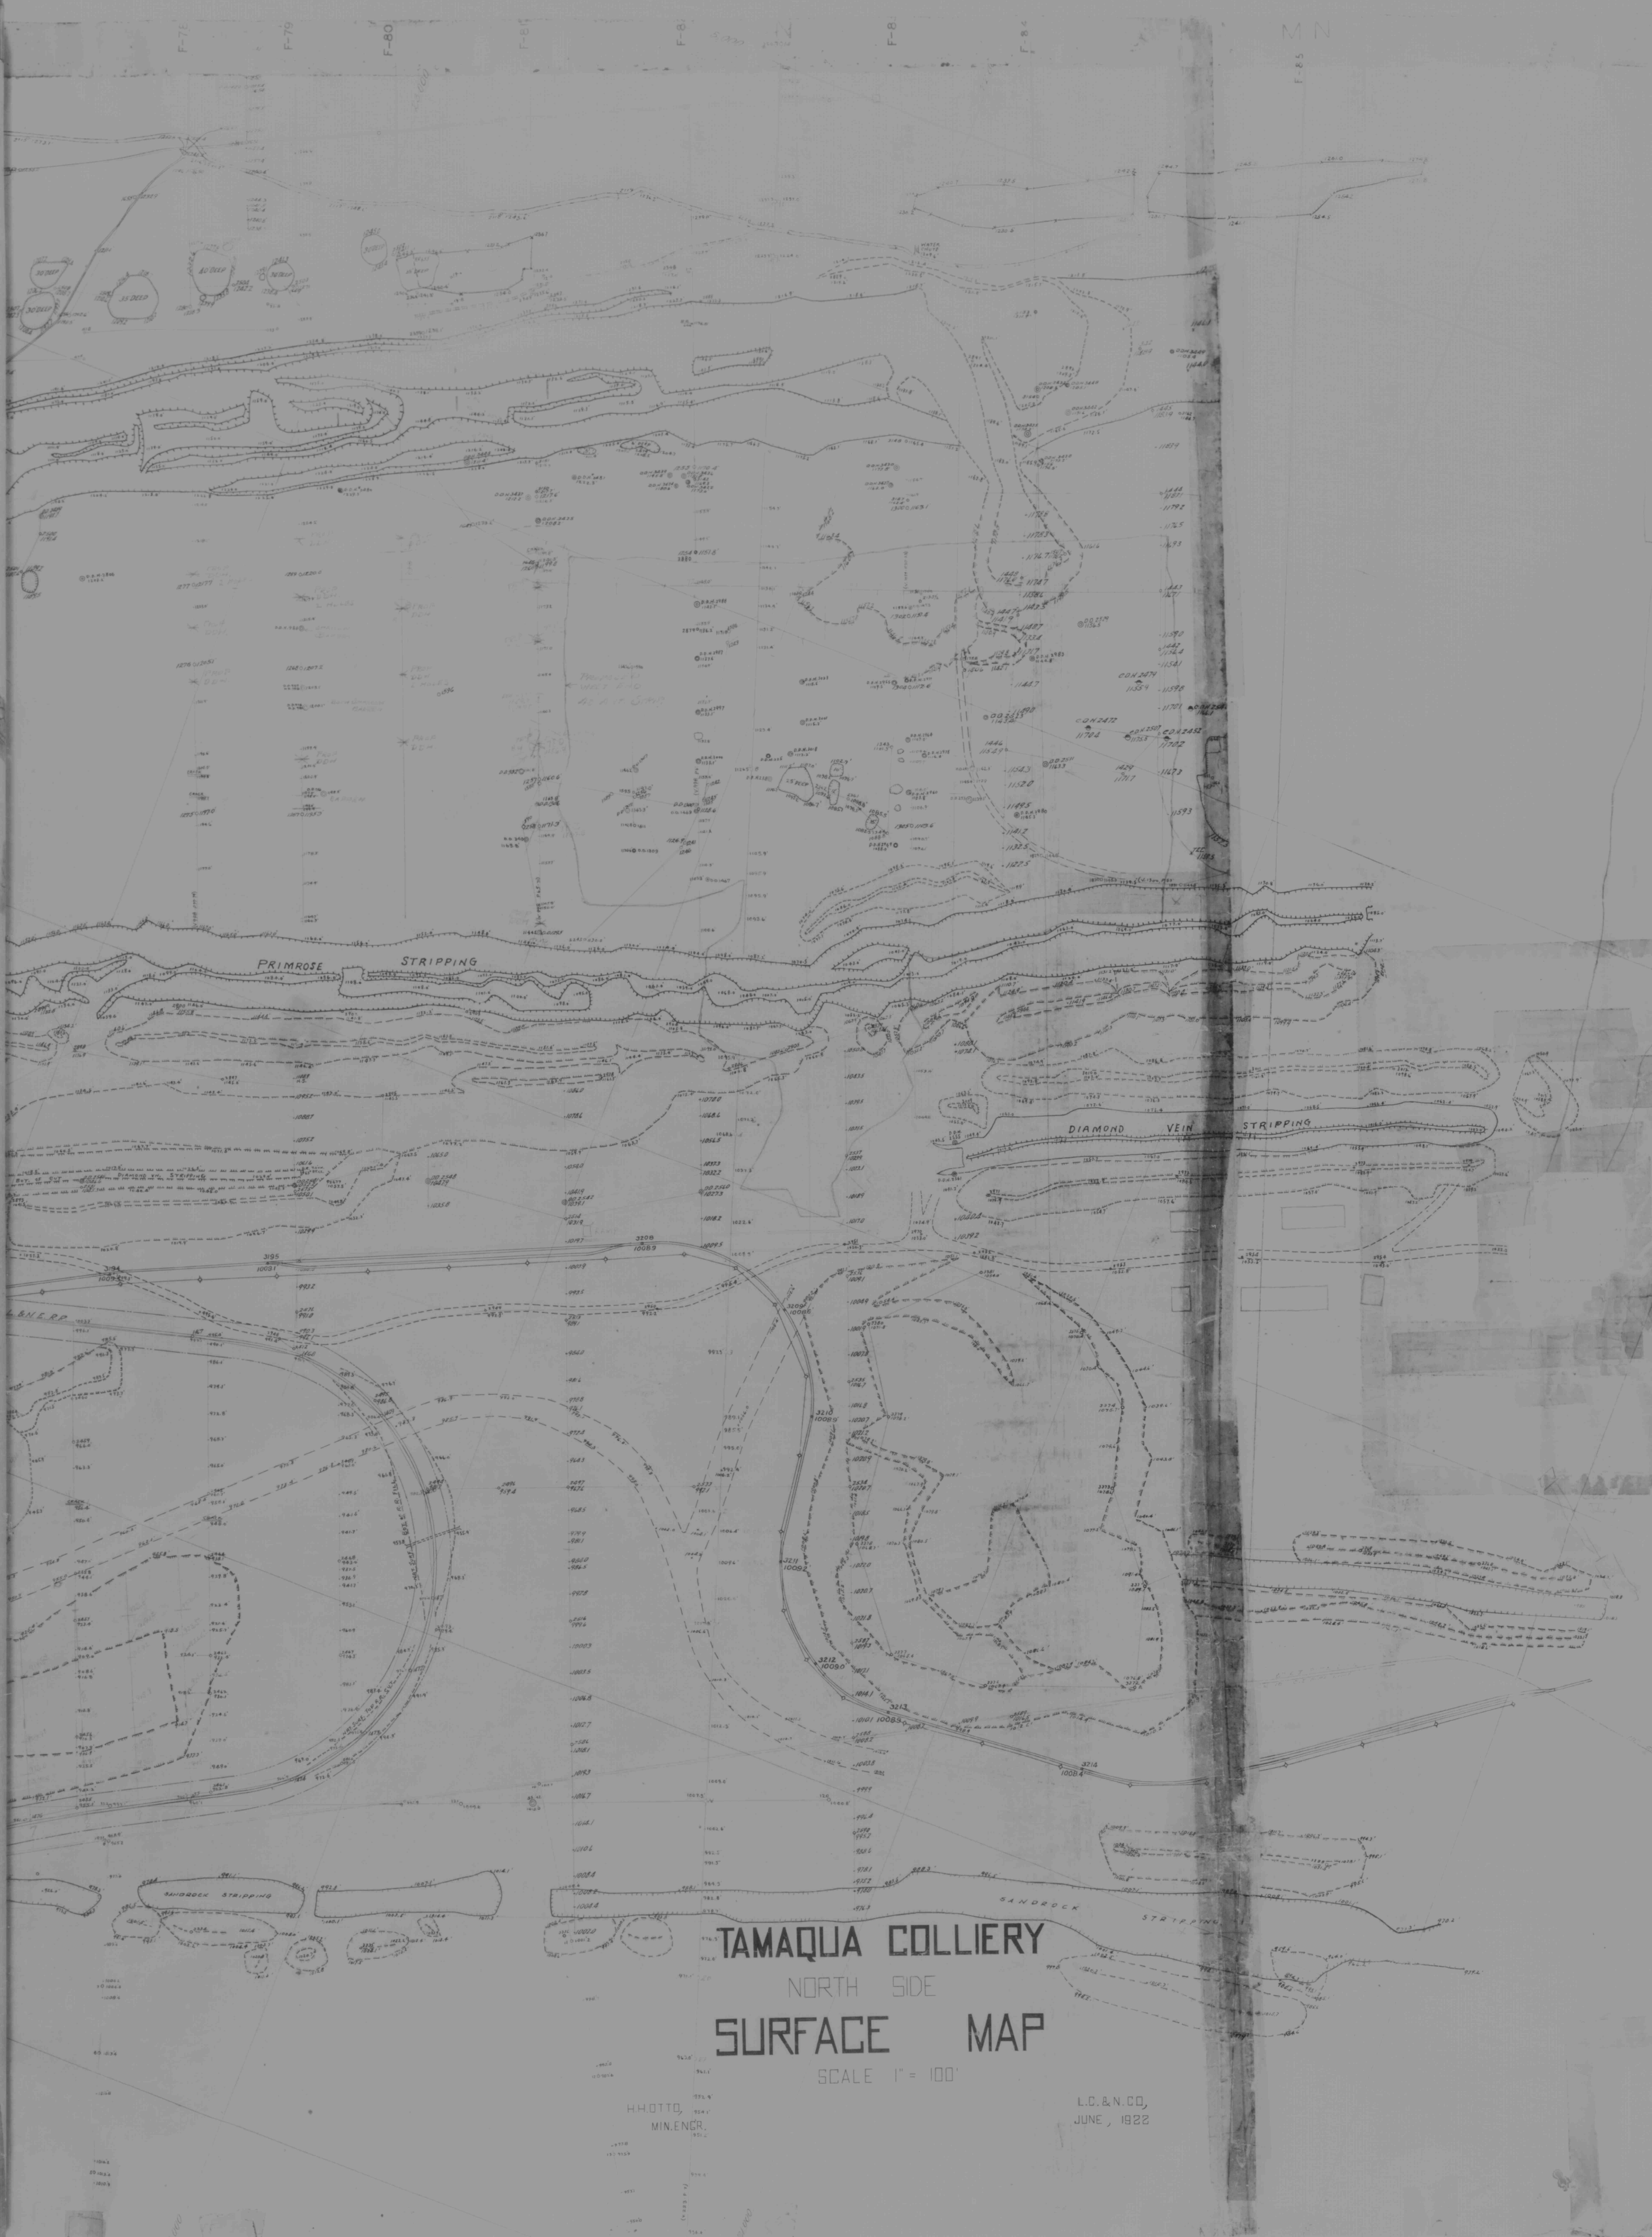

**TAMAQUA COLLIERY**  
NORTH SIDE  
**SURFACE MAP**

SCALE 1" = 100'


L.C. & N. CO.  
JUNE, 1922




