


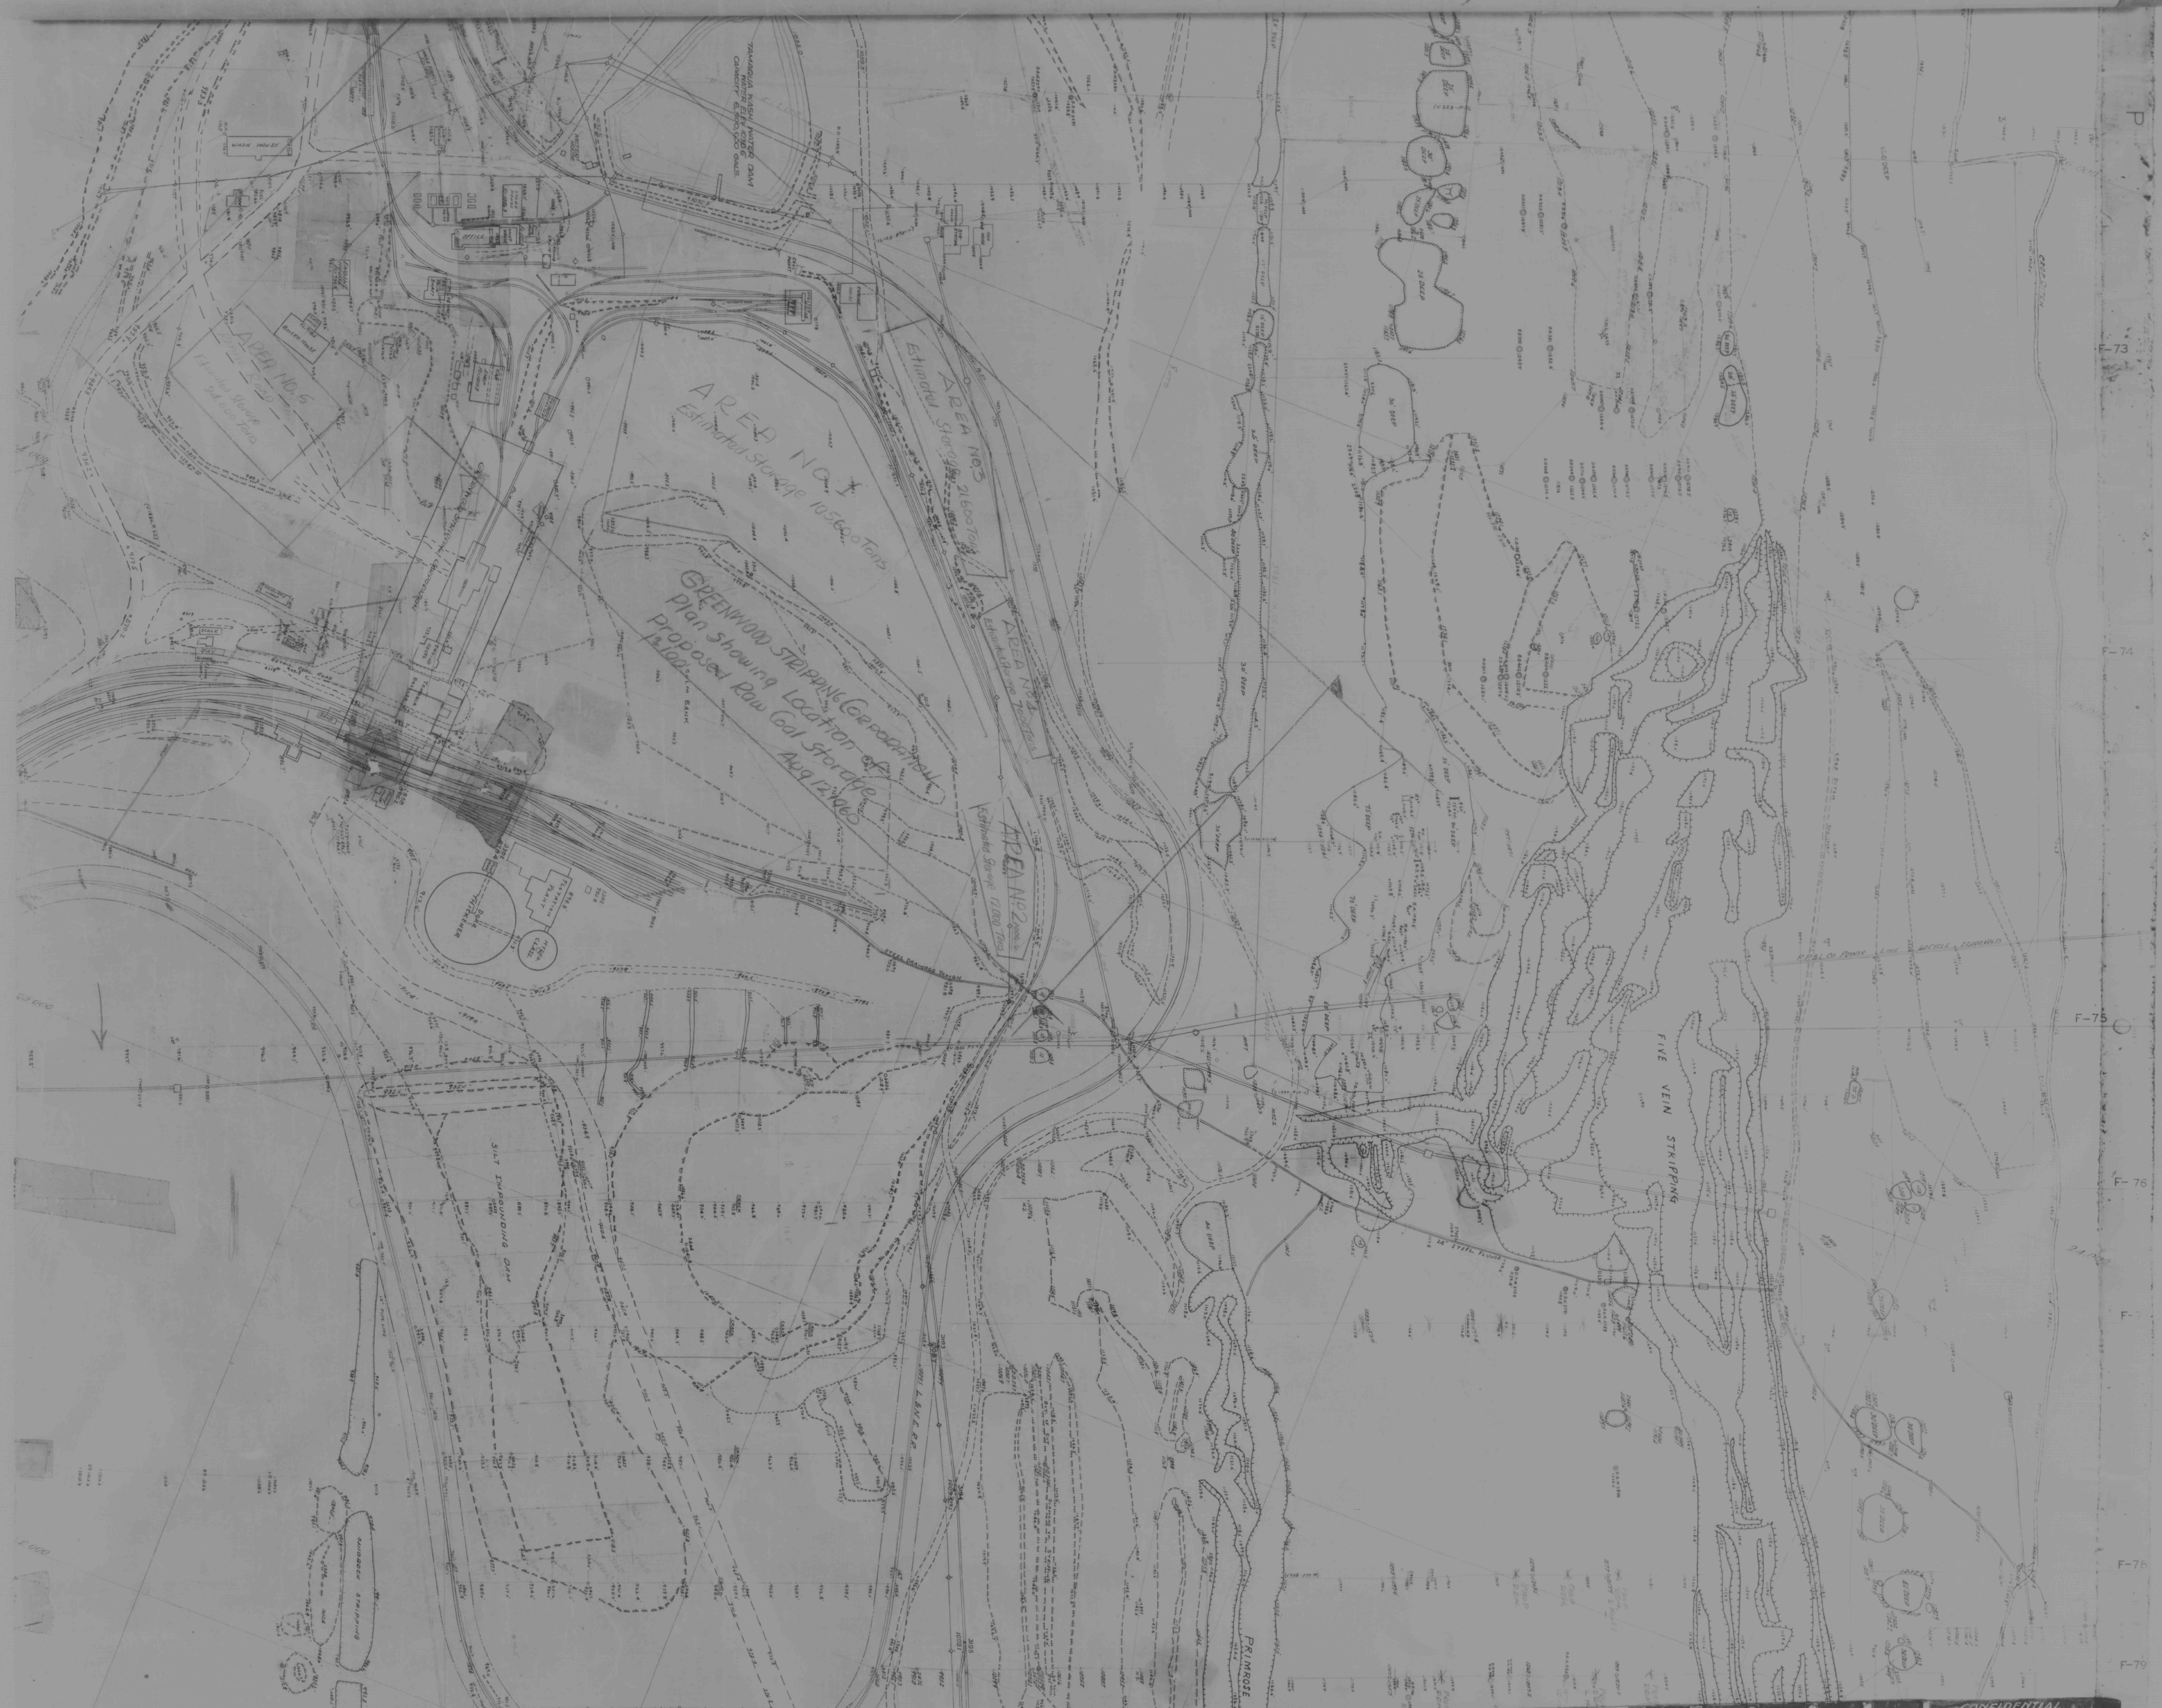

S 0 4 4 - 0 0 1 2 4 - 1 1 0 0 3 0

CONFIDENTIAL
FOR USE ONLY BY FEDERAL
AGENCIES AND ONLY FOR
TECHNICAL, ECONOMIC,
OR STATISTICAL PURPOSES
AND STUDIES NOT RE-
LATED WITH ANY TARIFF
INVESTIGATION, REGULA-
TION OR LITIGATION.