


Areas to July 31 1922


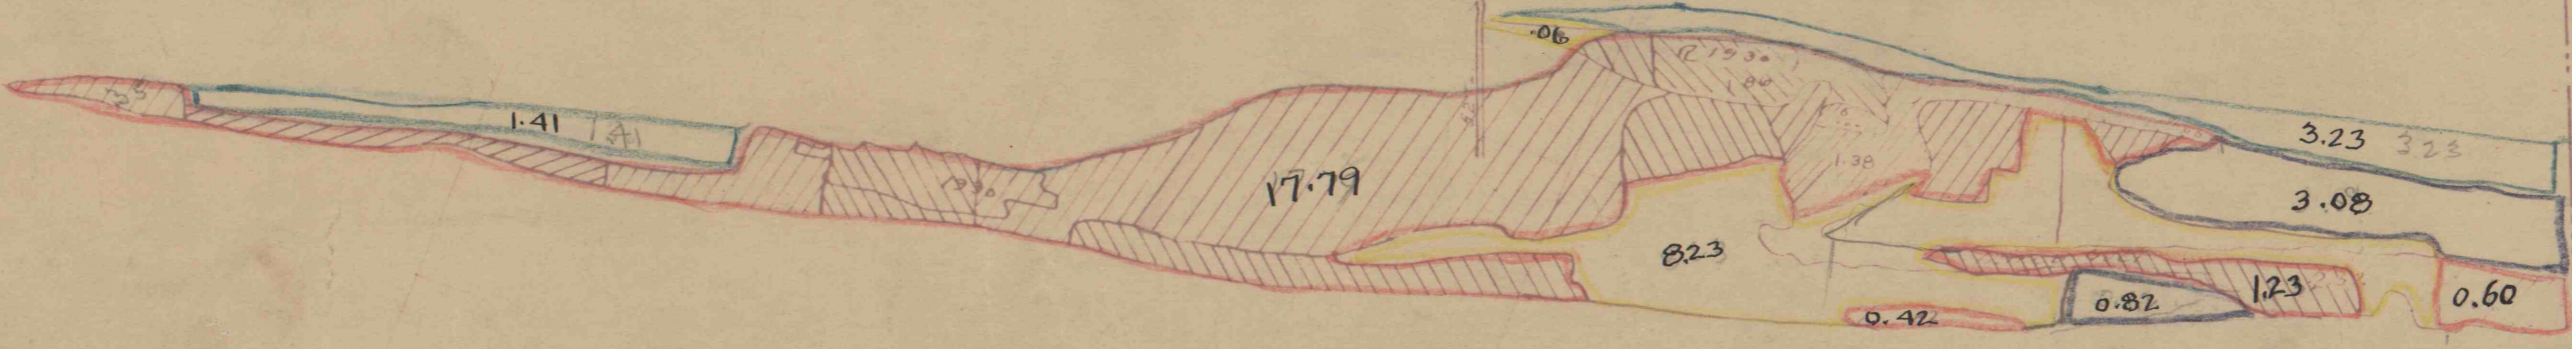

COOPER