


7.18  
271.42  
2.70  
.59

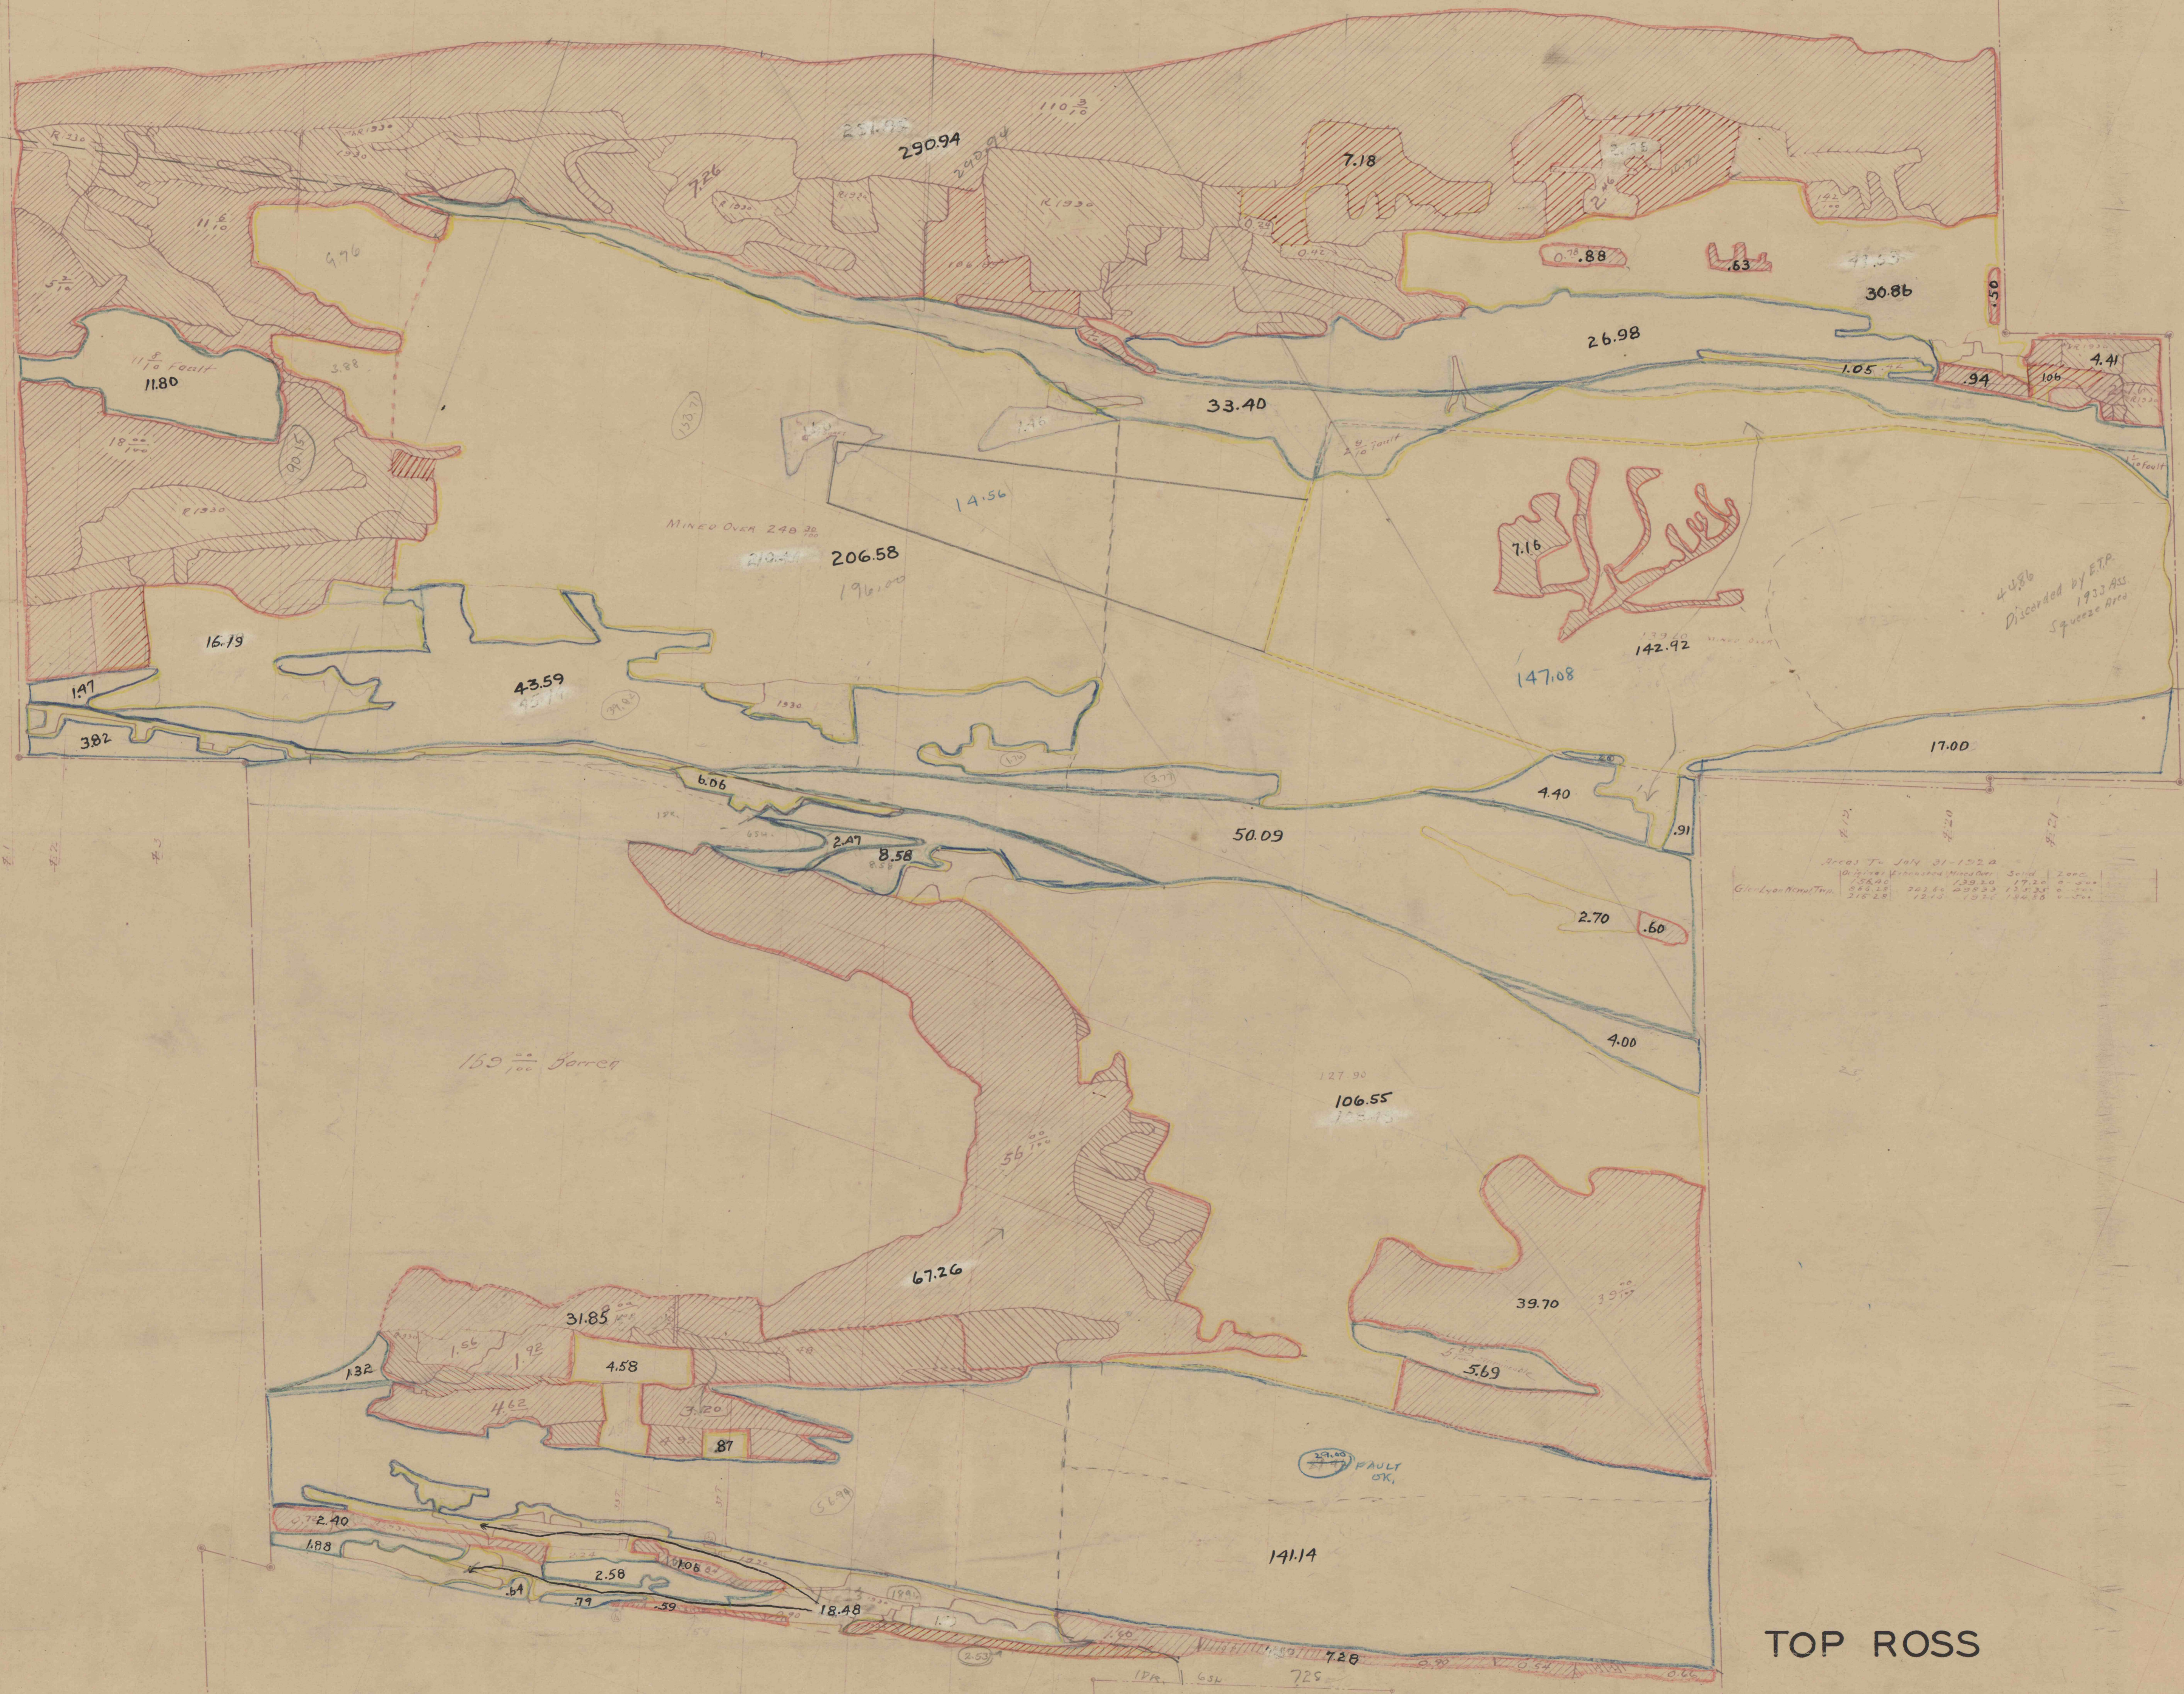

3970  
1200

4-486  
Discarded by E.P.  
1933 Ass  
Squeeze Area


159 <sup>100</sup> Barren

TOP ROSS