


45

4.5

45

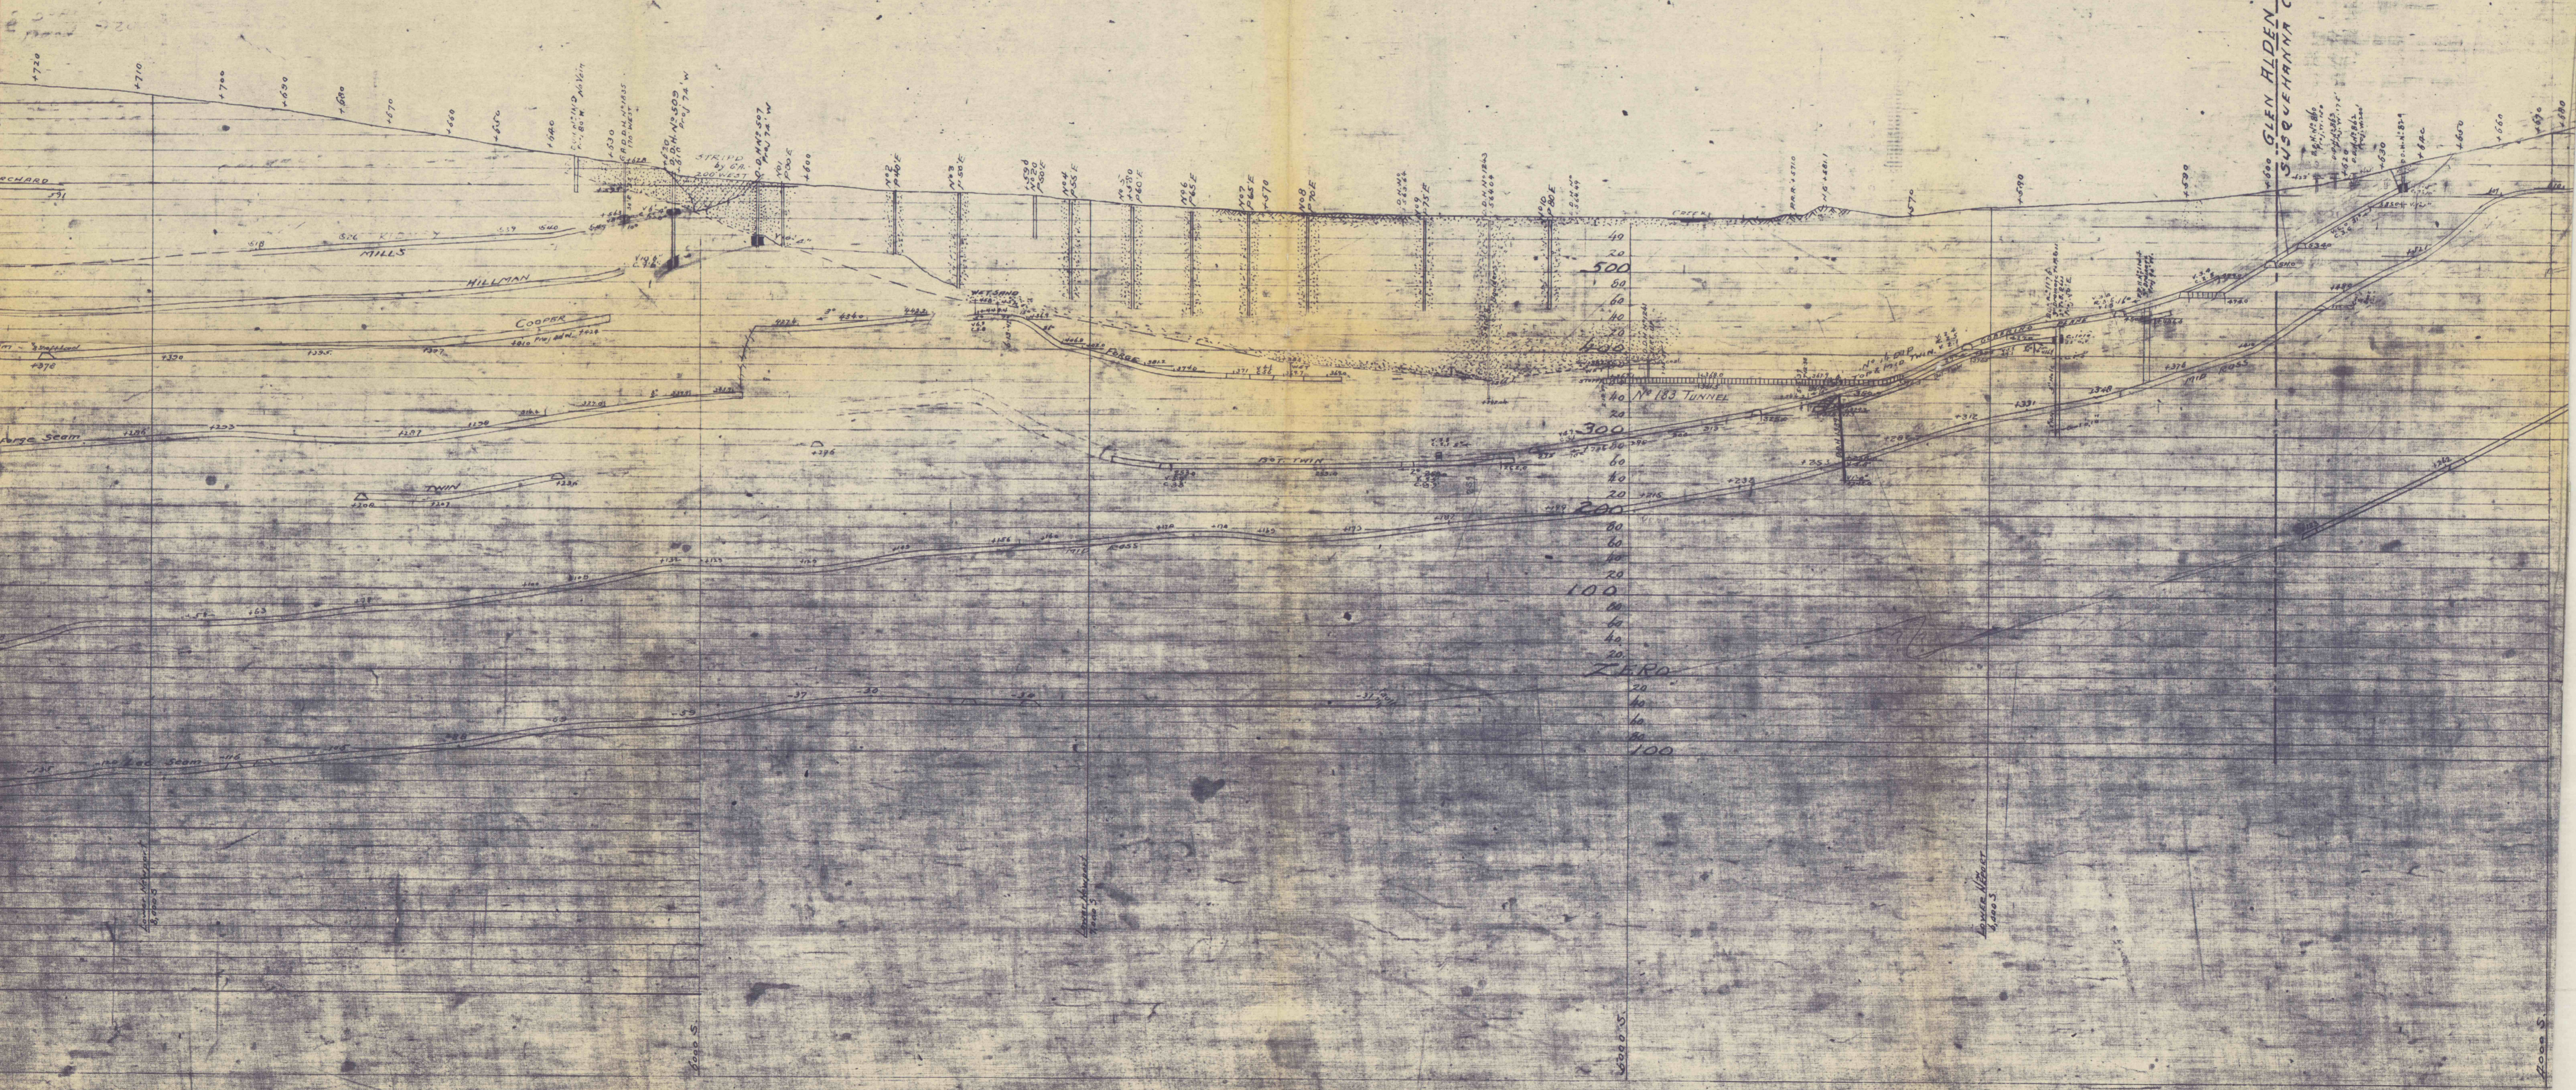

SUSQUEHANNA COLLIERIES CO.