


46

46

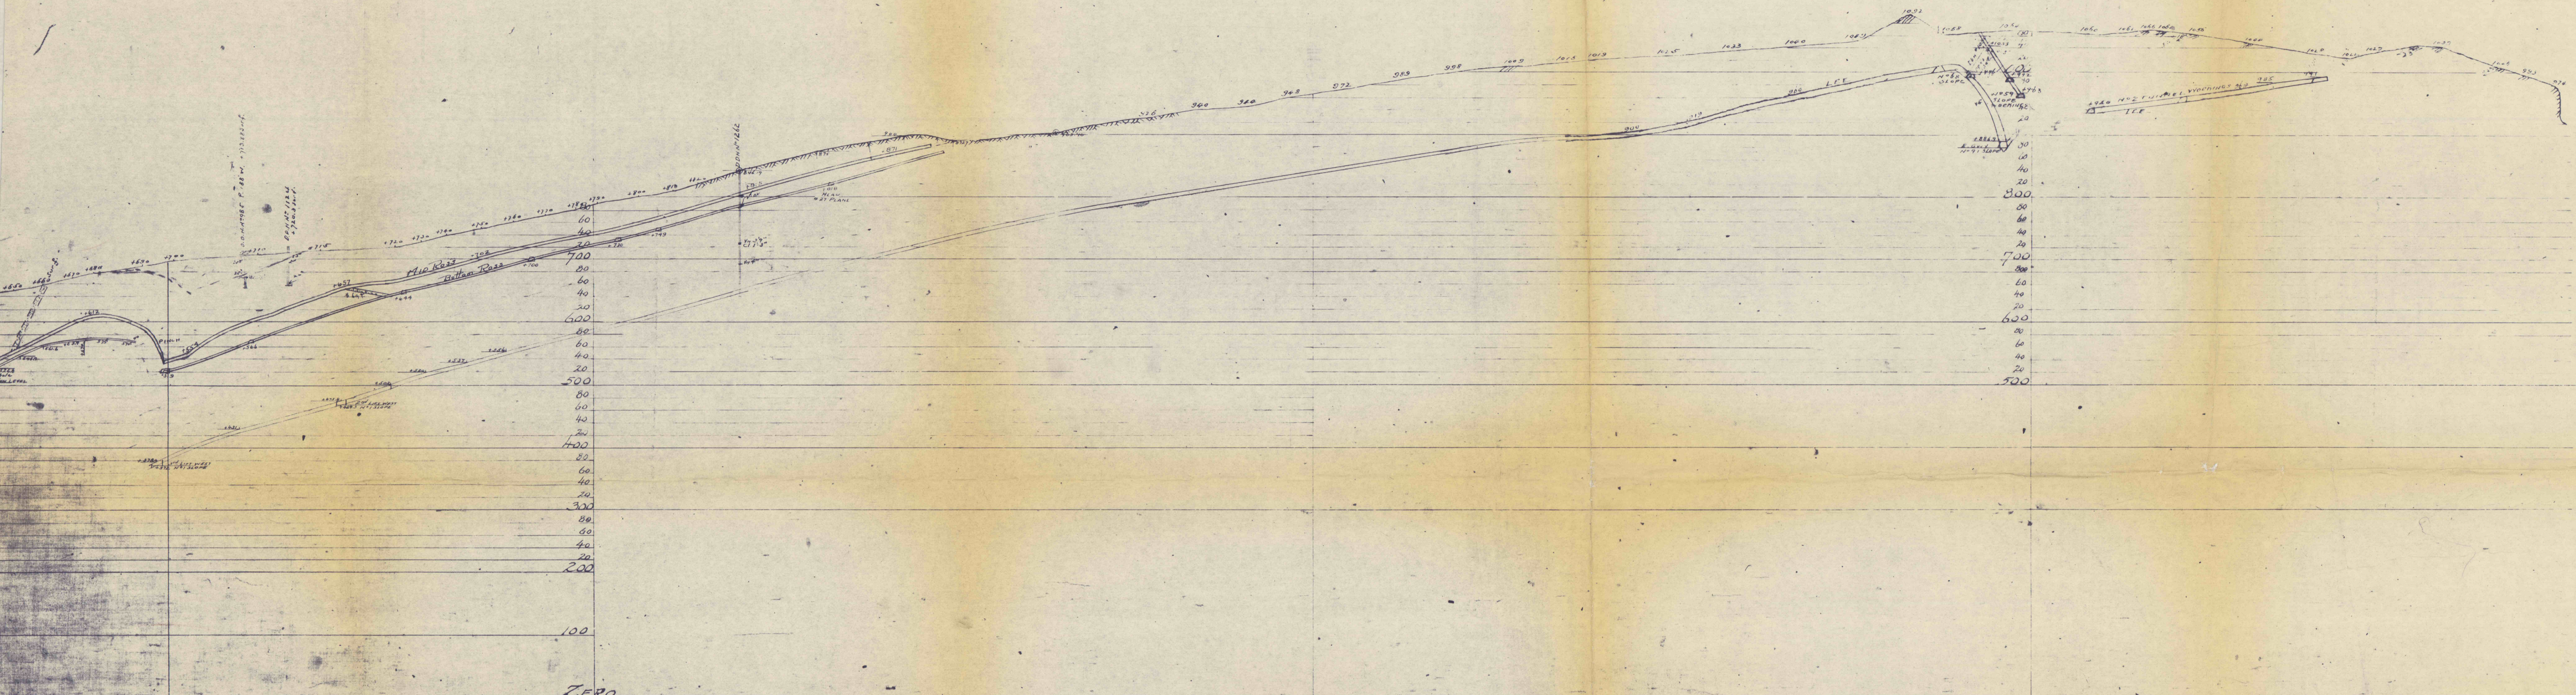

ZERO

ZERO

Scale  
5000

Scale  
5000

Scale  
5000

Scale  
5000