℄ 49

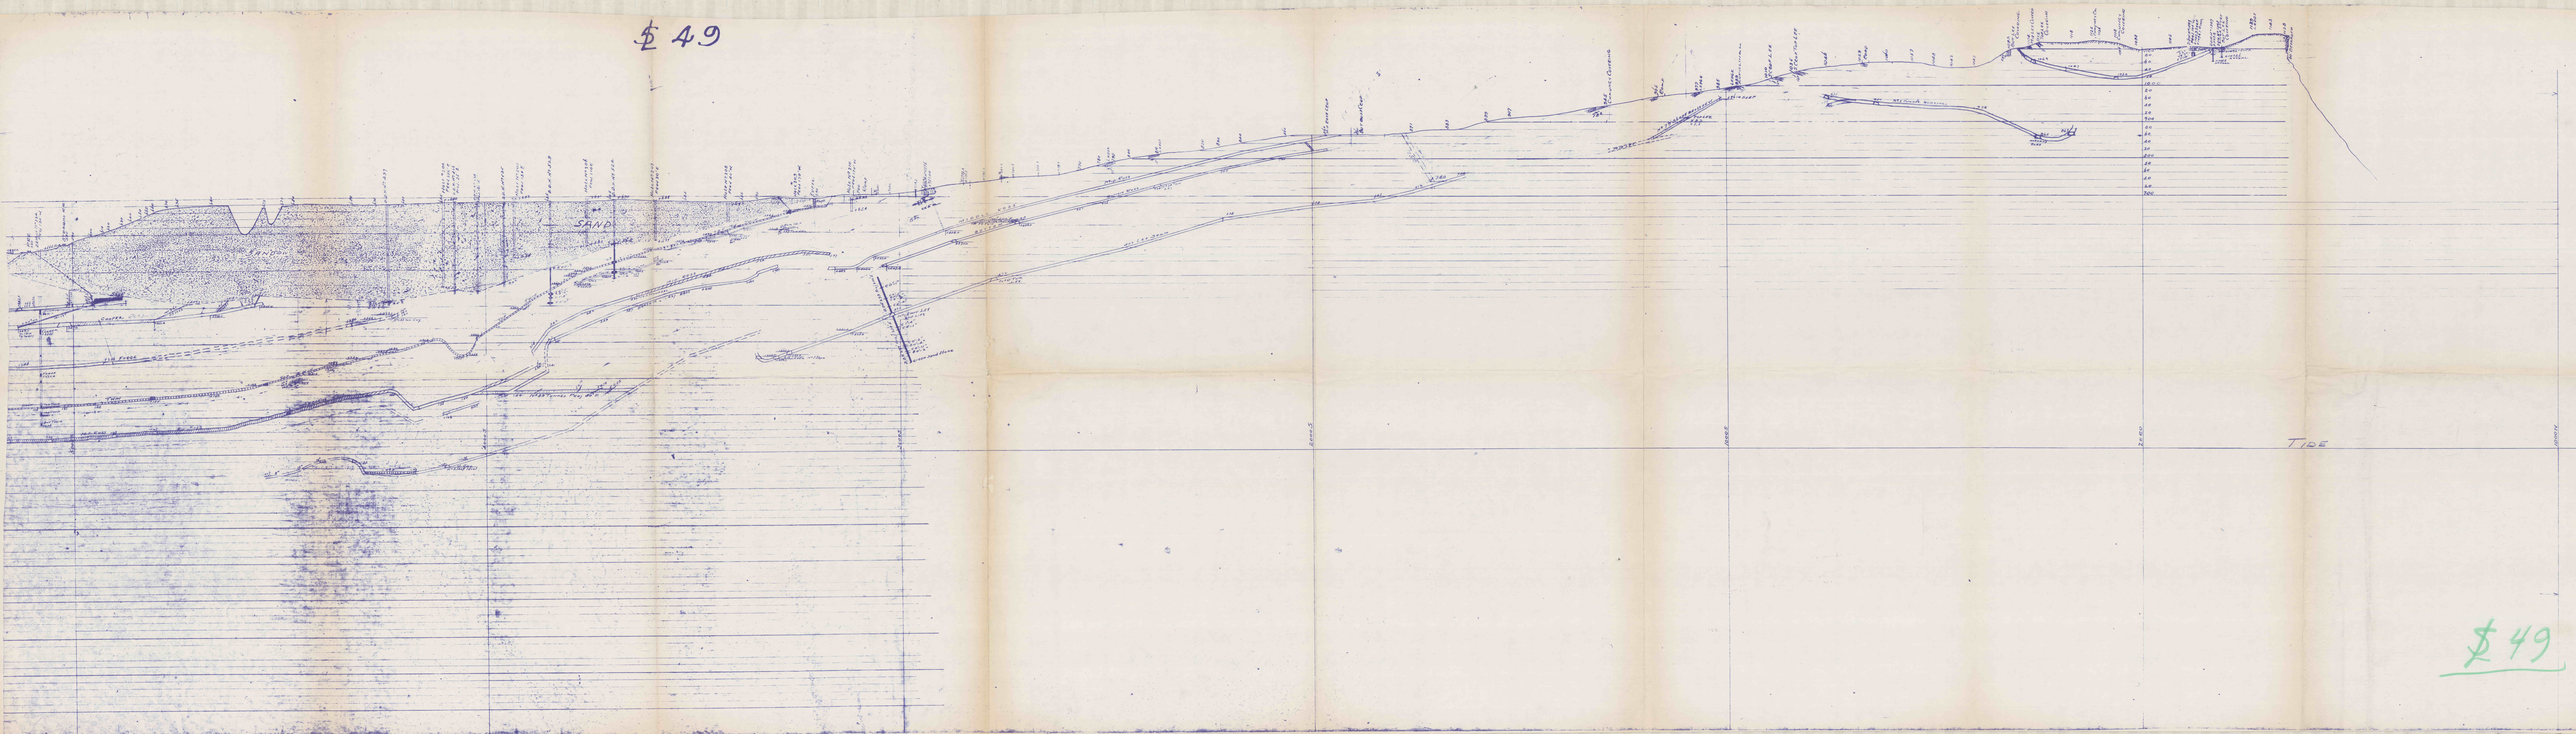

℄ 49