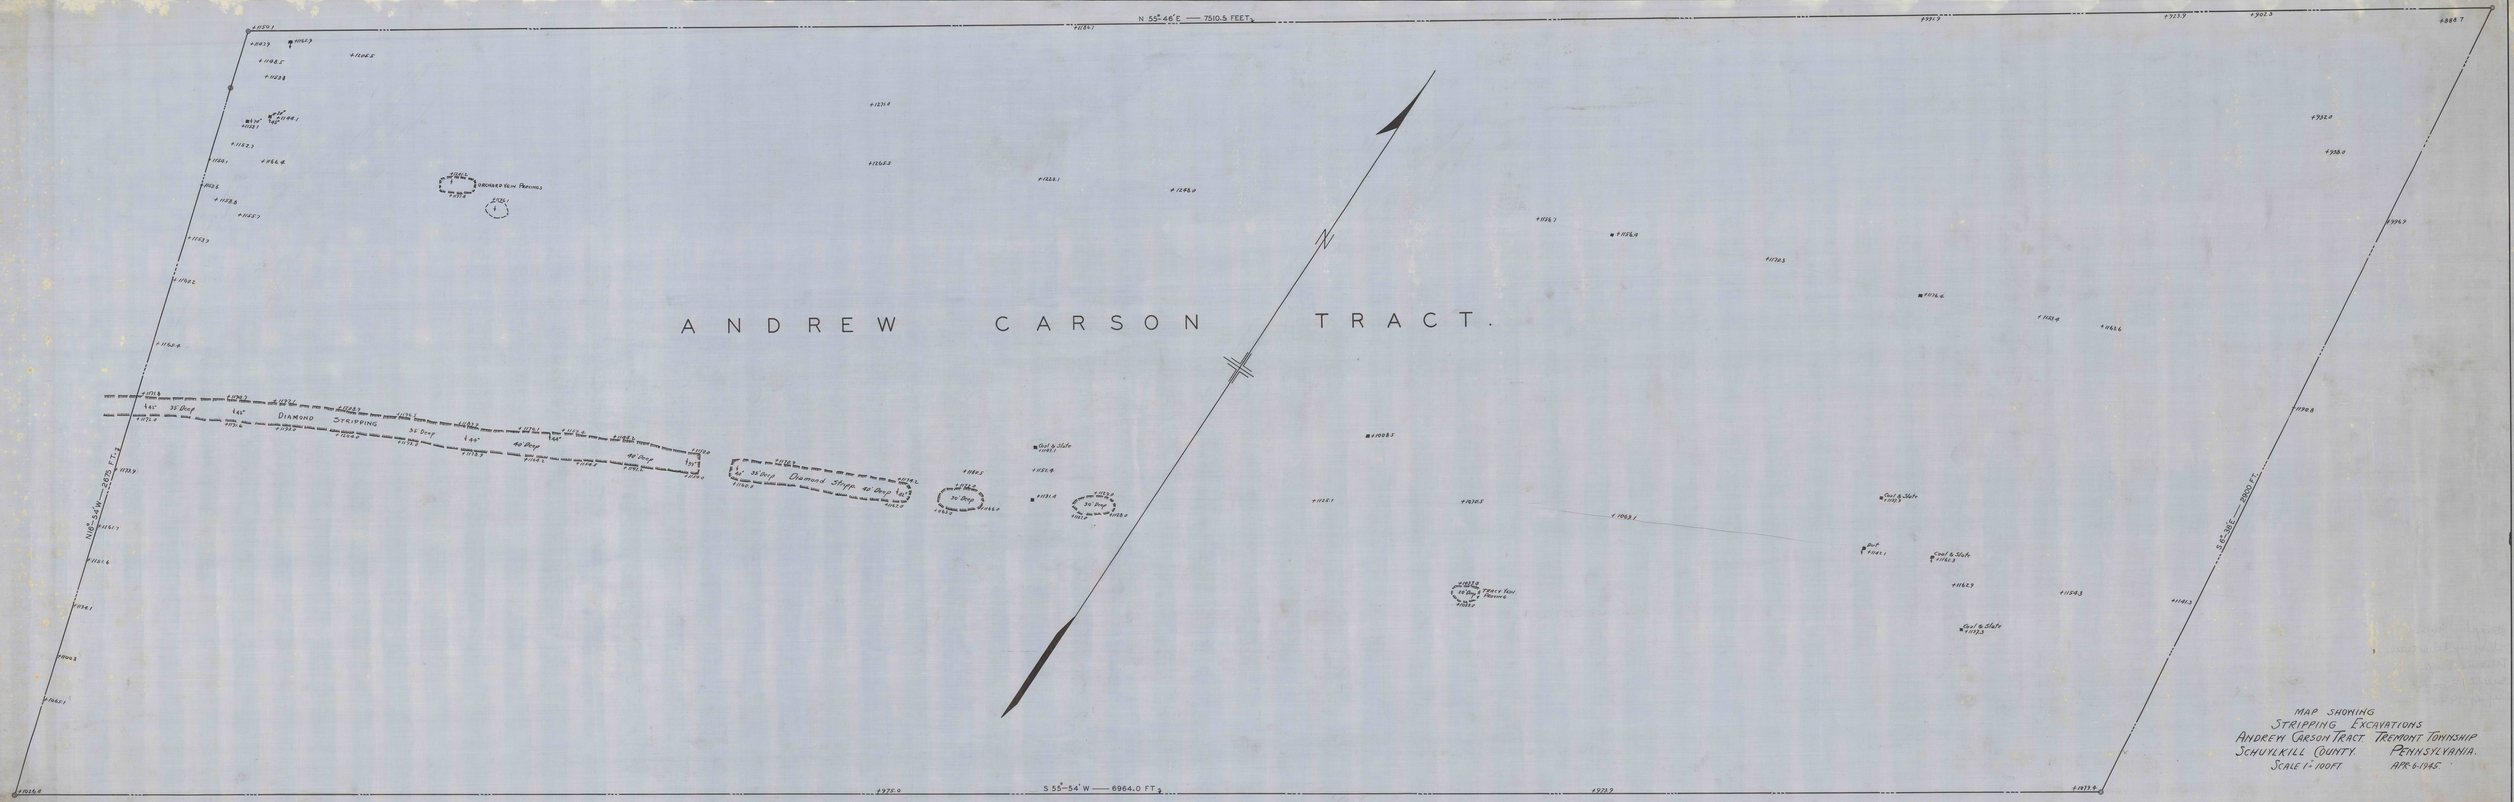
N 55°-46' E — 7510.5 FEET
ANDREW CARSON TRACT.
DIAMOND STRIPPING
35' Deep
40' Deep
Diamond Strip
Coal & Slate
Trace Vein Plasma
S 55°-54' W — 6964.0 FT.
N 16°-54' W — 2675 FT.
S 6°-38' E — 7900 FT.
MAP SHOWING
STRIPPING EXCAVATIONS
ANDREW CARSON TRACT. TREMONT TOWNSHIP
SCHUYLKILL COUNTY. PENNSYLVANIA.
SCALE 1" = 100 FT.
APR-6-1945.