


JONATHAN COAL MINING Co.
 UNION TOWNSHIP
 LEBANON Co PA.

Scale 1" = 100.0
 DATE Aug 1, 1949.

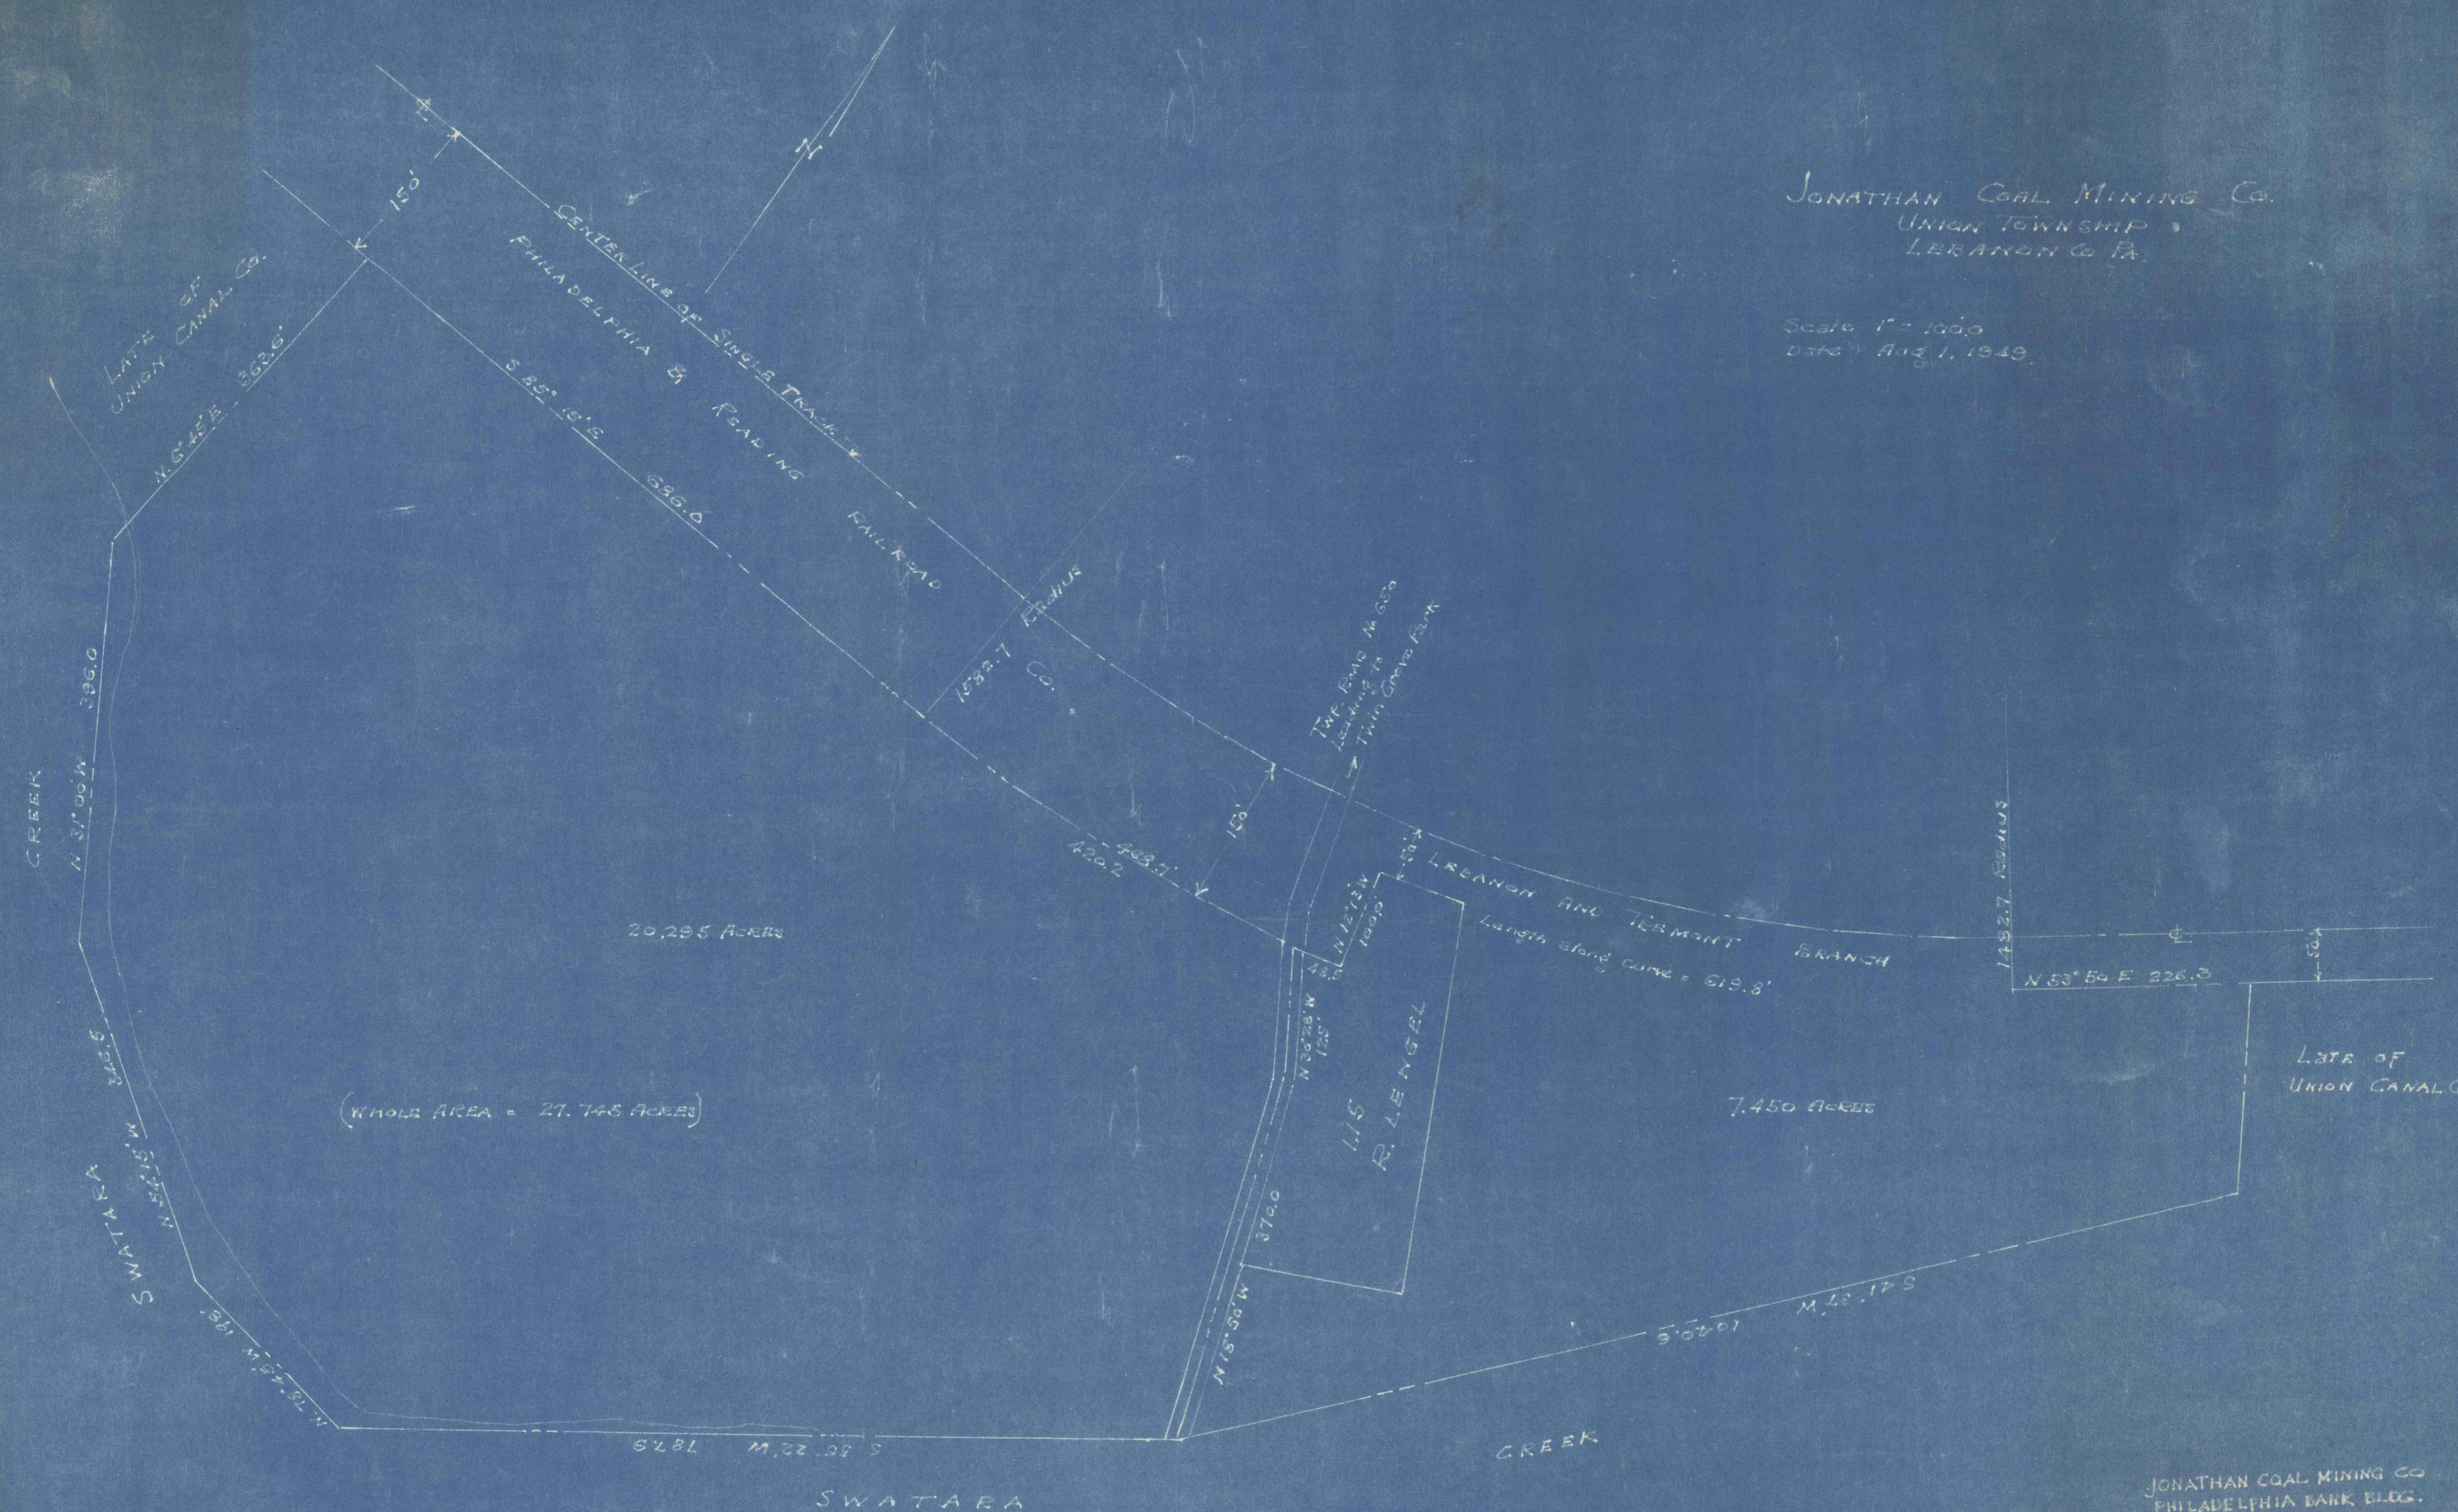

JONATHAN COAL MINING CO
 PHILADELPHIA BANK BLDG.
 PHILADELPHIA, PA.

Traced July 23, 1954. E.M. FOTHERMEL
 Surveyor Lebanon Co