


Draft For Lots in Misc. Box #3
Nos. 156 & 157 - Pt. Carroll Land - Newbold's Addn.

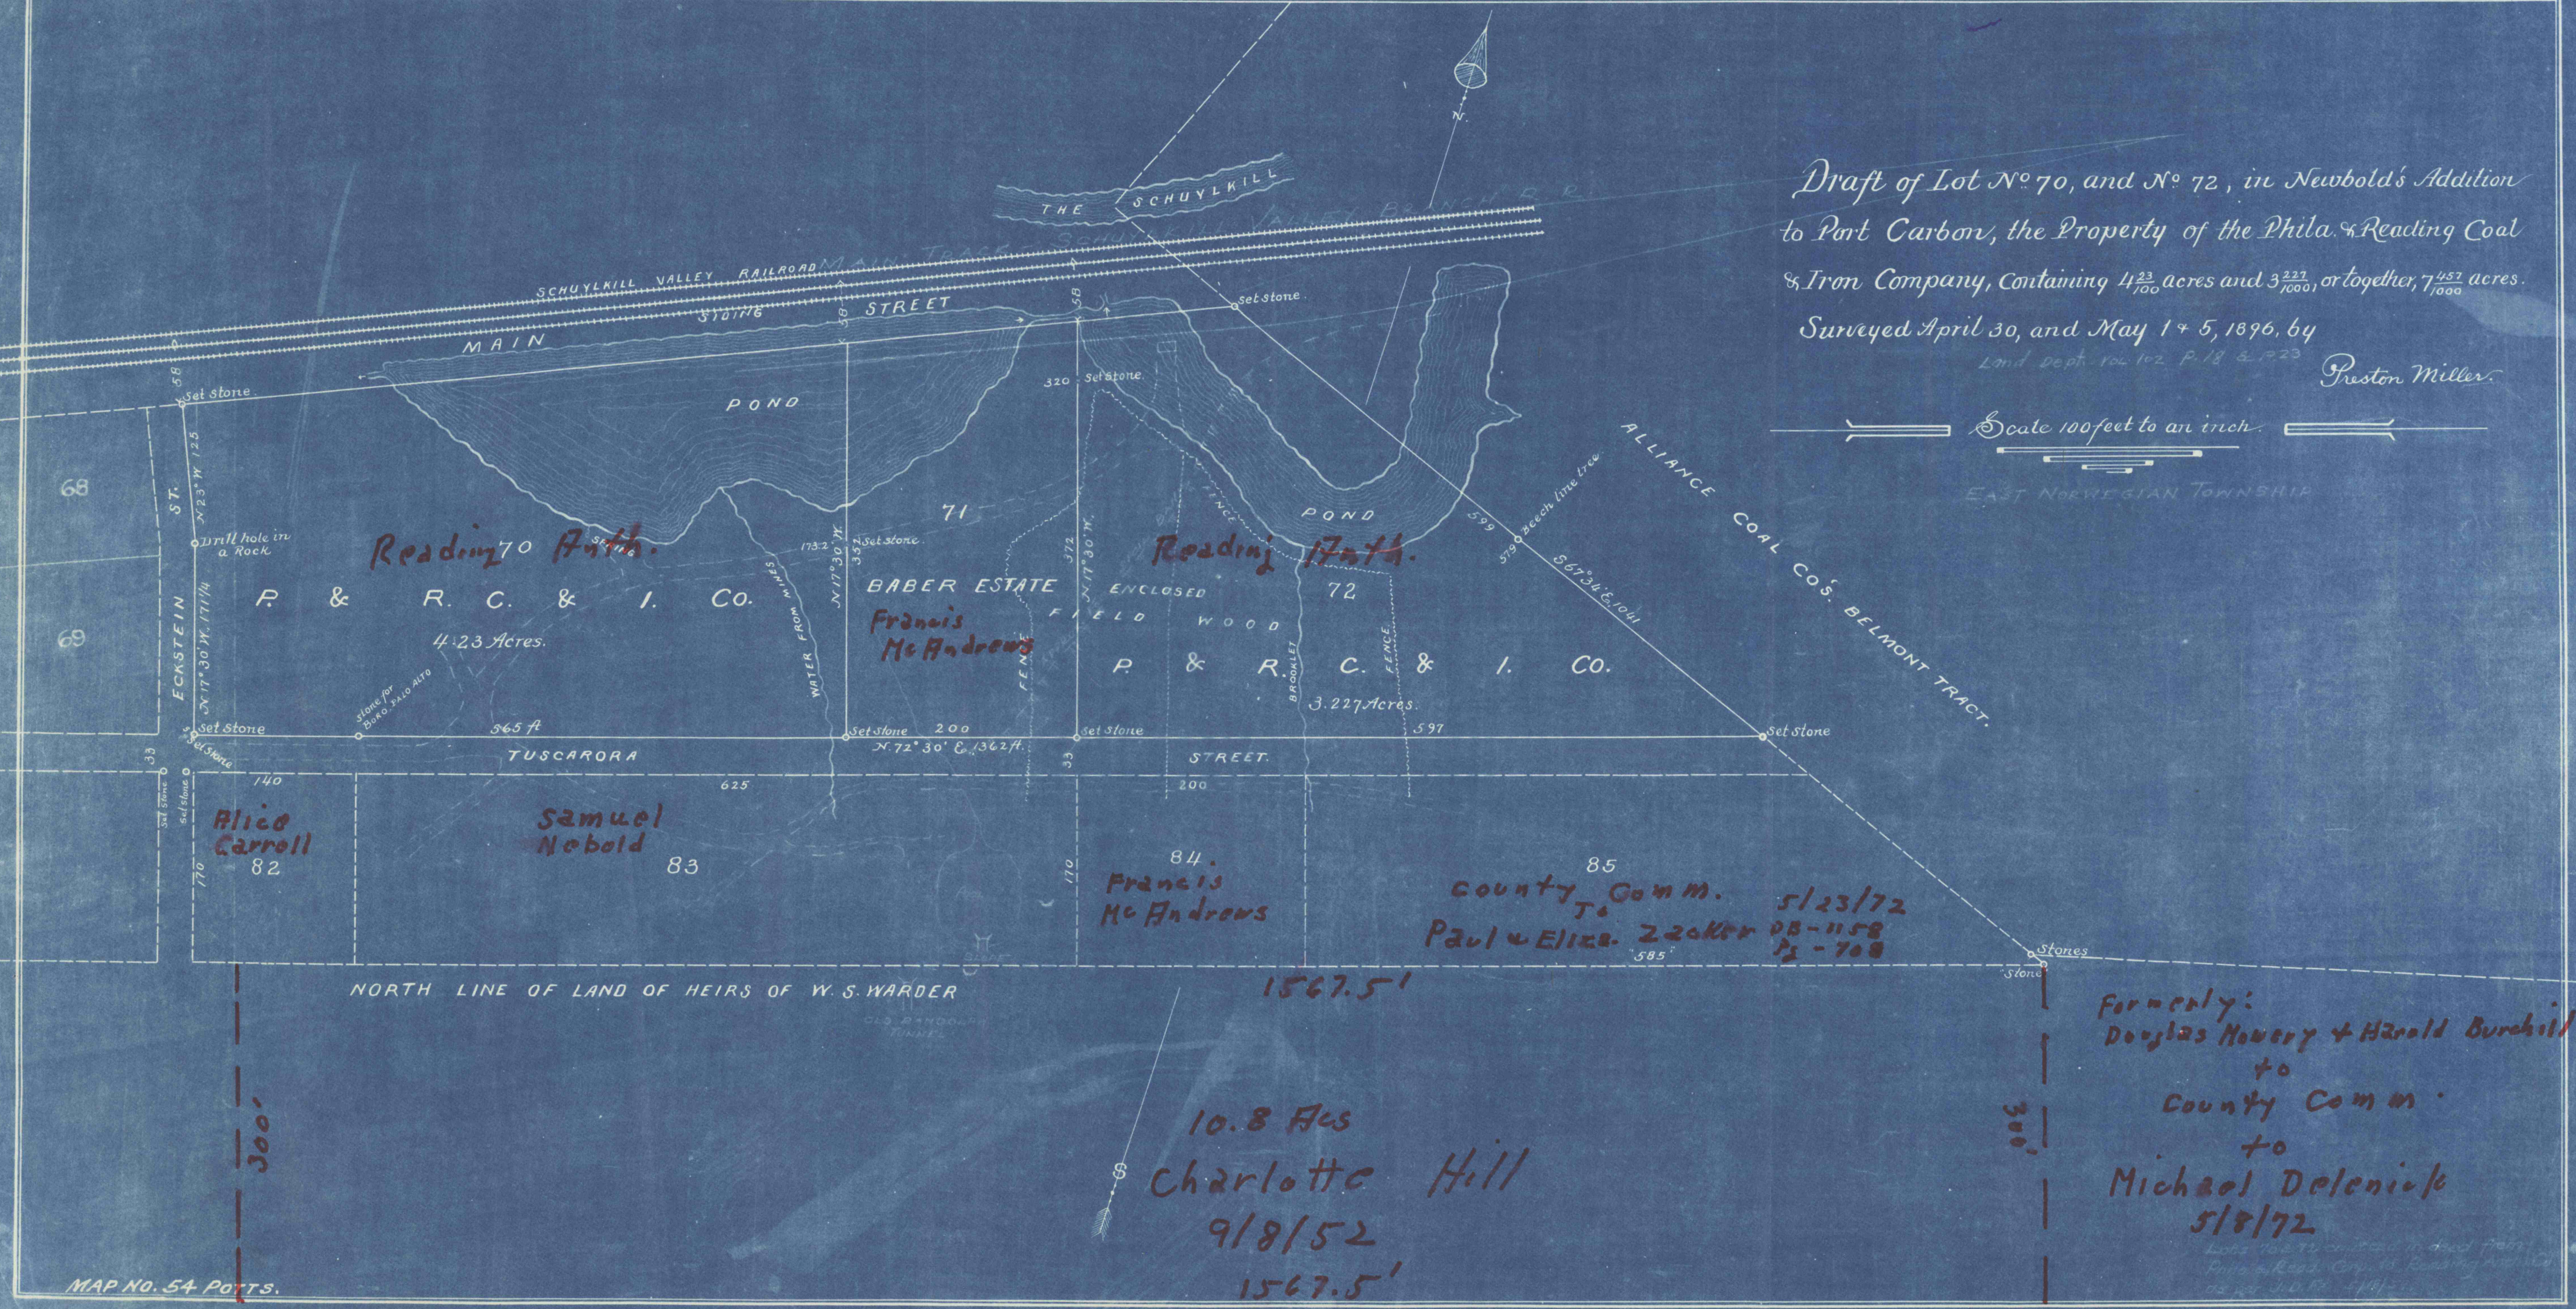

Draft of Lot No 70, and No 72, in Newbold's Addition
to Port Carbon, the Property of the Phila. & Reading Coal
& Iron Company, Containing $4\frac{23}{100}$ acres and $3\frac{227}{1000}$, or together, $7\frac{457}{1000}$ acres.
Surveyed April 30, and May 1 & 5, 1896, by
Lind Depp. vol. 102 P. 18 & P. 23
Preston Miller.

Scale 100 feet to an inch.
EAST NORWEGIAN TOWNSHIP

Reading 70 Acre.
P. & R. C. & I. CO.
4.23 Acres.

Reading 17 Acre.
P. & R. C. & I. CO.
3.227 Acres.

BABER ESTATE
Francis McAndrews

Alice Carroll
82

Samuel Newbold
83

Francis McAndrews
84

County Comm. 5/23/72
Paul & Eliza Zacker PB-1158
72-709

10.8 Acs
Charlotte Hill
9/8/52
1567.5'

Formerly:
Douglas Mowery & Harold Burchill
to
County Comm.
to
Michael Delenick
5/8/72