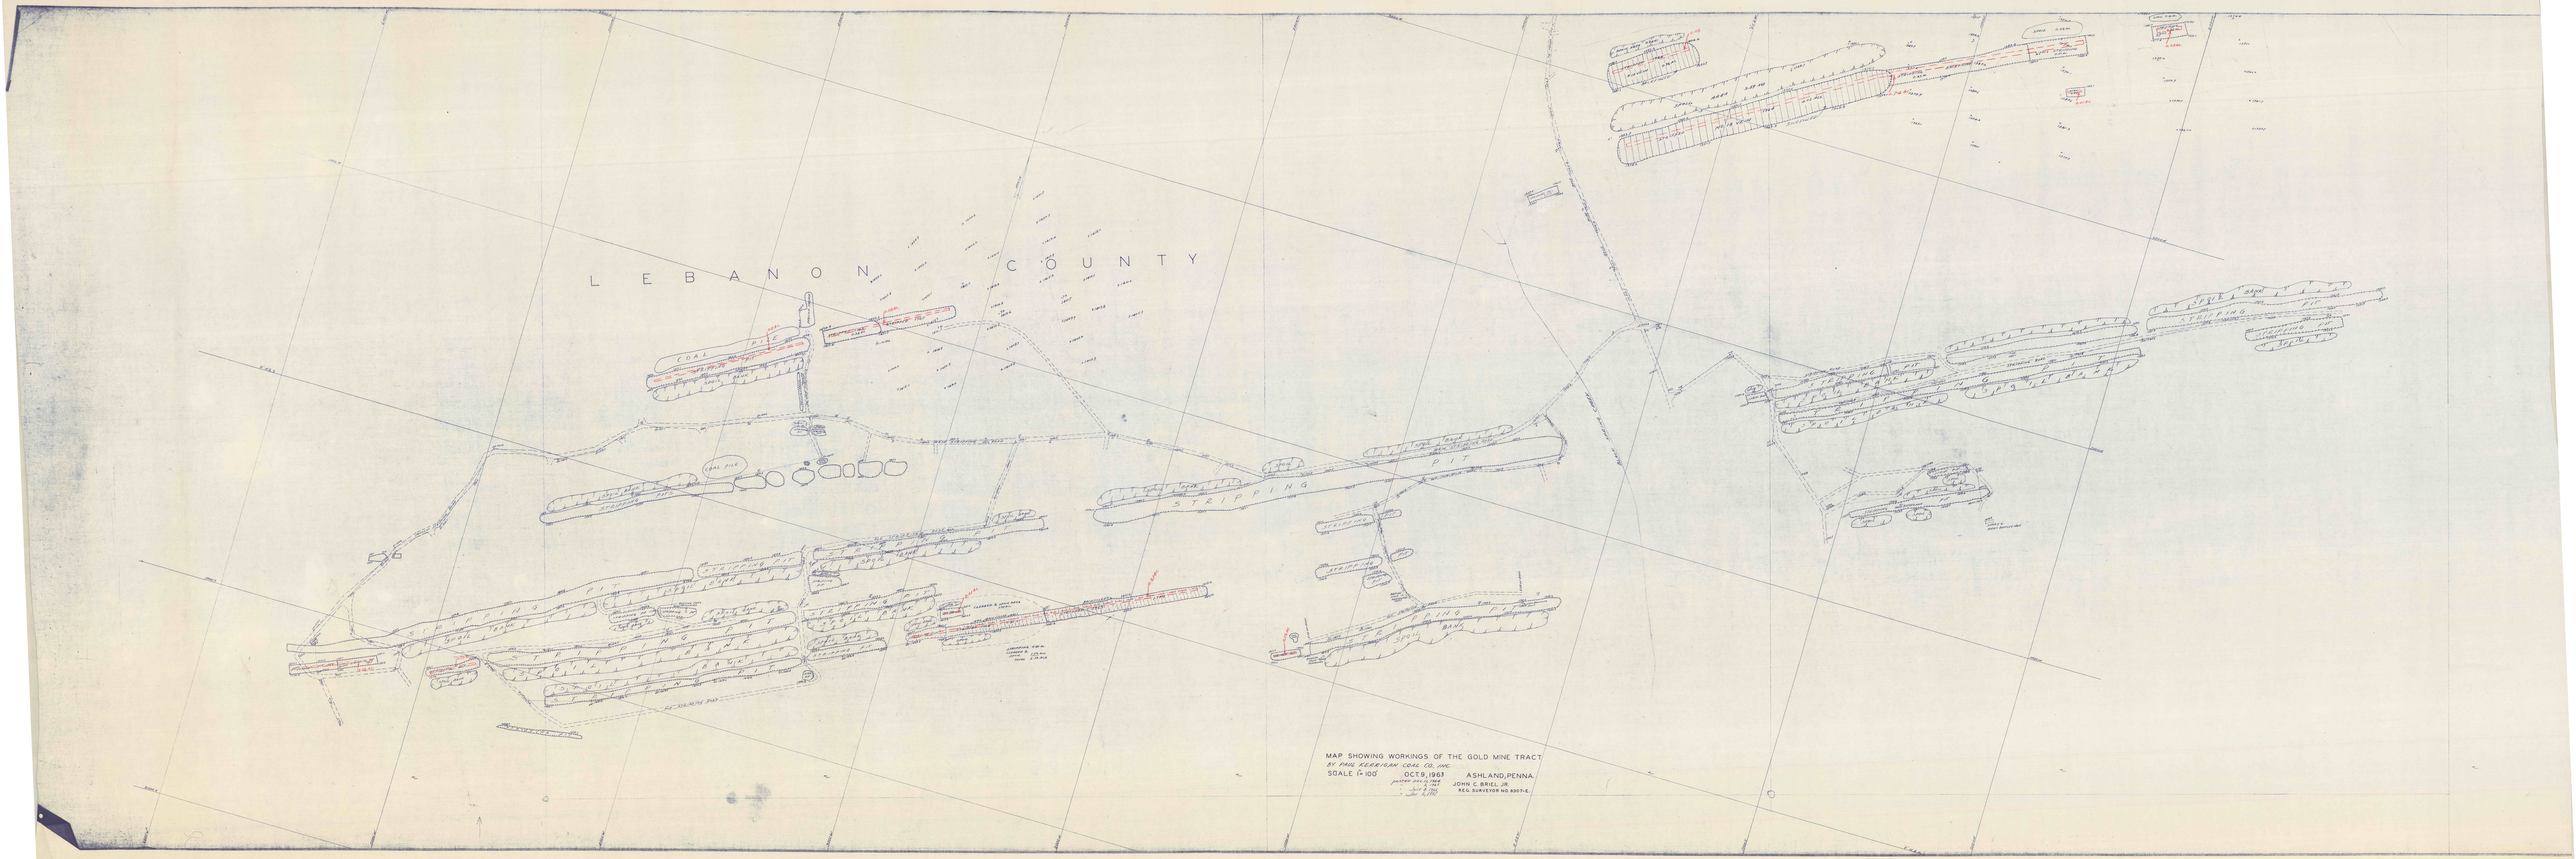
LEBANON COUNTY
COAL PIT
COAL PILE
STRIPPING PIT
SPOIL BANK
MAP SHOWING WORKINGS OF THE GOLD MINE TRACT
SCALE 1" = 100'
OCT. 9, 1963
ASHLAND, PENNA.
JOHN C. BREEL JR.
REG. SURVEYOR NO. 6307-E