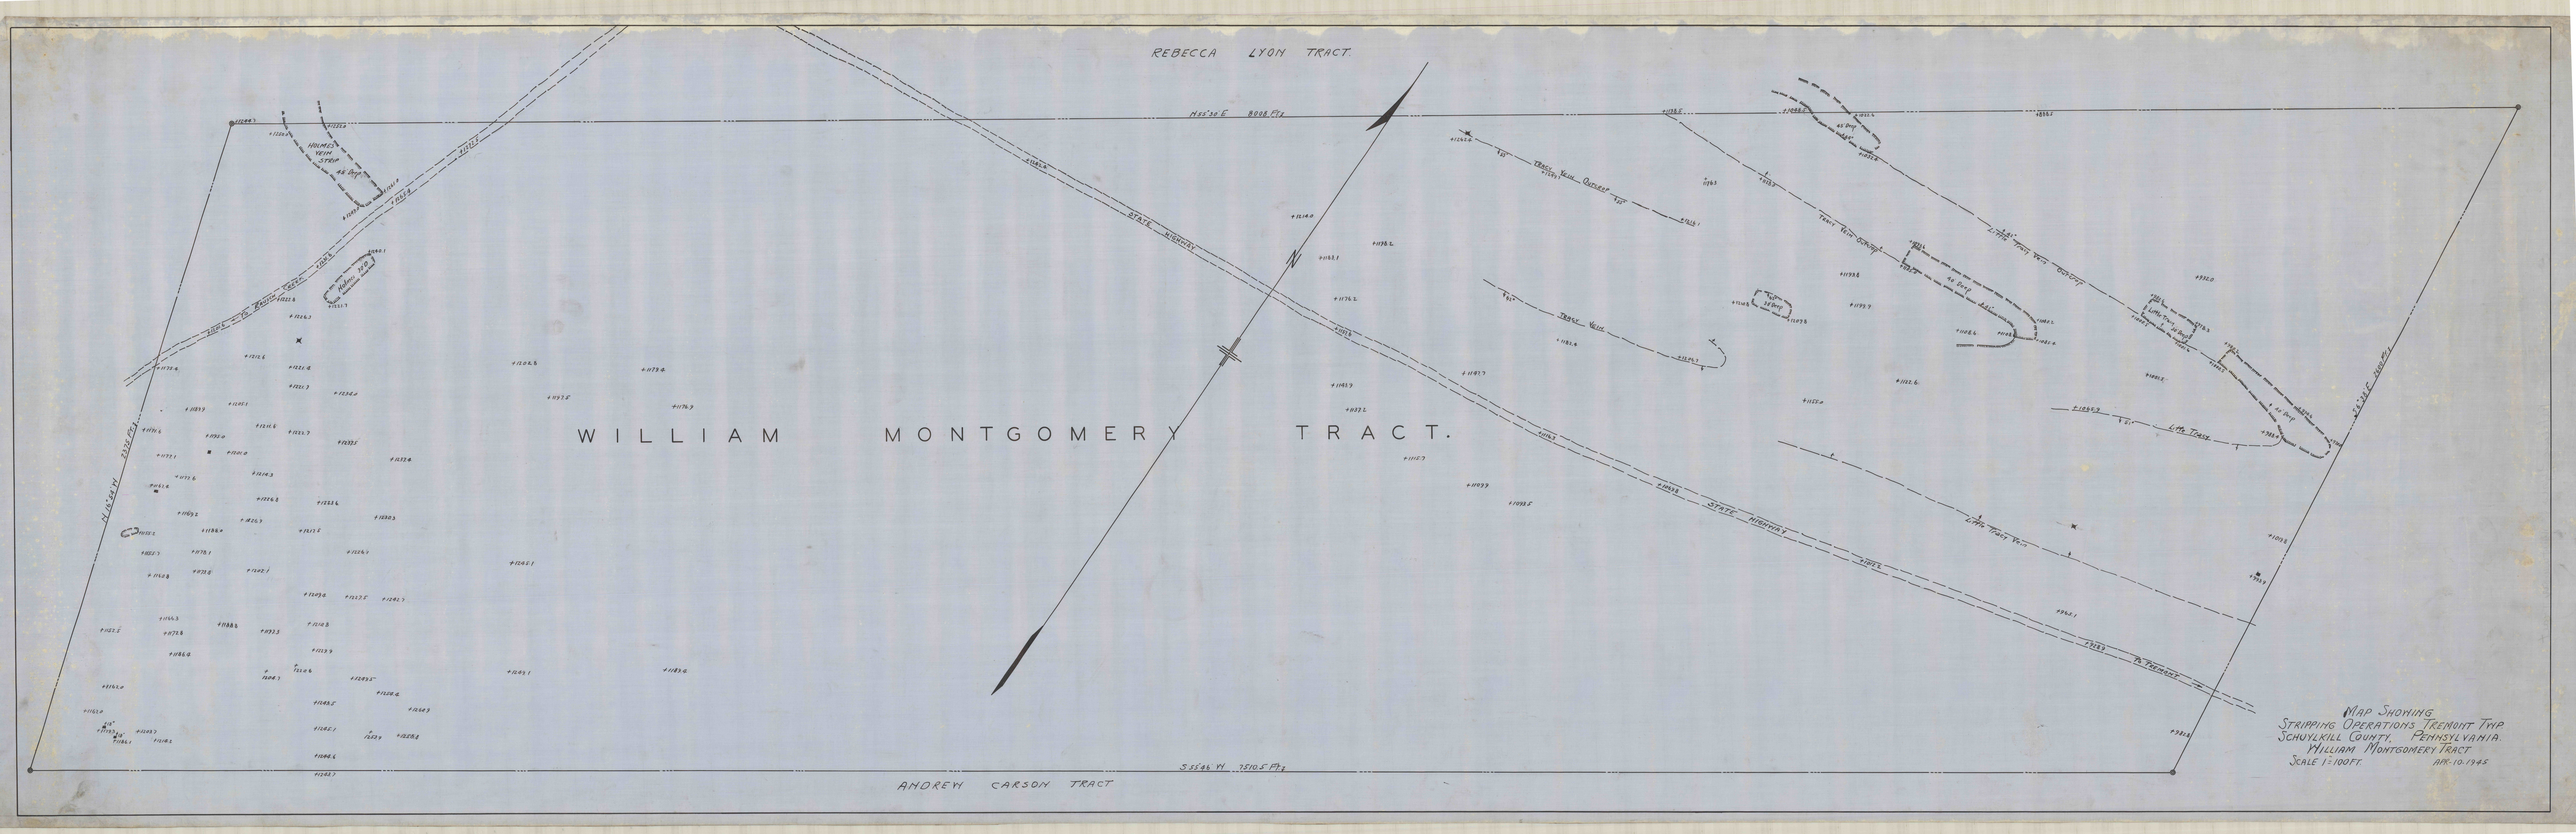

Map Showing
Stripping Operations Tremont Twp
Schuylkill County, Pennsylvania
William Montgomery Tract
Scale 1"=100 Ft. Apr. 10. 1945.