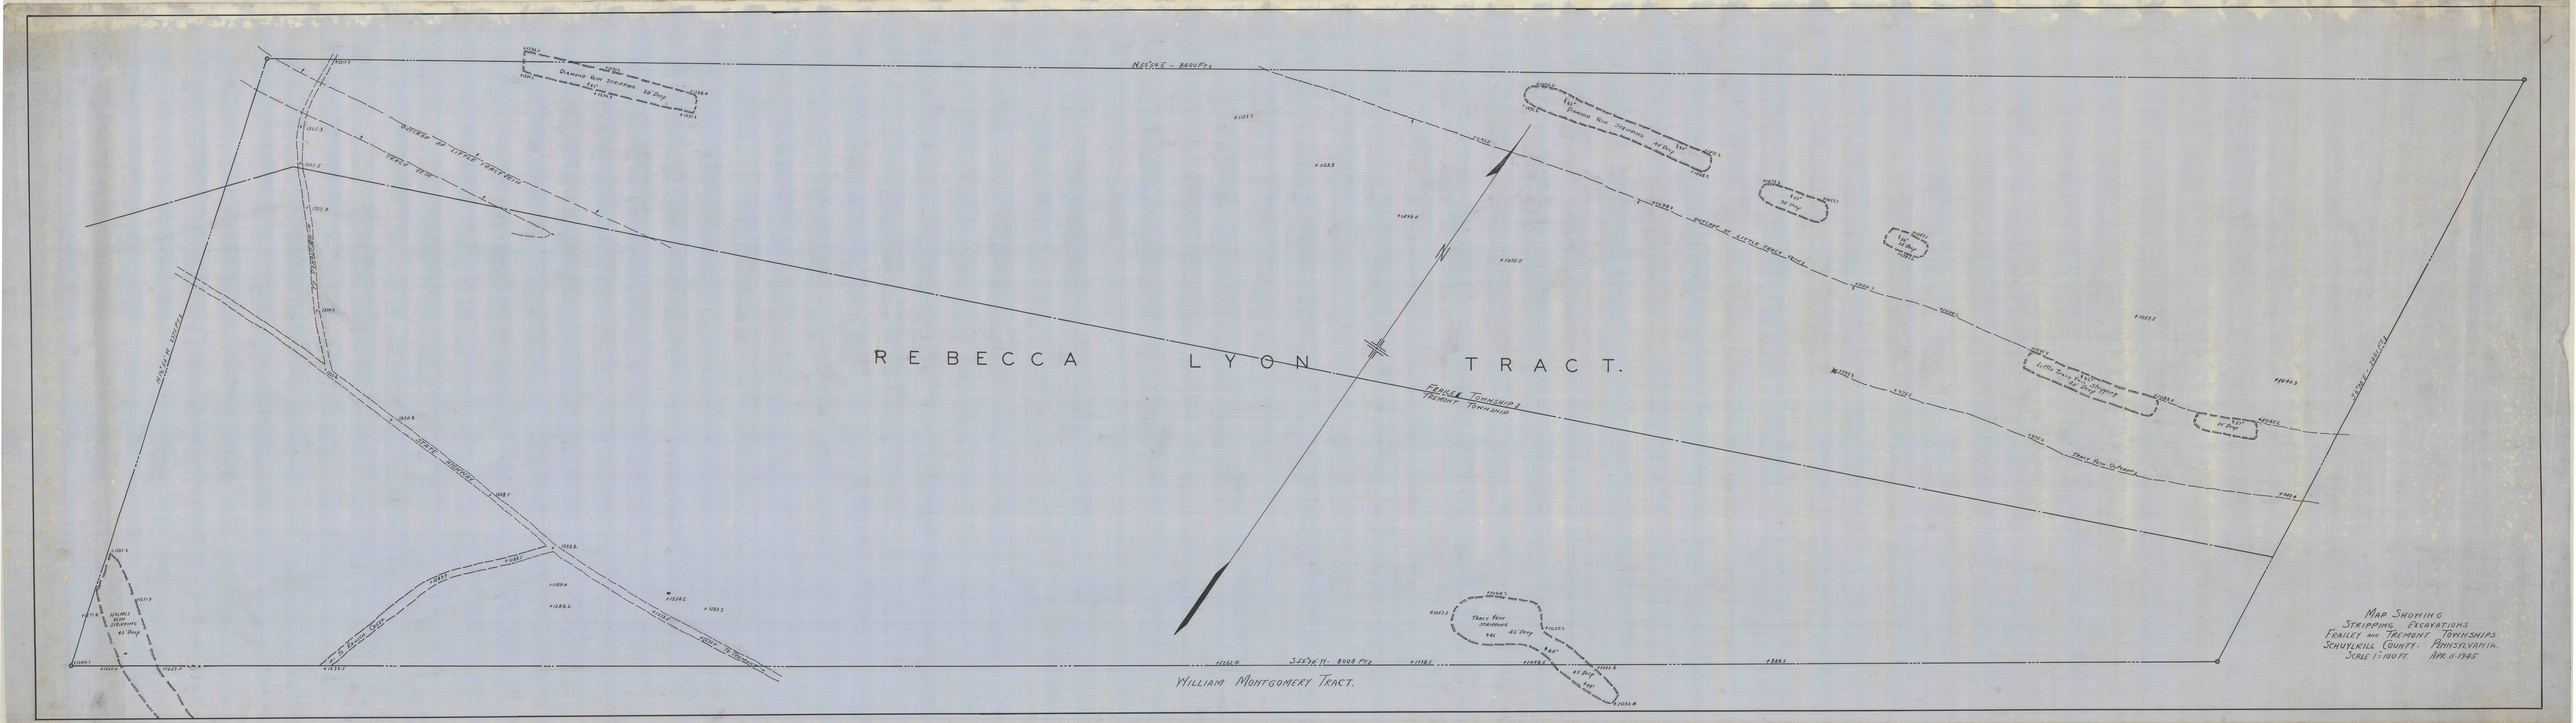
REBECCA LYON TRACT.
N 65°30'E - 8400 Ft.
S 25°30'W - 8008 Ft.
FRAILEY TOWNSHIP
TREMONT TOWNSHIP
WILLIAM MONTGOMERY TRACT.
Little Tracy Run Stripping 30' Deep
Tracy Run Stripping 45' Deep
