


DAUPHIN

COUNTY

NORTH

To Goldmine Road

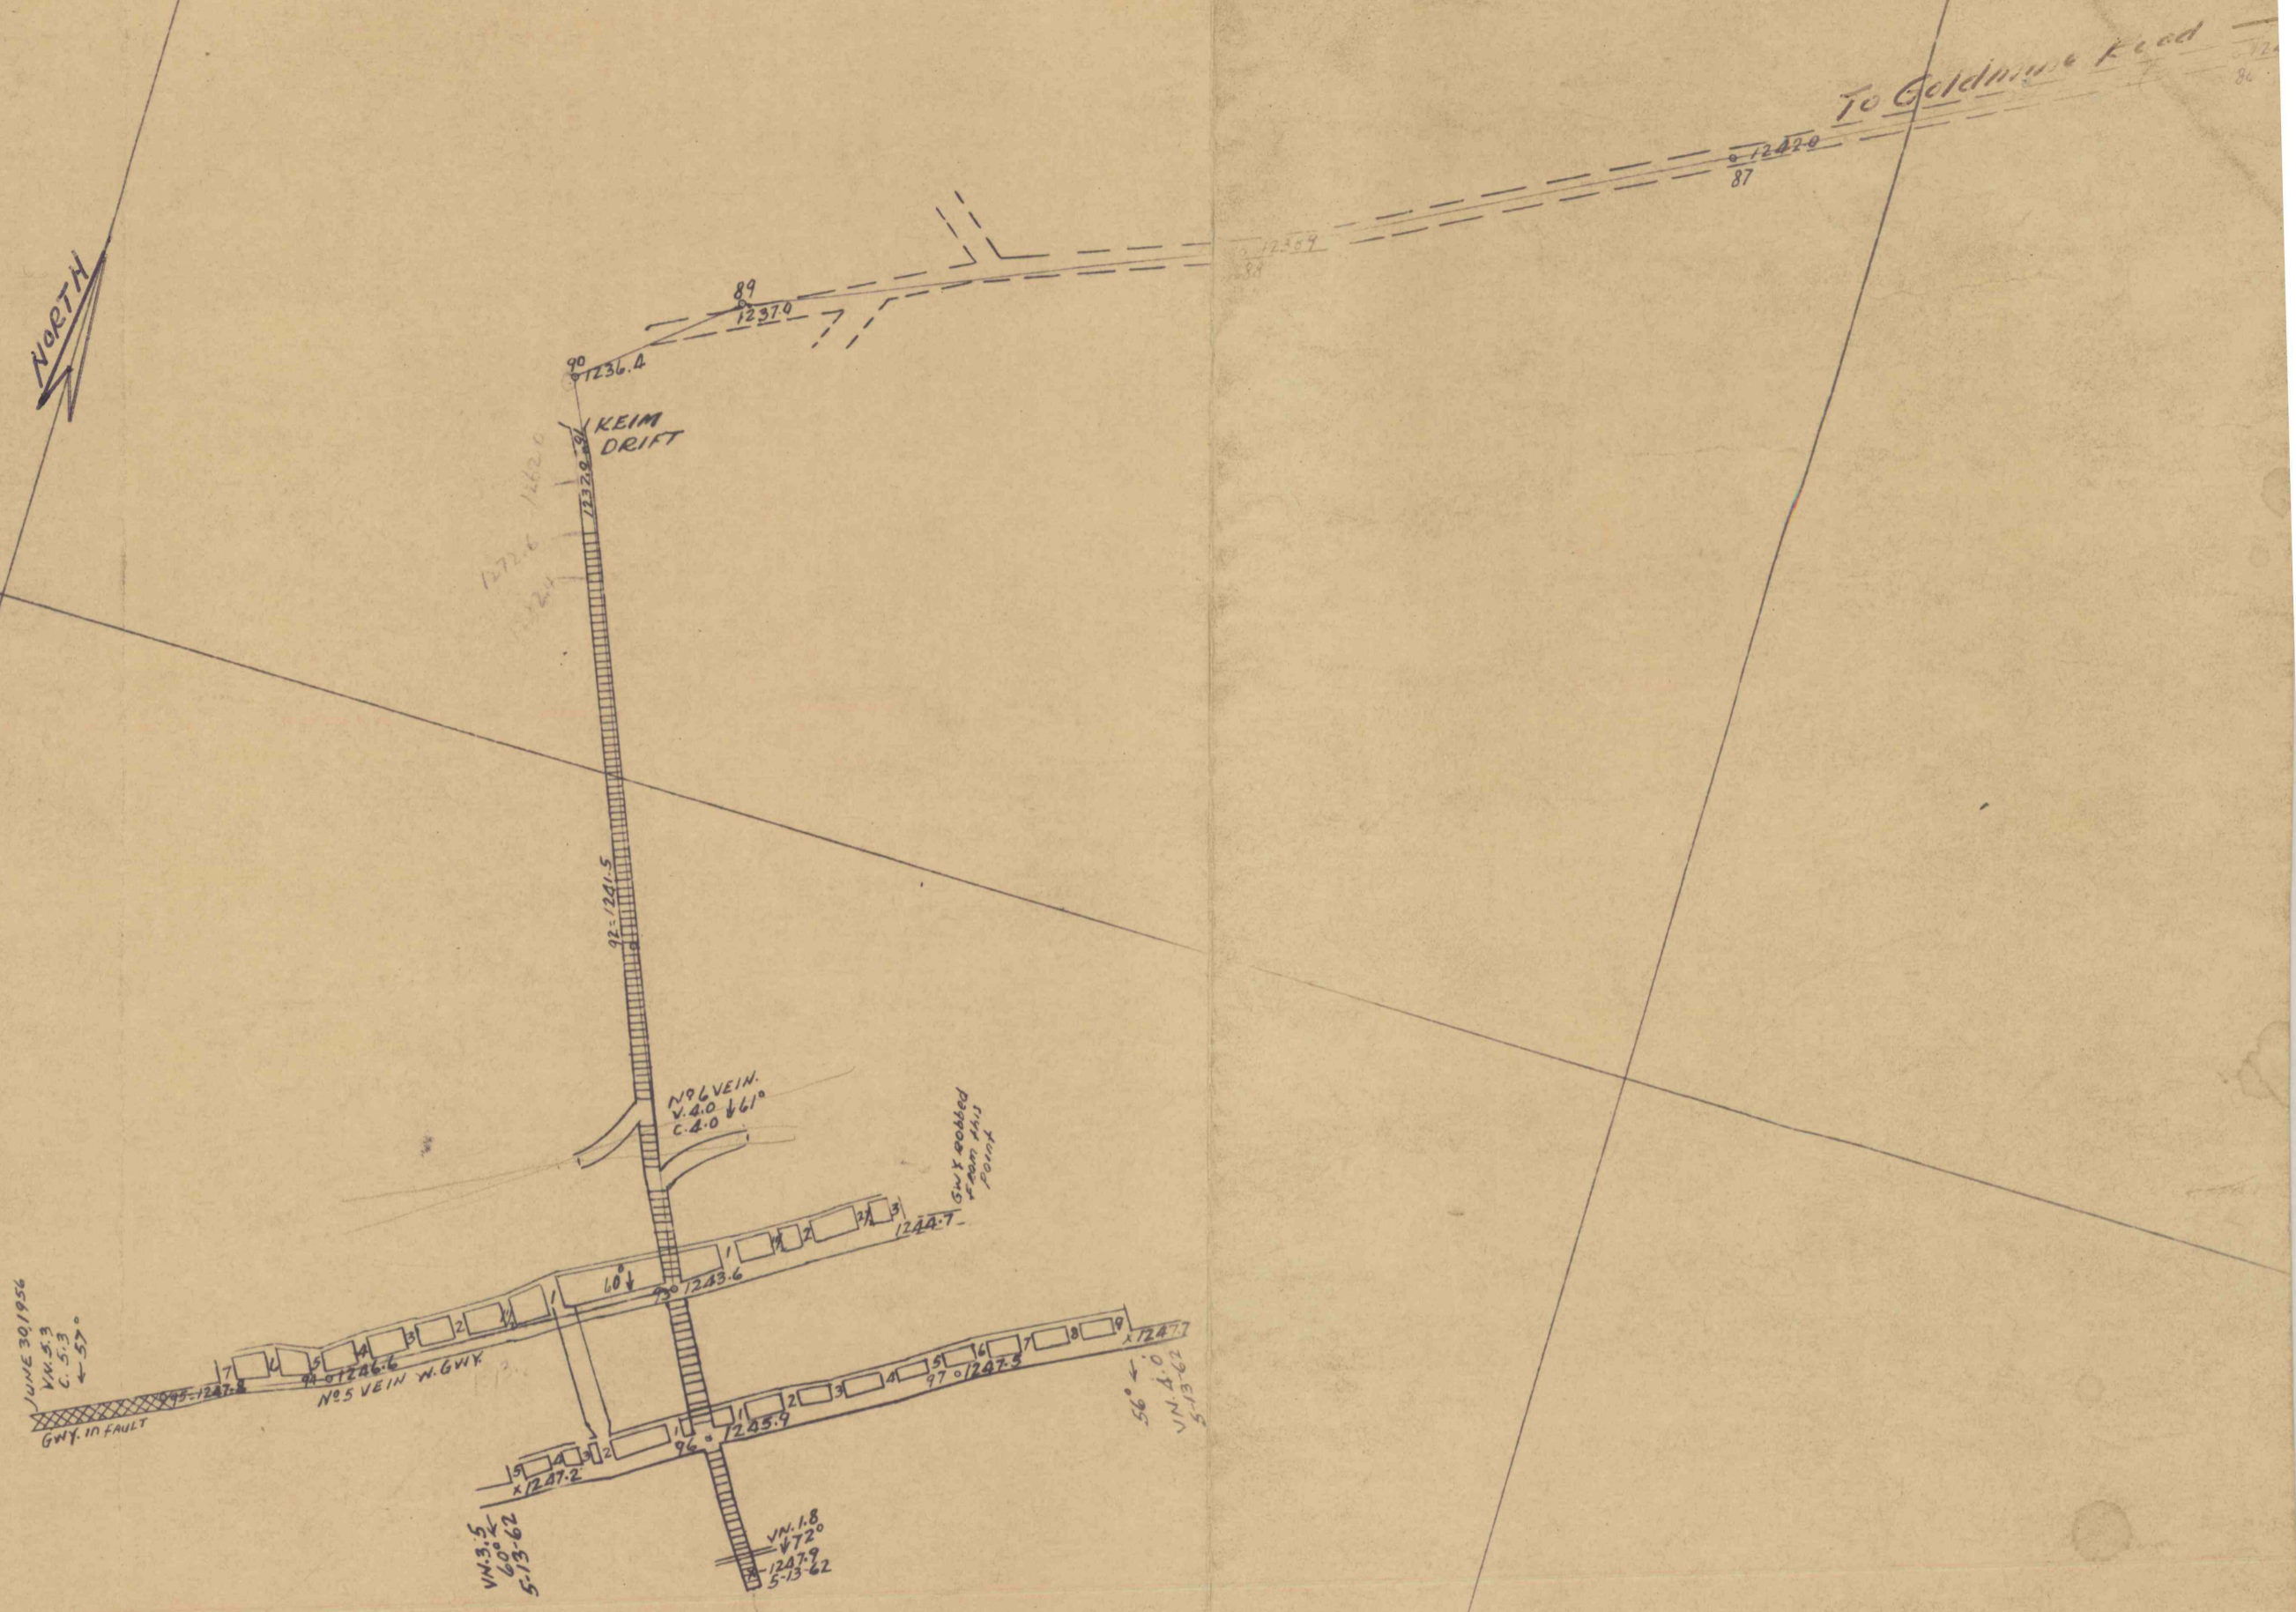



5-13-62

from this  
point

Scale 1"=100' John C. Briell  
Reg. Surv. N. 6307-E