


Lines Tinted Same Color As Names of Claimants

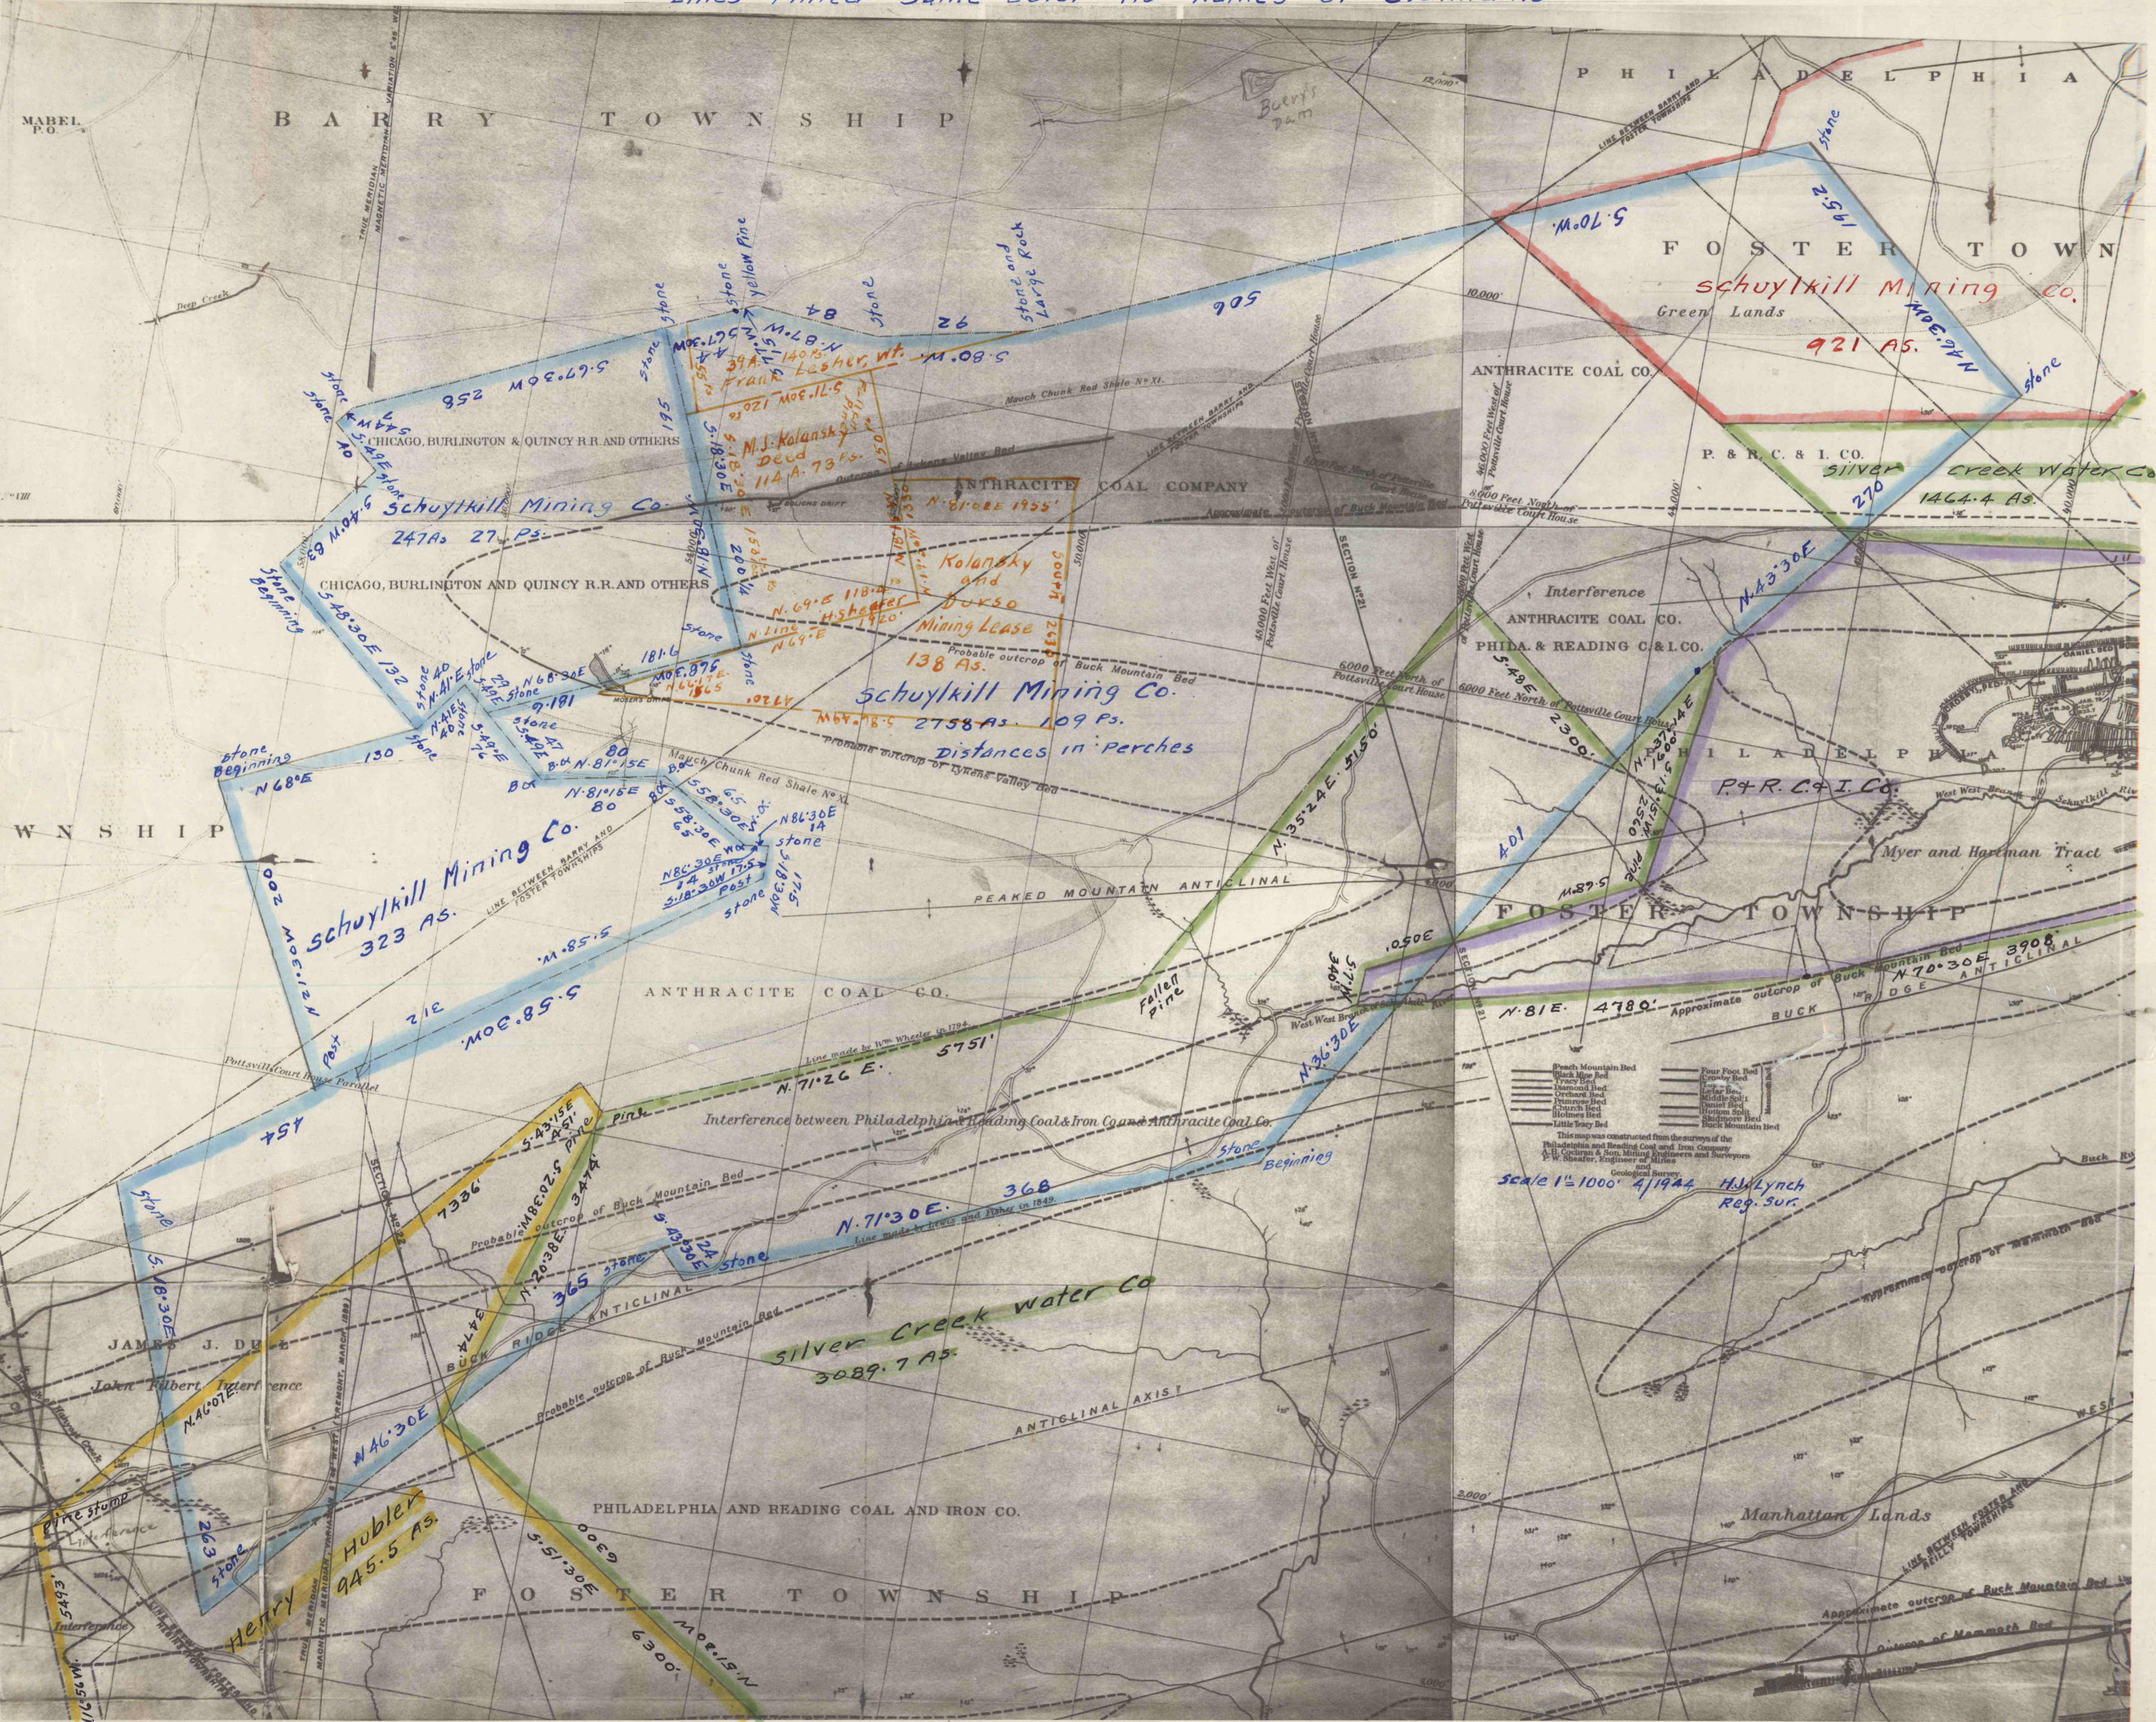

MABEL P.O.

BARRY TOWNSHIP

PHILADELPHIA

FOSTER TOWNSHIP

Schuylkill Mining Co.

Green Lands

921 AS.

ANTHRACITE COAL CO.

P. & R. C. & I. CO.

Silver Creek Water Co.

1464.4 AS.

Schuylkill Mining Co.


CHICAGO, BURLINGTON AND QUINCY R.R. AND OTHERS

ANTHRACITE COAL COMPANY

Kolansky and Burko Mining Lease

138 AS.

Schuylkill Mining Co.

2758 AS. 109 PS.

Distances in Perches

stone beginning

WNSHIP

Schuylkill Mining Co.

323 AS.

ANTHRACITE COAL CO.

PEAKED MOUNTAIN ANTICLINAL

FOSTER TOWNSHIP

Myer and Hartman Tract

Interference between Philadelphia and Reading Coal and Iron Co. and Anthracite Coal Co.

- Peaked Mountain Bed
- Black Mine Bed
- Tracy Bed
- Diamond Bed
- Ormside Bed
- Prussard Bed
- Church Bed
- Holmes Bed
- Little Tracy Bed
- Four Foot Bed
- Covey Bed
- Leary Bed
- Middle Spill
- Daniel Bed
- Belgian Soil
- Sidmore Bed
- Buck Mountain Bed

scale 1"=1000' 4/1944 H.J. Lynch Reg. Sur.

JAMES J. DEE

John Gilbert Interference

Henry Hubler

945.5 AS.

PHILADELPHIA AND READING COAL AND IRON CO.

FOSTER TOWNSHIP

Manhattan Lands

Approximate outcrop of Buck Mountain Bed

Outcrop of Mammoth Bed