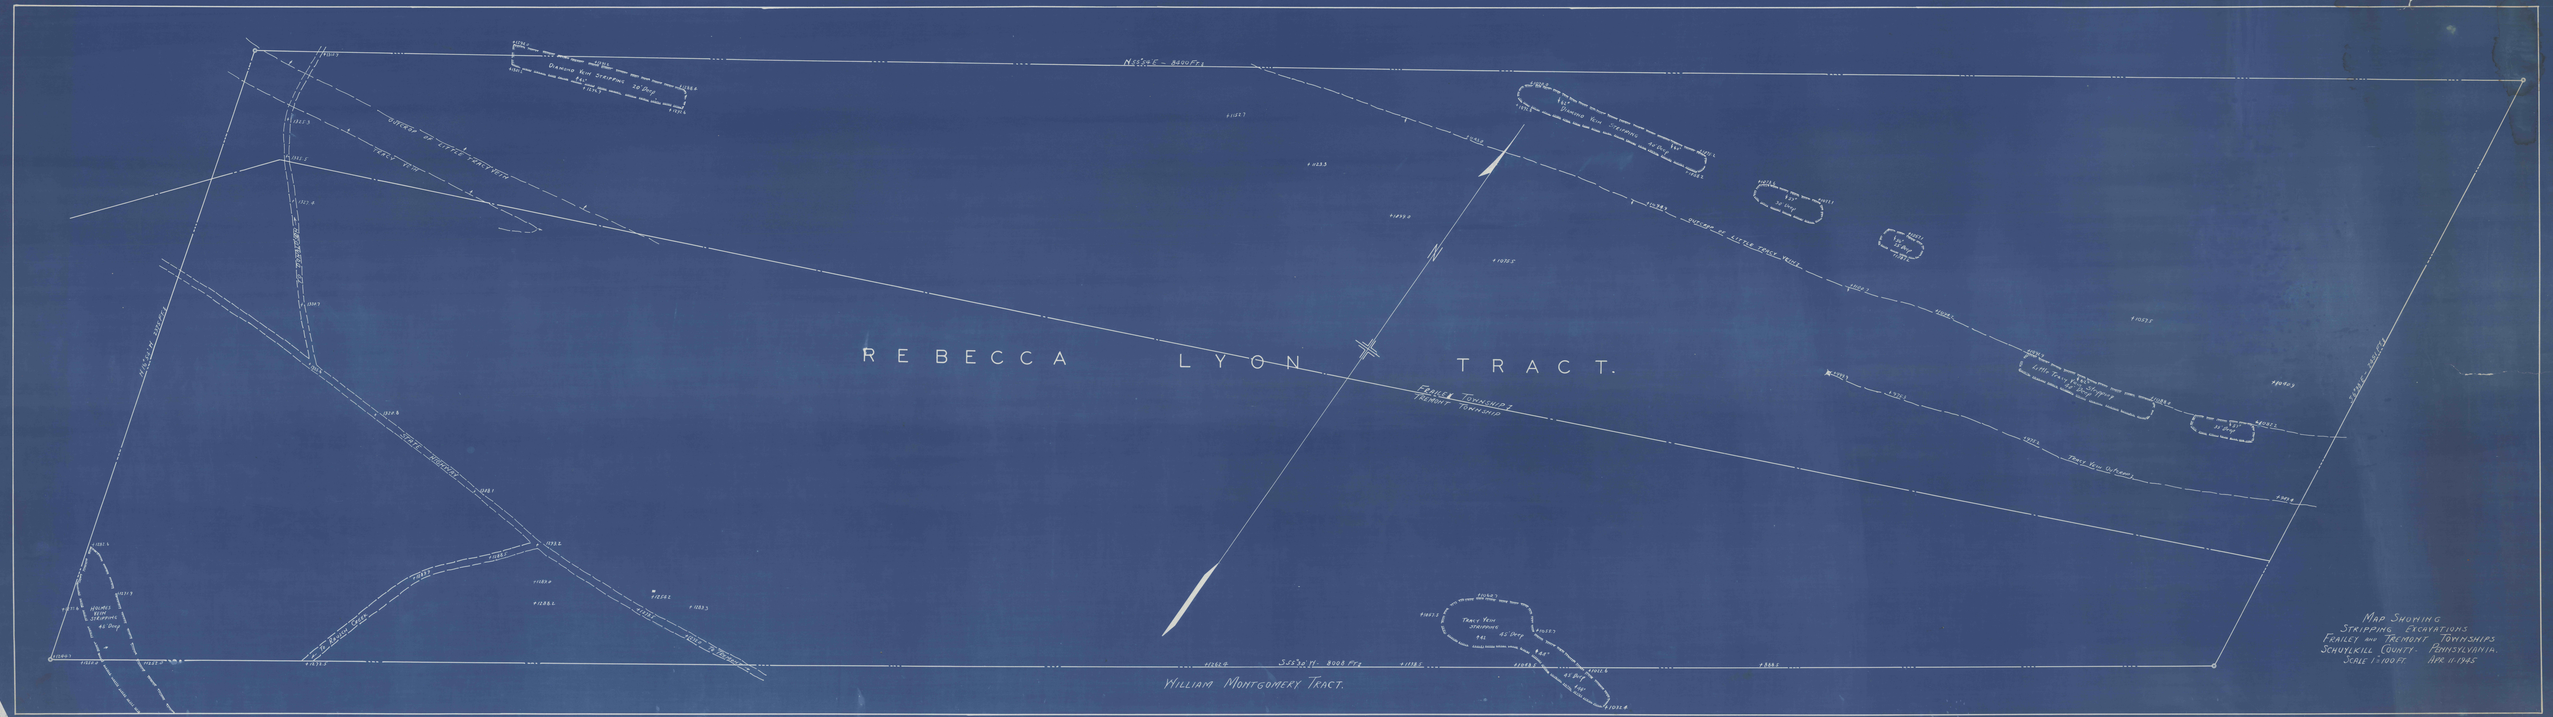
REBECCA LYON TRACT.
FRAILEY TOWNSHIP
TREMONT TOWNSHIP
WILLIAM MONTGOMERY TRACT.
N 85°30'E - 8490 FT.
S 85°30'W - 8008 FT.
N 5°30'E - 8000 FT.
S 5°30'W - 8000 FT.
DIAMOND VEIN STRIPPING 10 Deep
DIAMOND VEIN STRIPPING 40 Deep
TRACY VEIN STRIPPING 40 Deep
HOLMES VEIN STRIPPING 40 Deep
PENN'A R.R.
STATE HIGHWAY
STATE HIGHWAY
TO ASHLAND
TO MT. CARMEL
MAP SHOWING
STRIPPING EXCAVATIONS
FRAILEY AND TREMONT TOWNSHIPS
SCHUYLKILL COUNTY - PENNSYLVANIA.
SCALE 1:100 FT. APR. 11 1945