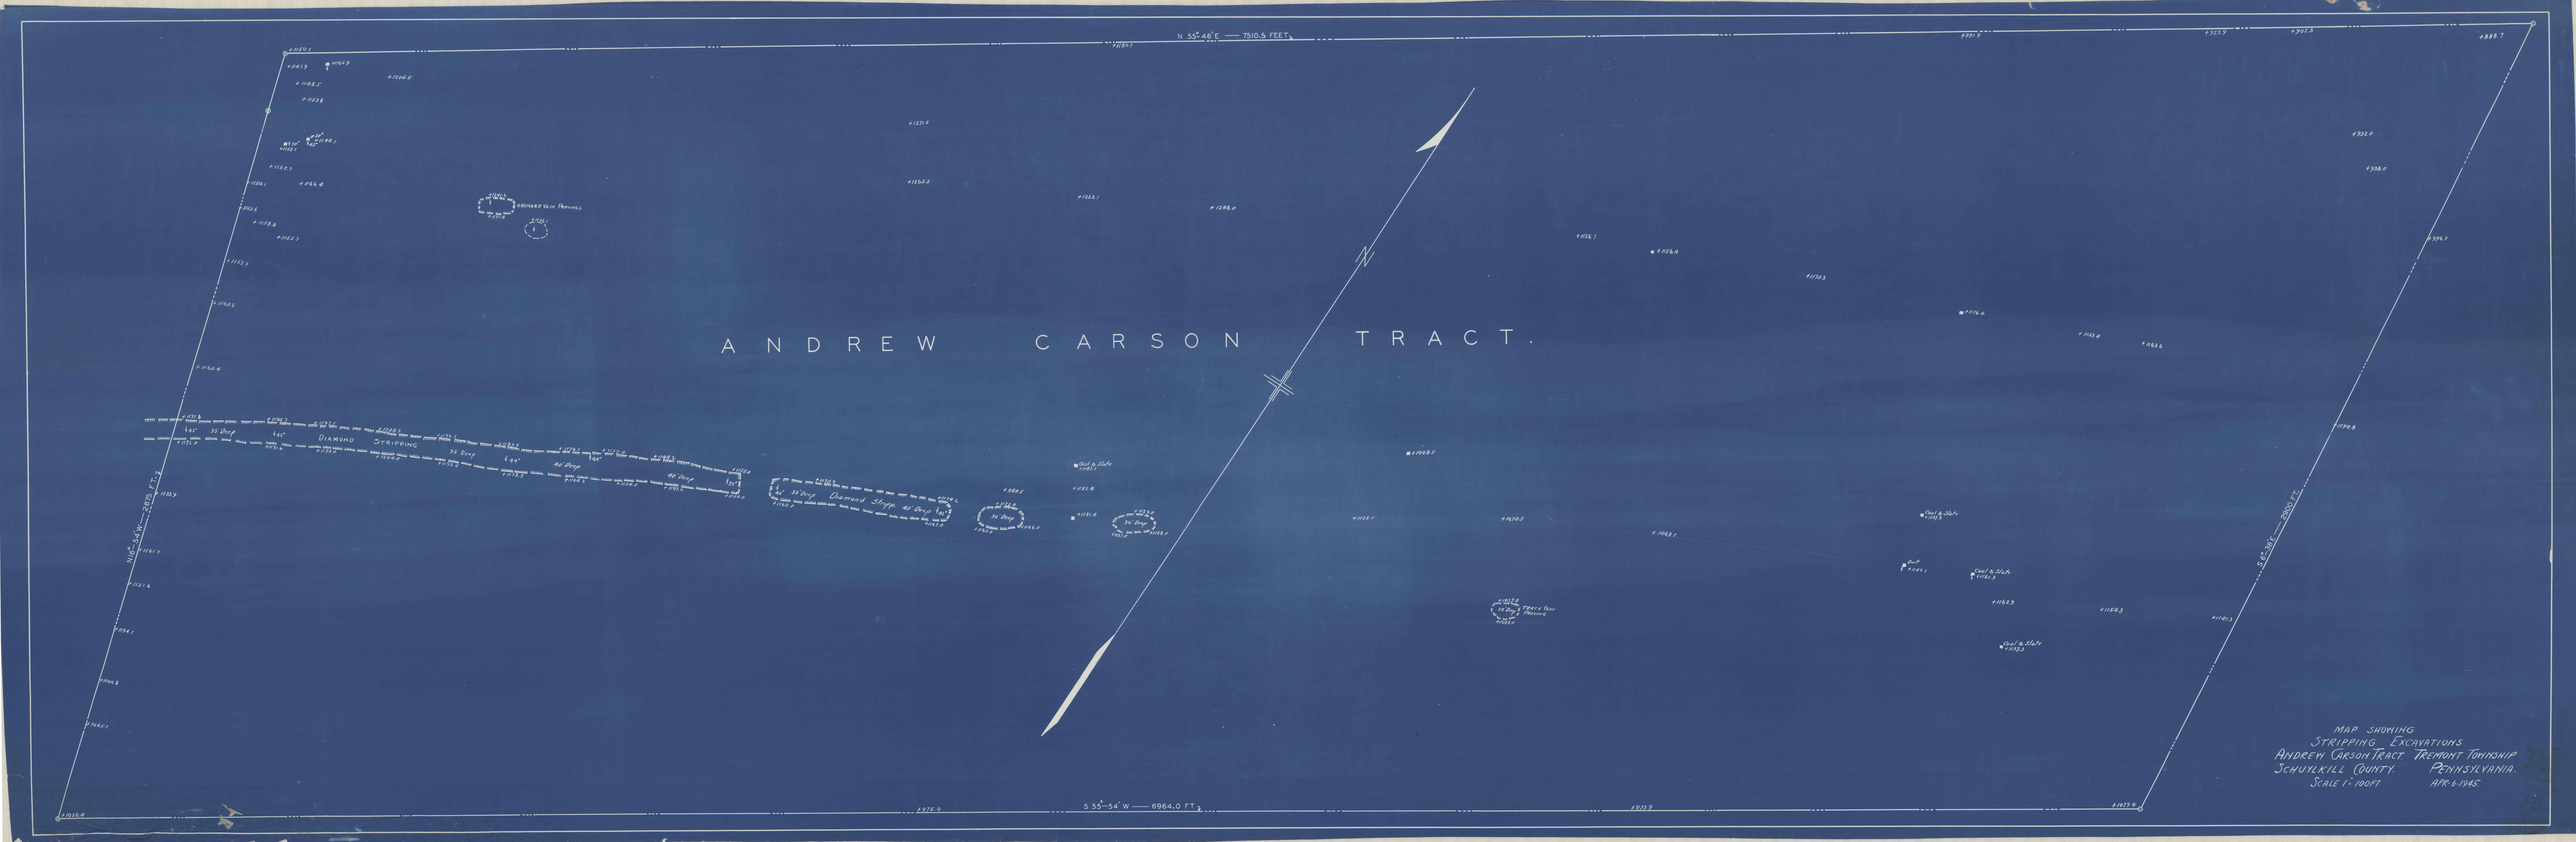
N 55°-46' E — 7510.5 FEET
ANDREW CARSON TRACT.
N
N 15°-54' W — 2875 FT.
S 45°-16' E — 2800 FT.
S 55°-54' W — 6964.0 FT.
ORCHARD TEAM PARKING
DIAMOND STRIPPING
35 Drop
40 Drop
Diamond Strip. 40 Drop
Coal & Slate
TRACK TEAM PARKING
MAP SHOWING
STRIPPING EXCAVATIONS
ANDREW CARSON TRACT TREMONT TOWNSHIP
SCHUYLKILL COUNTY PENNSYLVANIA.
SCALE 1" - 100 FT APR. 6-1945.