


GIRARD COLLIERY D — 100 FT. EAST OF GIRARD BREAKER  
CROSS SECTION ON COORDINATE LINE WEST 2500  
SCALE 1"=100' ENGINEERING DEPT. HAZLETON, PA. OCT-17-1922

NORTH

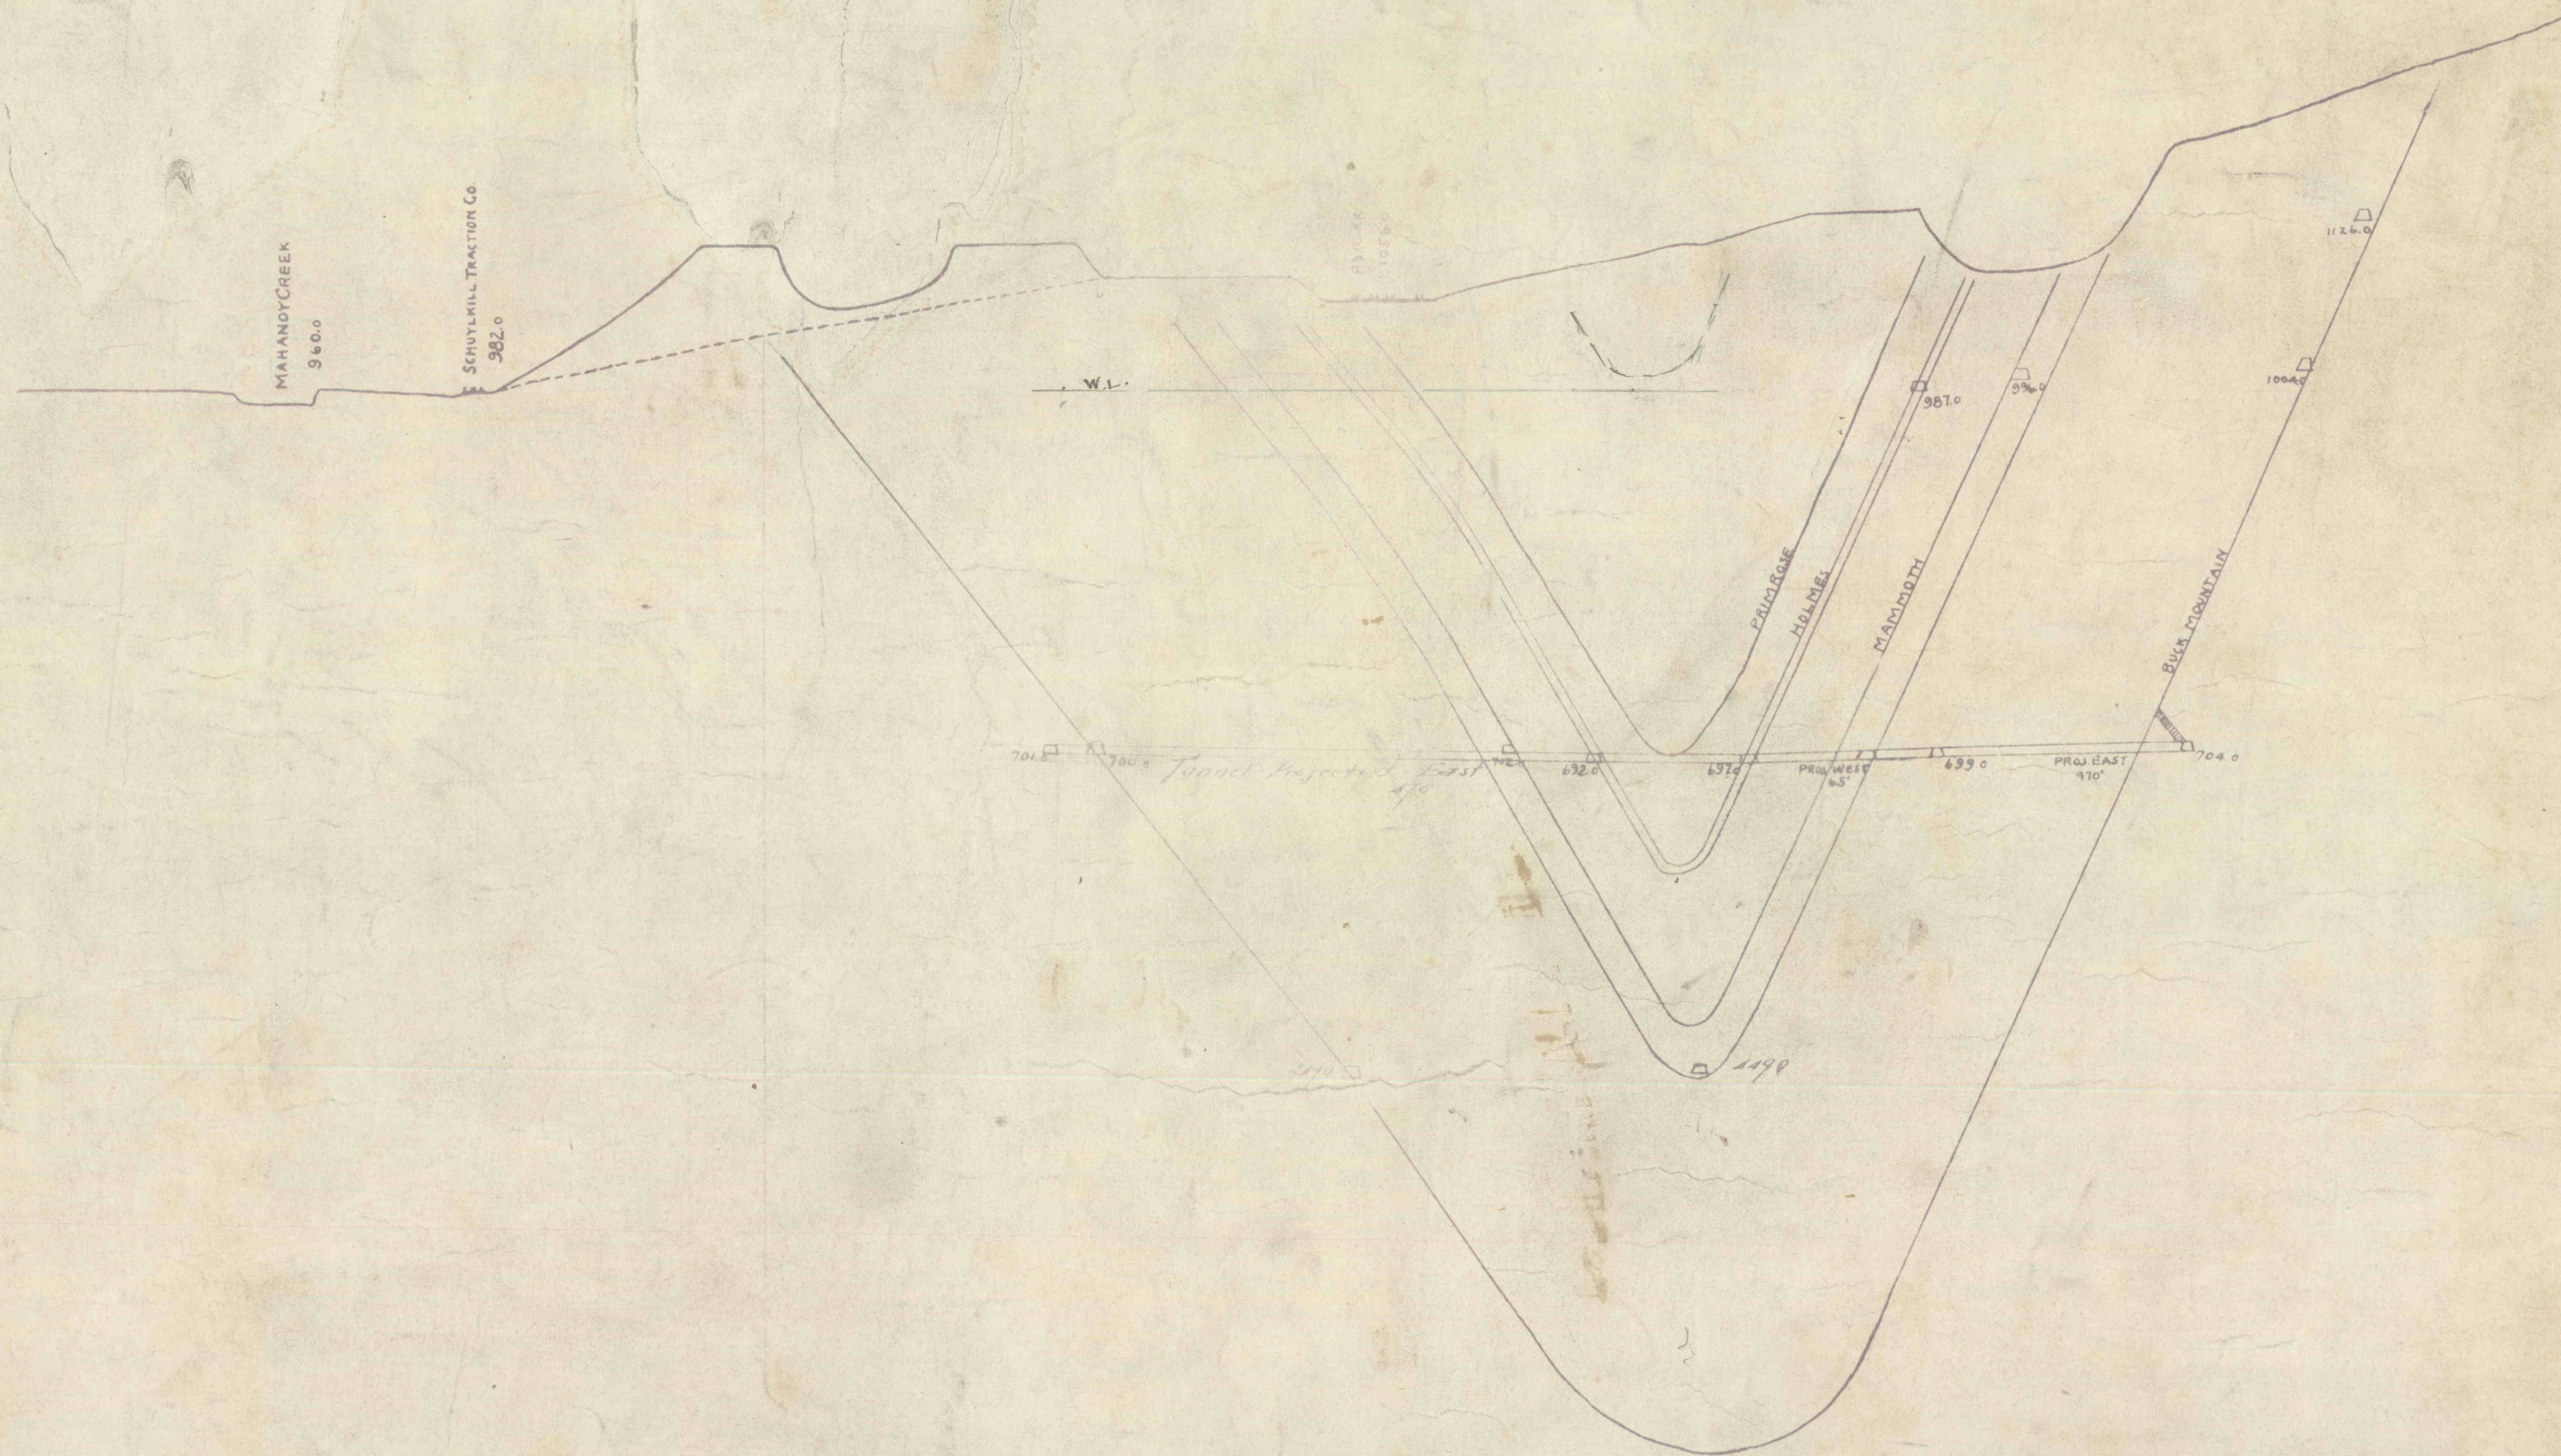

DATUM MEAN TIDE