PRESTON No. 3 COLLIERY

IN FROM BUCK MOUNTAIN VEIN 2ND LIFT AT BREAST No. 64.
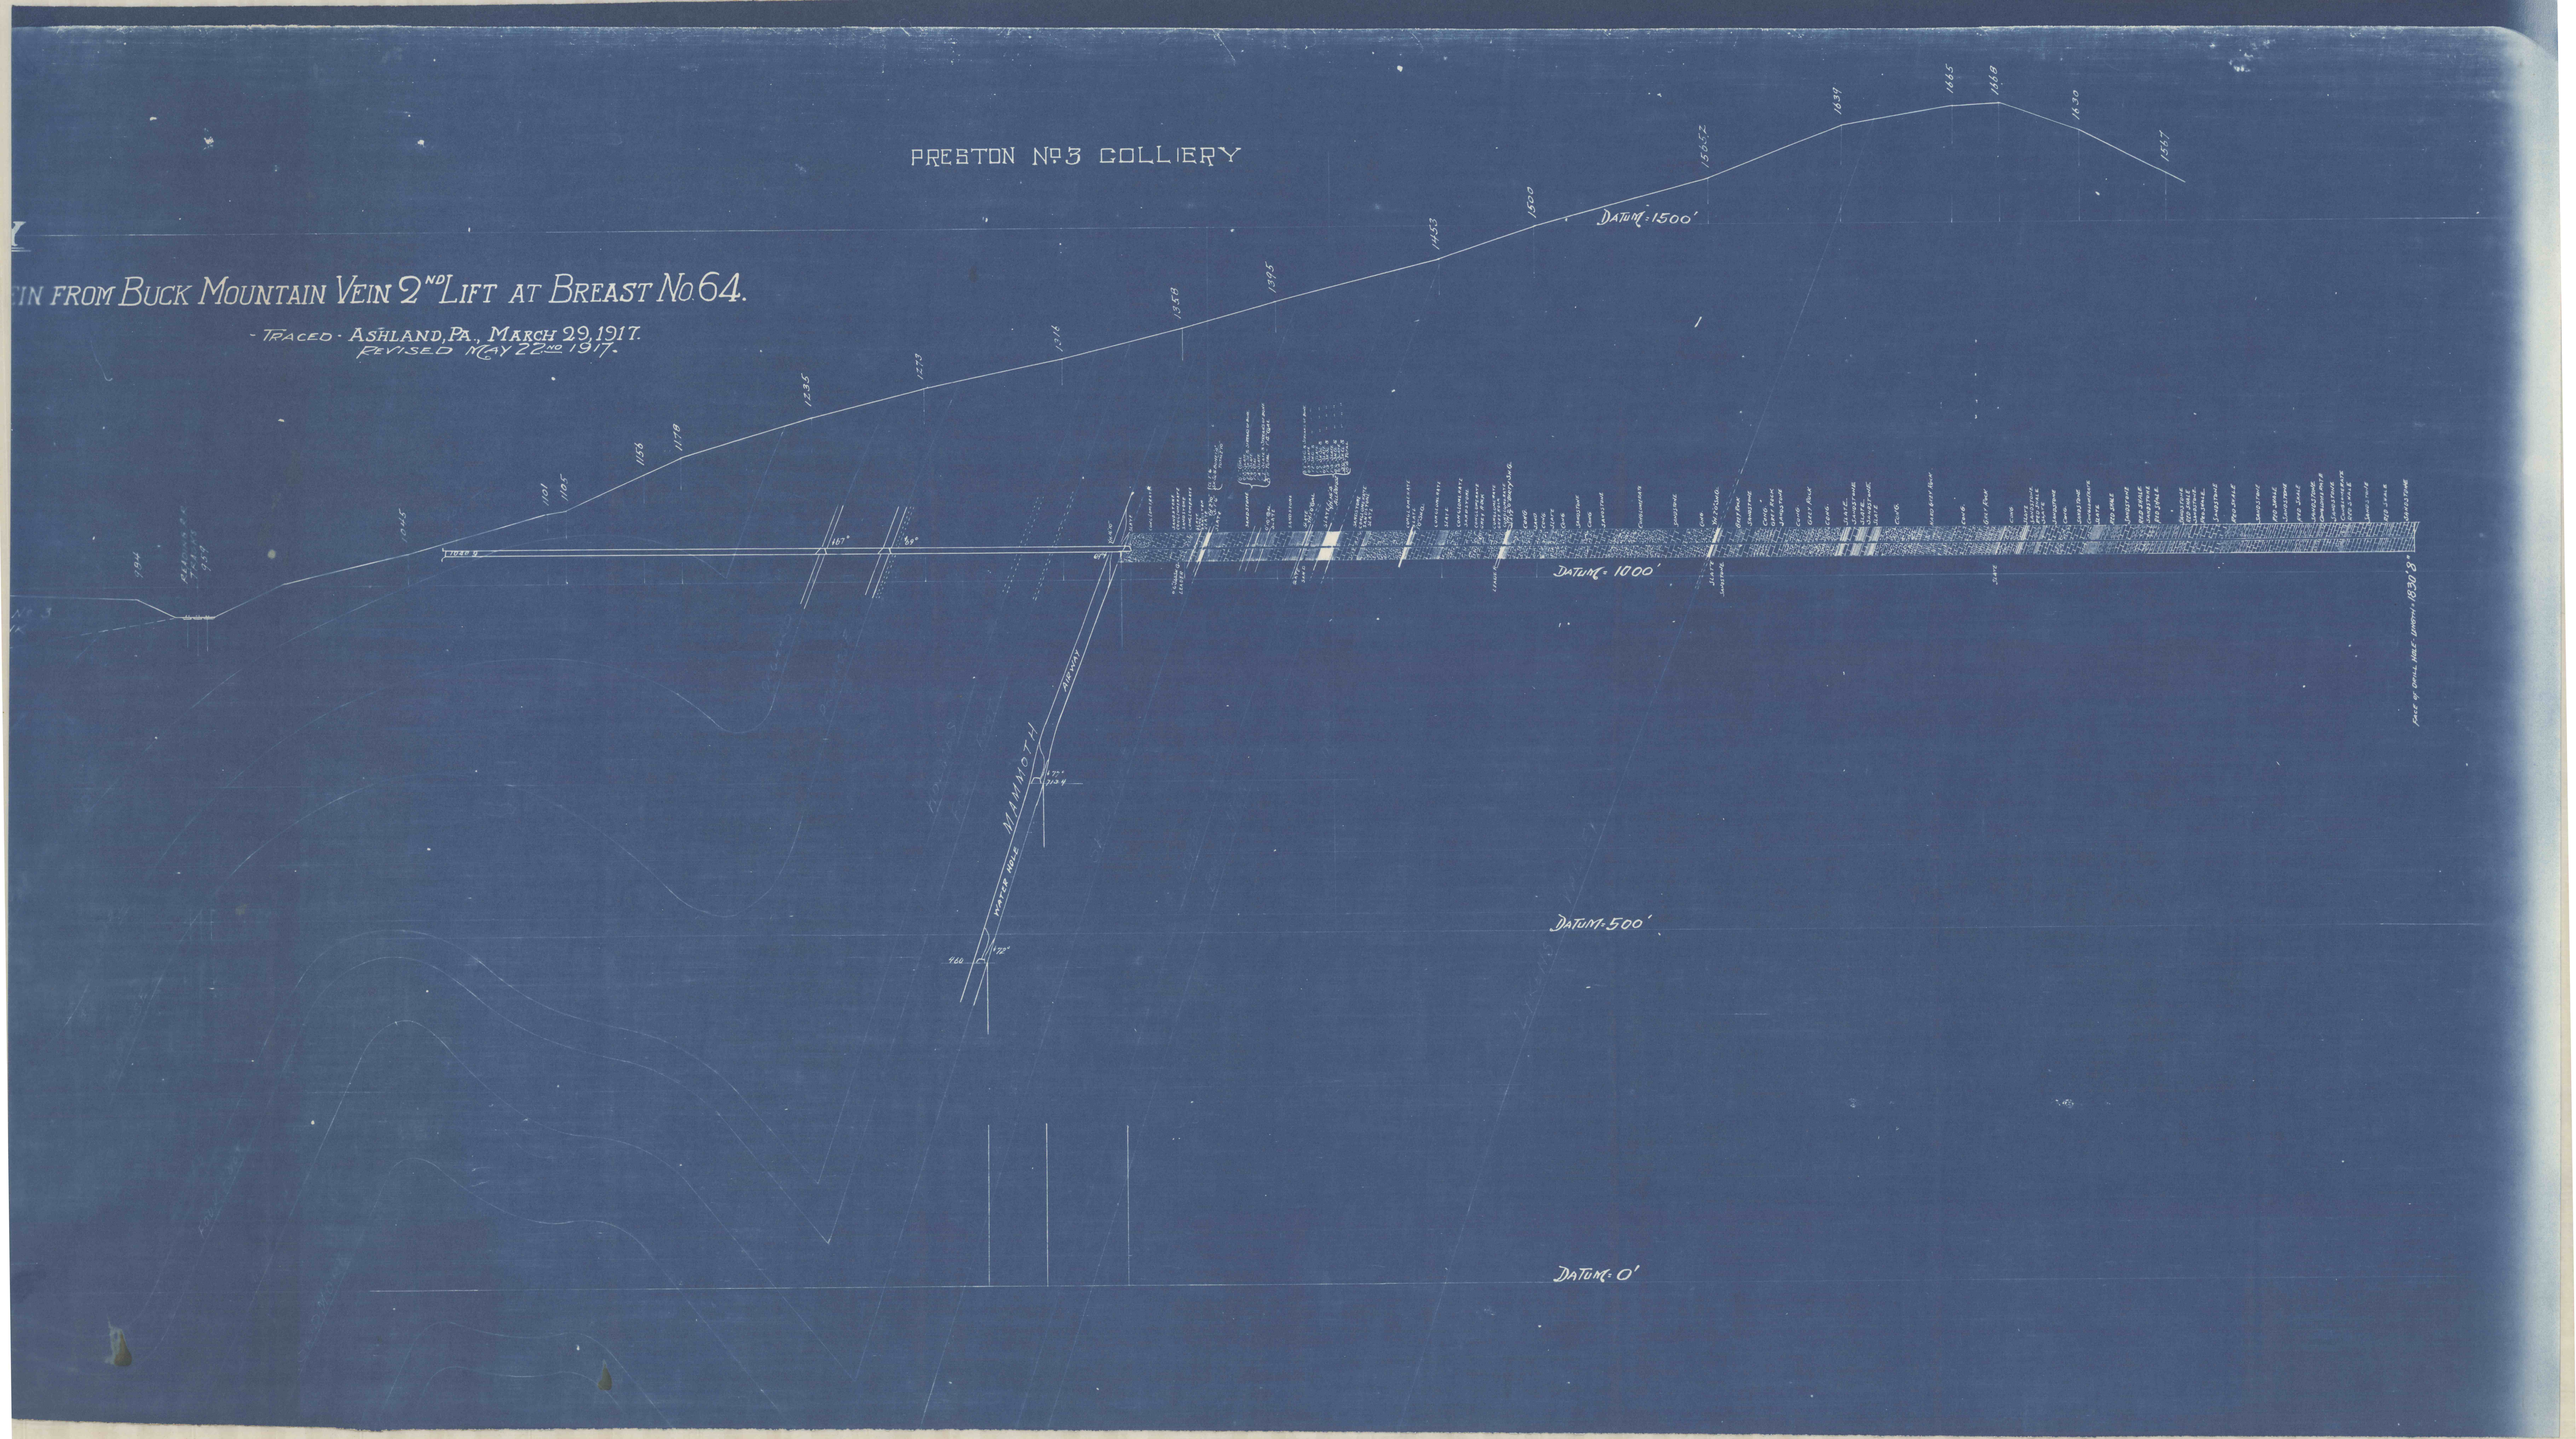
- TRACED - ASHLAND, PA., MARCH 29, 1917.
REVISED MAY 22ND 1917.