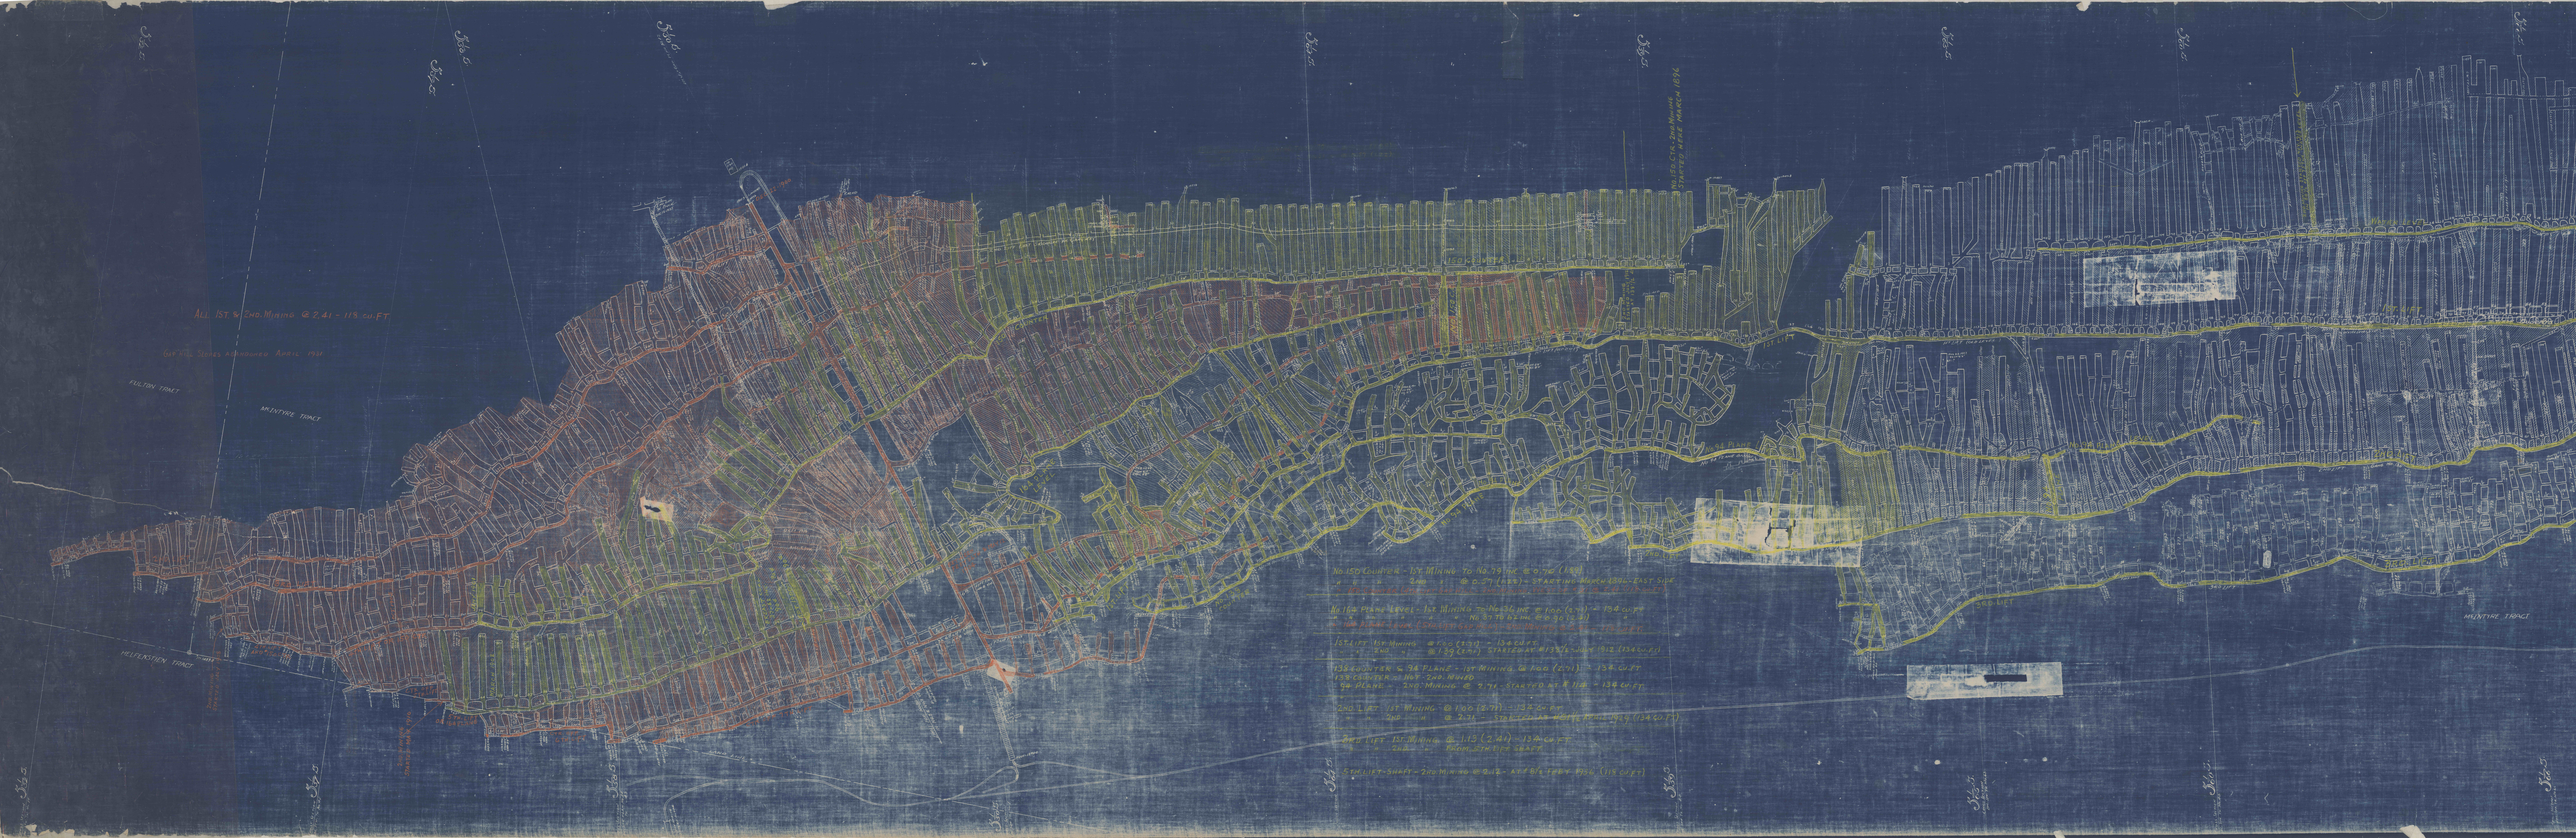
All 1st & 2nd Mining @ 2.41 = 118 cu.FT
Gaffney Stopes Abandoned April 1914
Fulton tract
McIntyre tract
Helfenstein tract
No 15 Cr. 2nd Mining Started 1st March 1894
No 15 Counter - 1st Mining To No 19 Inc @ 0.76 (1.88)
2nd " @ 0.71 (1.85) = Starting North 430 E. East Side
Paddle Stope
2nd " "
Stollet-Shaft - 2nd Mining @ 6.42 - At 8 1/2 Feet Pitch (118 cu.FT)