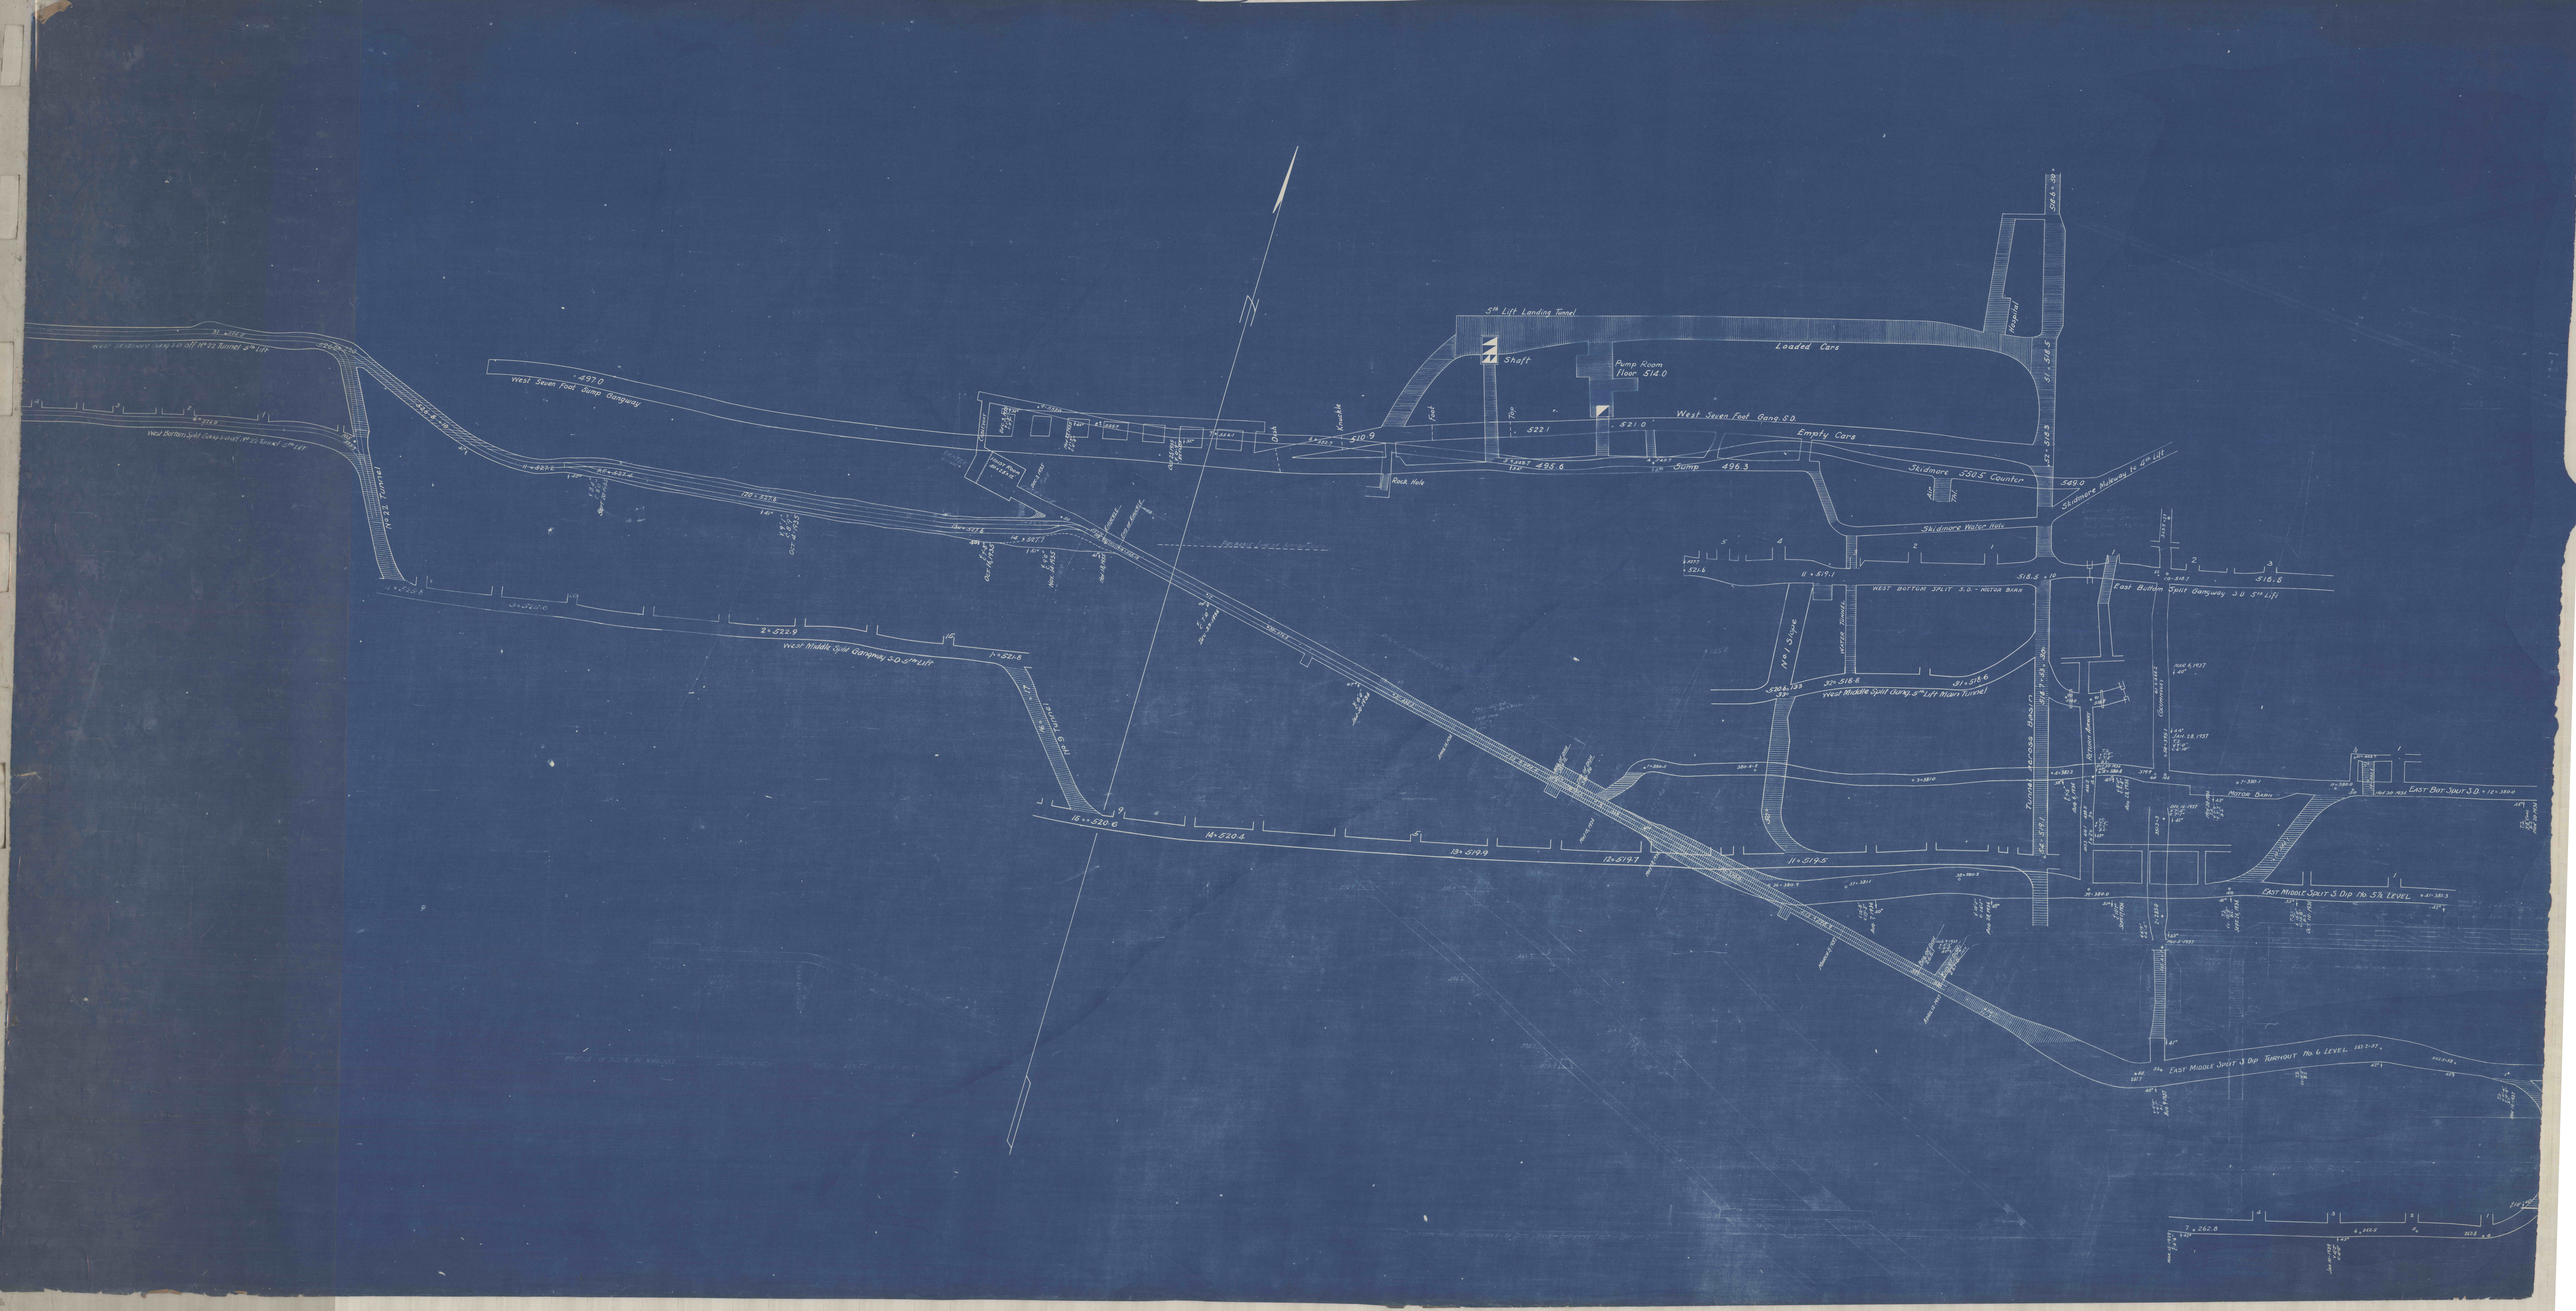
5th Lift Landing Tunnel
Shaft
Pump Room
Floor 514.0
Loaded Cars
Empty Cars
West Seven Foot Gang S.D.
West Seven Foot Sump Gangway
Sump 496.3
Skidmore 520.5 Counter
Skidmore Water Hole
Rock Hole
West Bottom Split S.D. - Motor Barn
East Bottom Split Gangway S.D. 5th Lift
West Middle Split Gang. 5th Lift Main Tunnel
West Middle Split Gangway S.D. 5th Lift
East Bot. Split S.D.
East Middle Split S Dip to 5% Level
East Middle Split S Dip Turnout No 6 Level
Motor Barn
Hospital
Knuckle
Oil
Tunnel
West Skidmore Gang S.D. Off No 22 Tunnel 5th Lift
West Bottom Split Gang S.D. Off No 22 Tunnel 5th Lift
No 22 Tunnel
No 1 Slope
Tunnel Slope