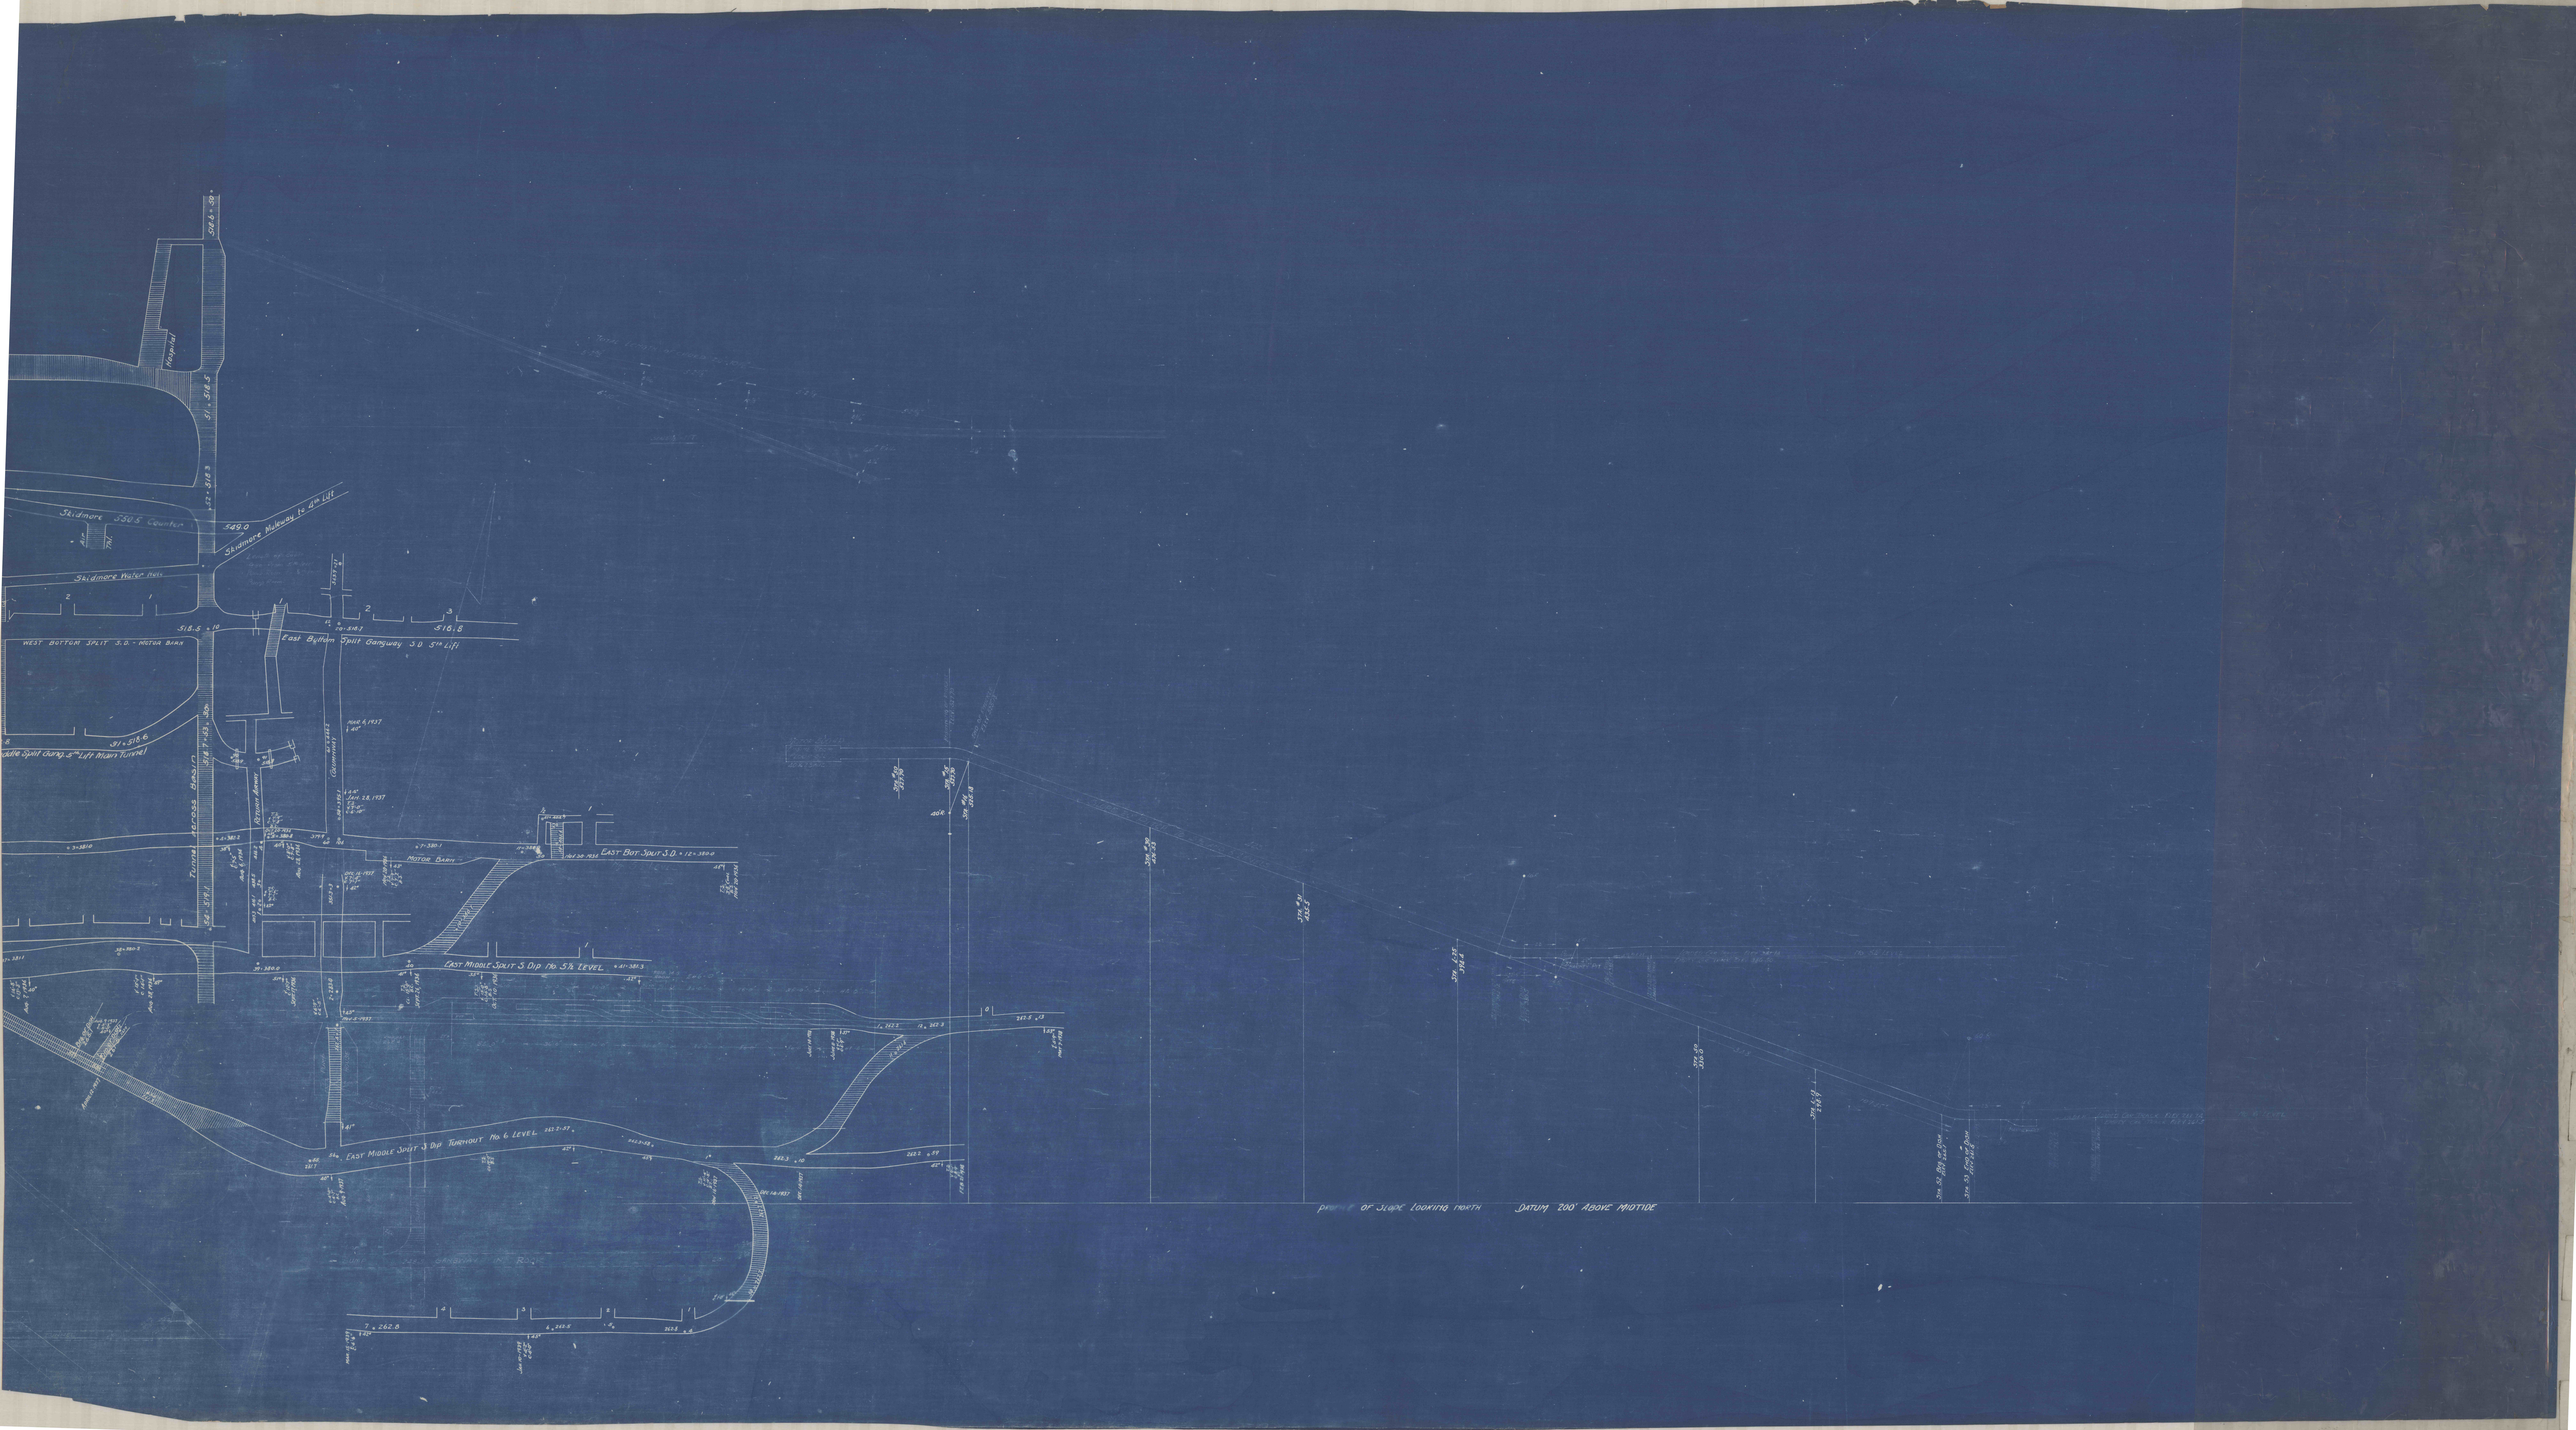
Skidmore S.S.S. Counters
549.0
Skidmore Haulway 1st 4th Lift
Skidmore Haulage Hole
518.5
518.8
East Bottom Split Gangway S.D. 5th Lift
WEST BOTTOM SPLIT S.D. - MOTOR BARN
Tunnel Across Basalt
East Bottom Split S.D. = 12 - 380.0
Motor Barn
East Middle Split S Dip No 5 Level
East Middle Split S Dip Turnout No 6 Level
Datum 200' Above Mid Tide