

NORTHWEST


HUDSON

COAL

CO.

COAL

CO.

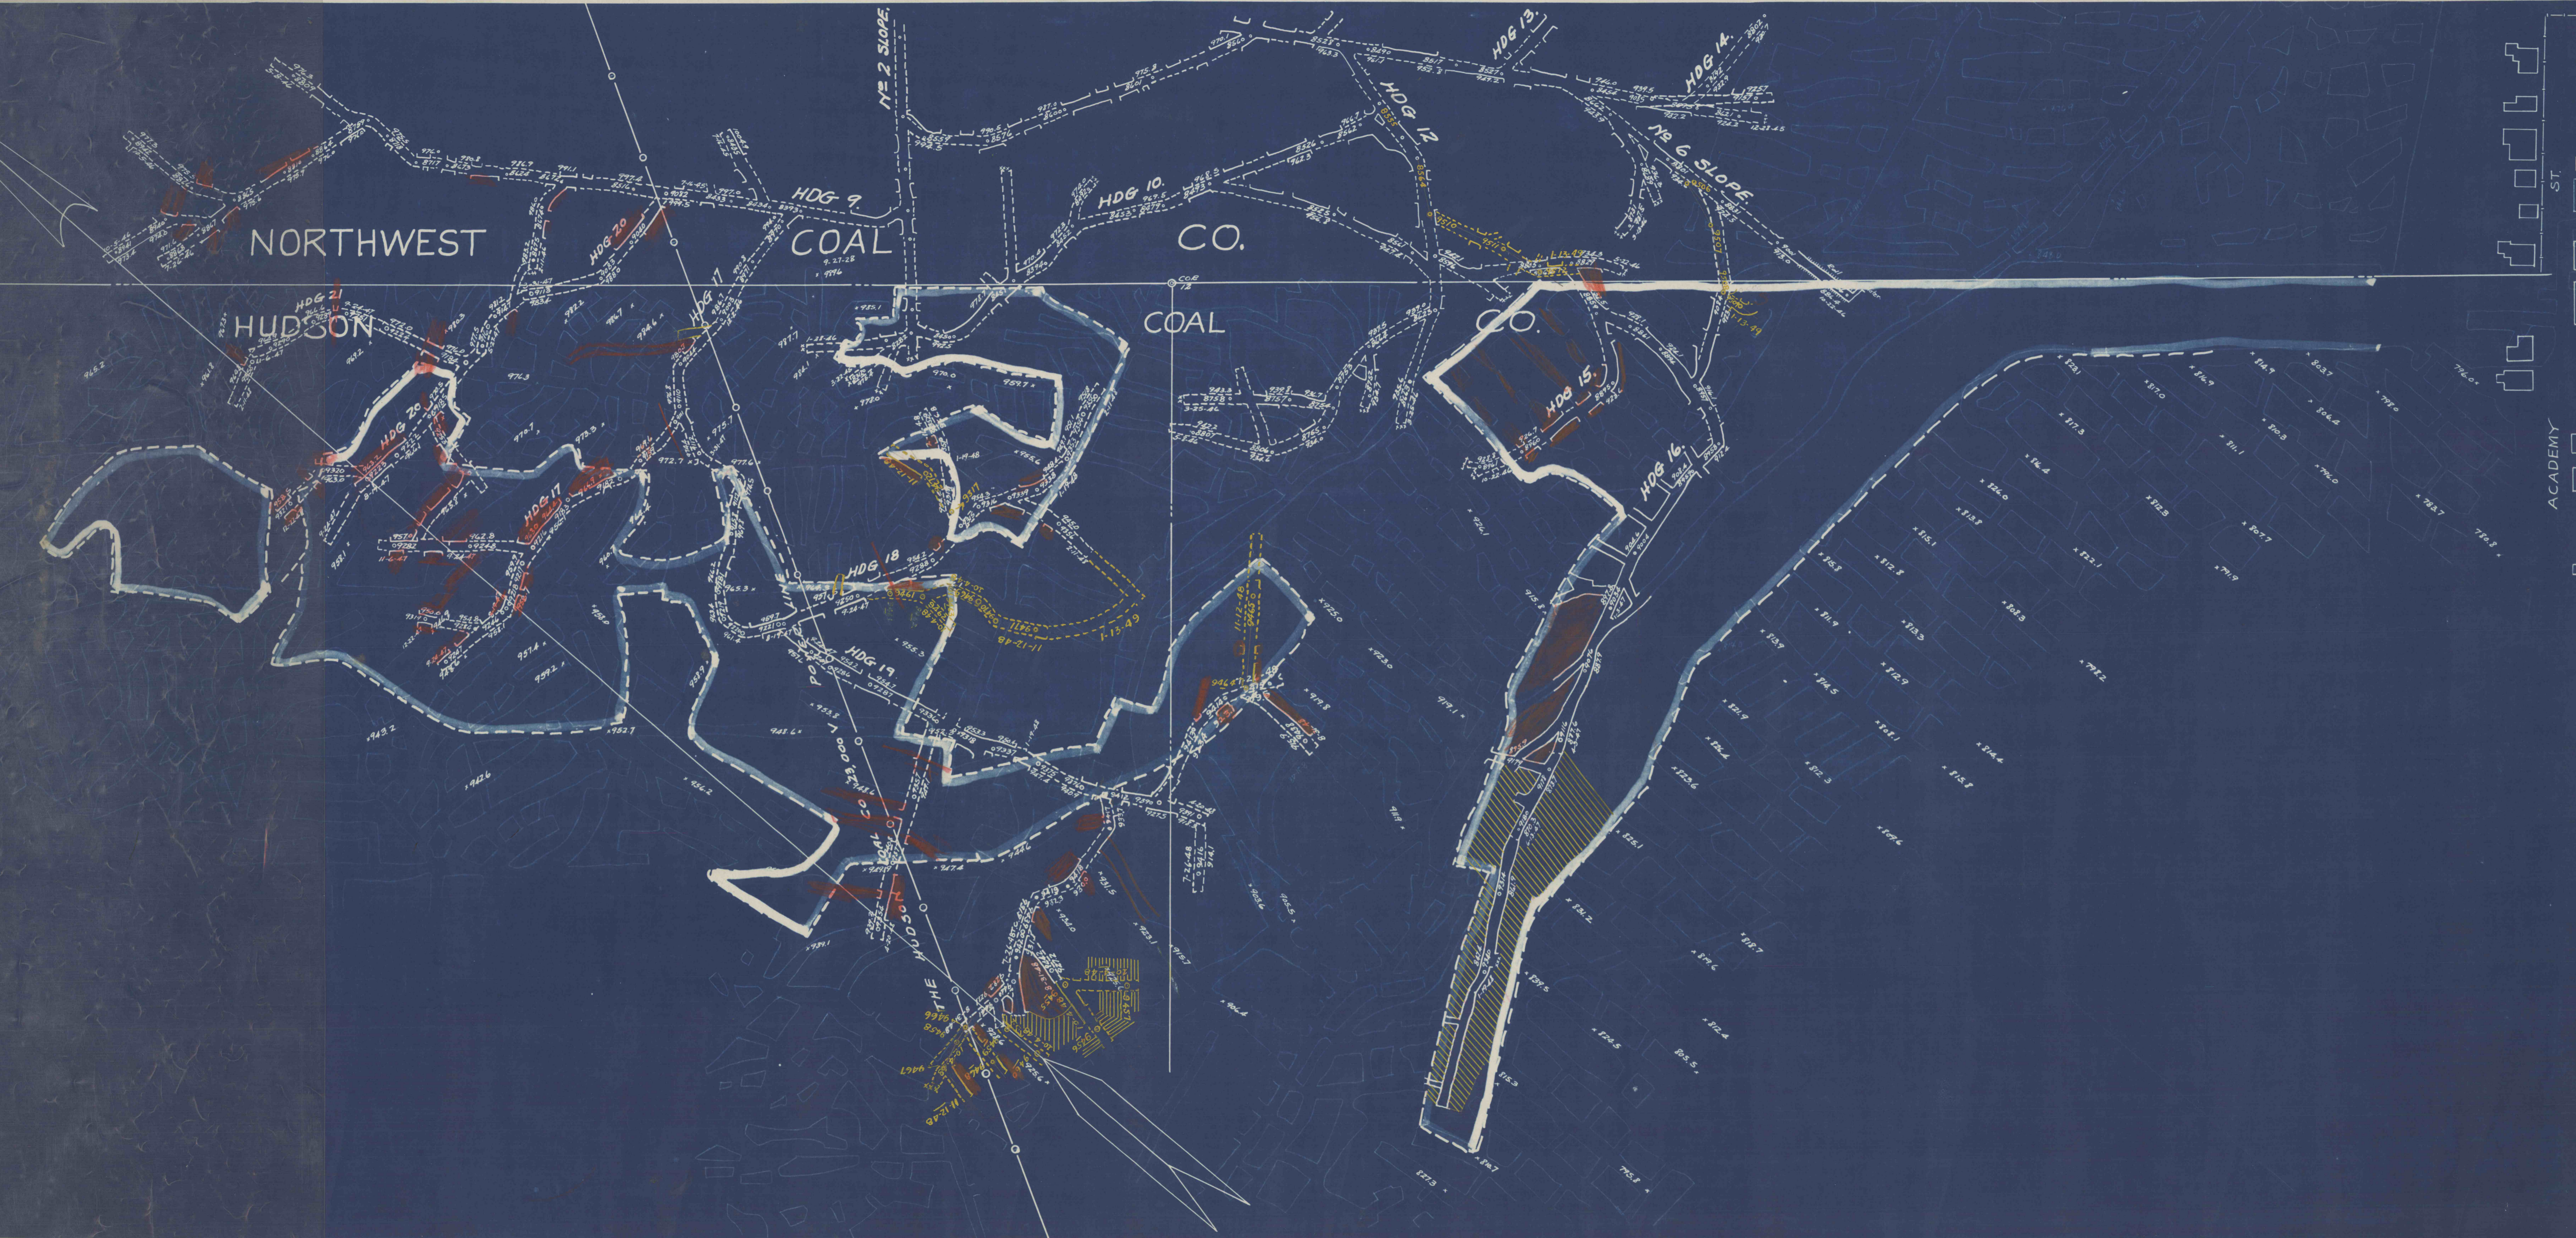

ACADEMY

ST.

ST.

MAIN