


N.C. & I. CO.

N.C. & I. CO.

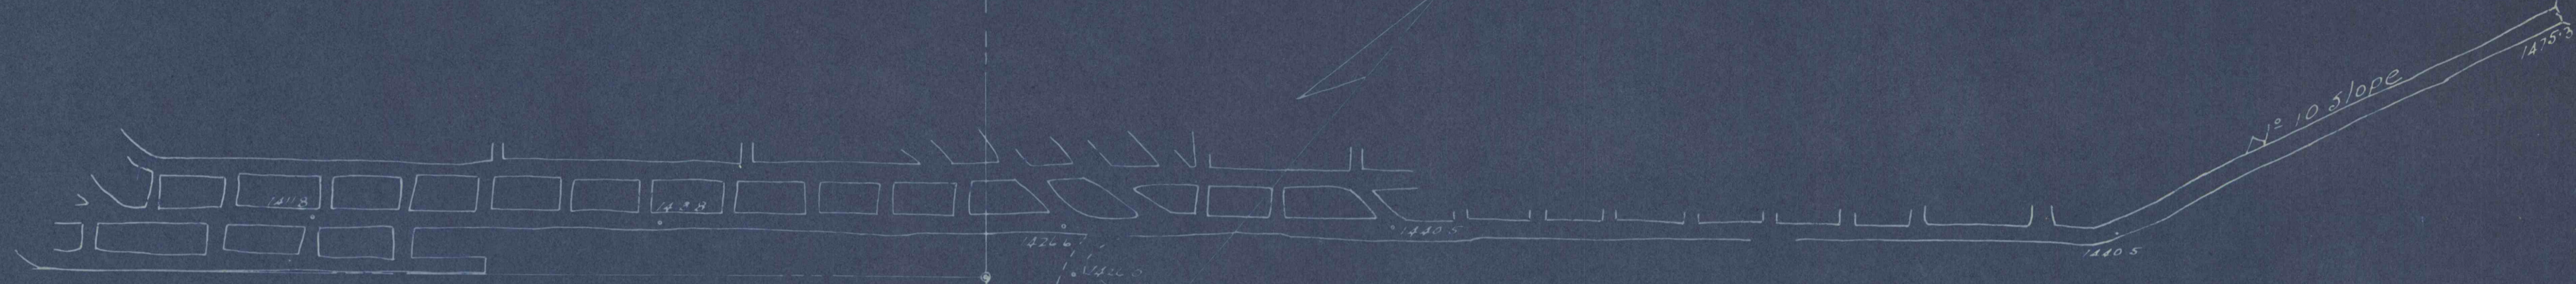

TEMPLE COAL CO

AREA ROBBED

NORTH WEST COAL CO



Area stripped by Northwest Coal Co

TEMPLE COAL CO

CLINTON COLLIERY  
 N° 10 LOPE GRASSY BED  
 J. Mascall Lease - John Banko S. pe  
 Scale 1" = 100' 1-26-43

—— Middle Grassy  
 - - - - Bottom