


HOWARD WARRANT

ANSLE WARRANT

Lacka Co.

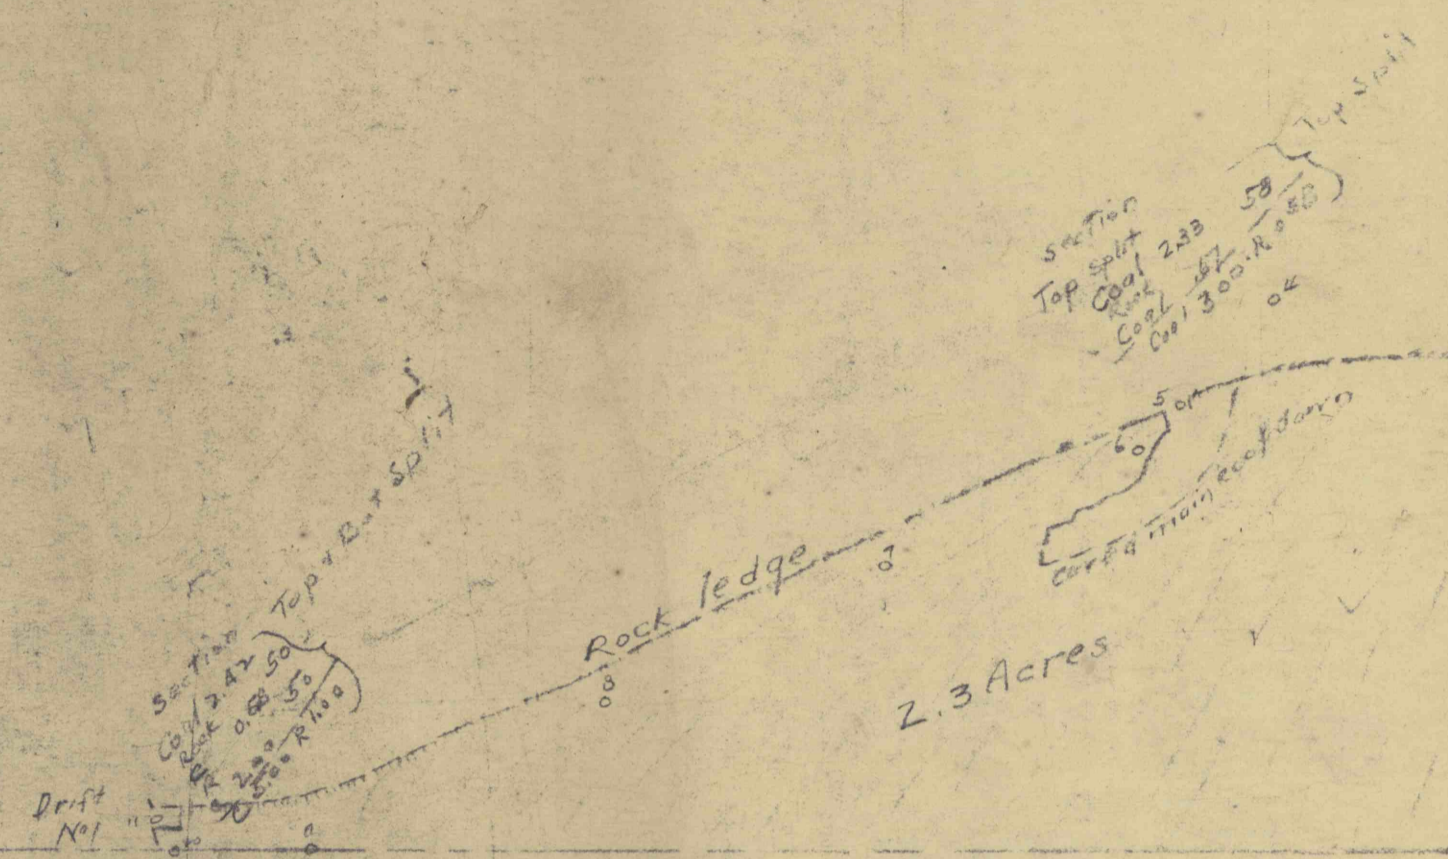

THE HUDSON COAL COMPANY



WEST MOUNTAIN COAL CO
JERMYN, PA
No. 2 + No. 3 DUNMORE VEIN

June 27 1941

Scale and compiled by James A. Killeen, Jr.
J.A.K.