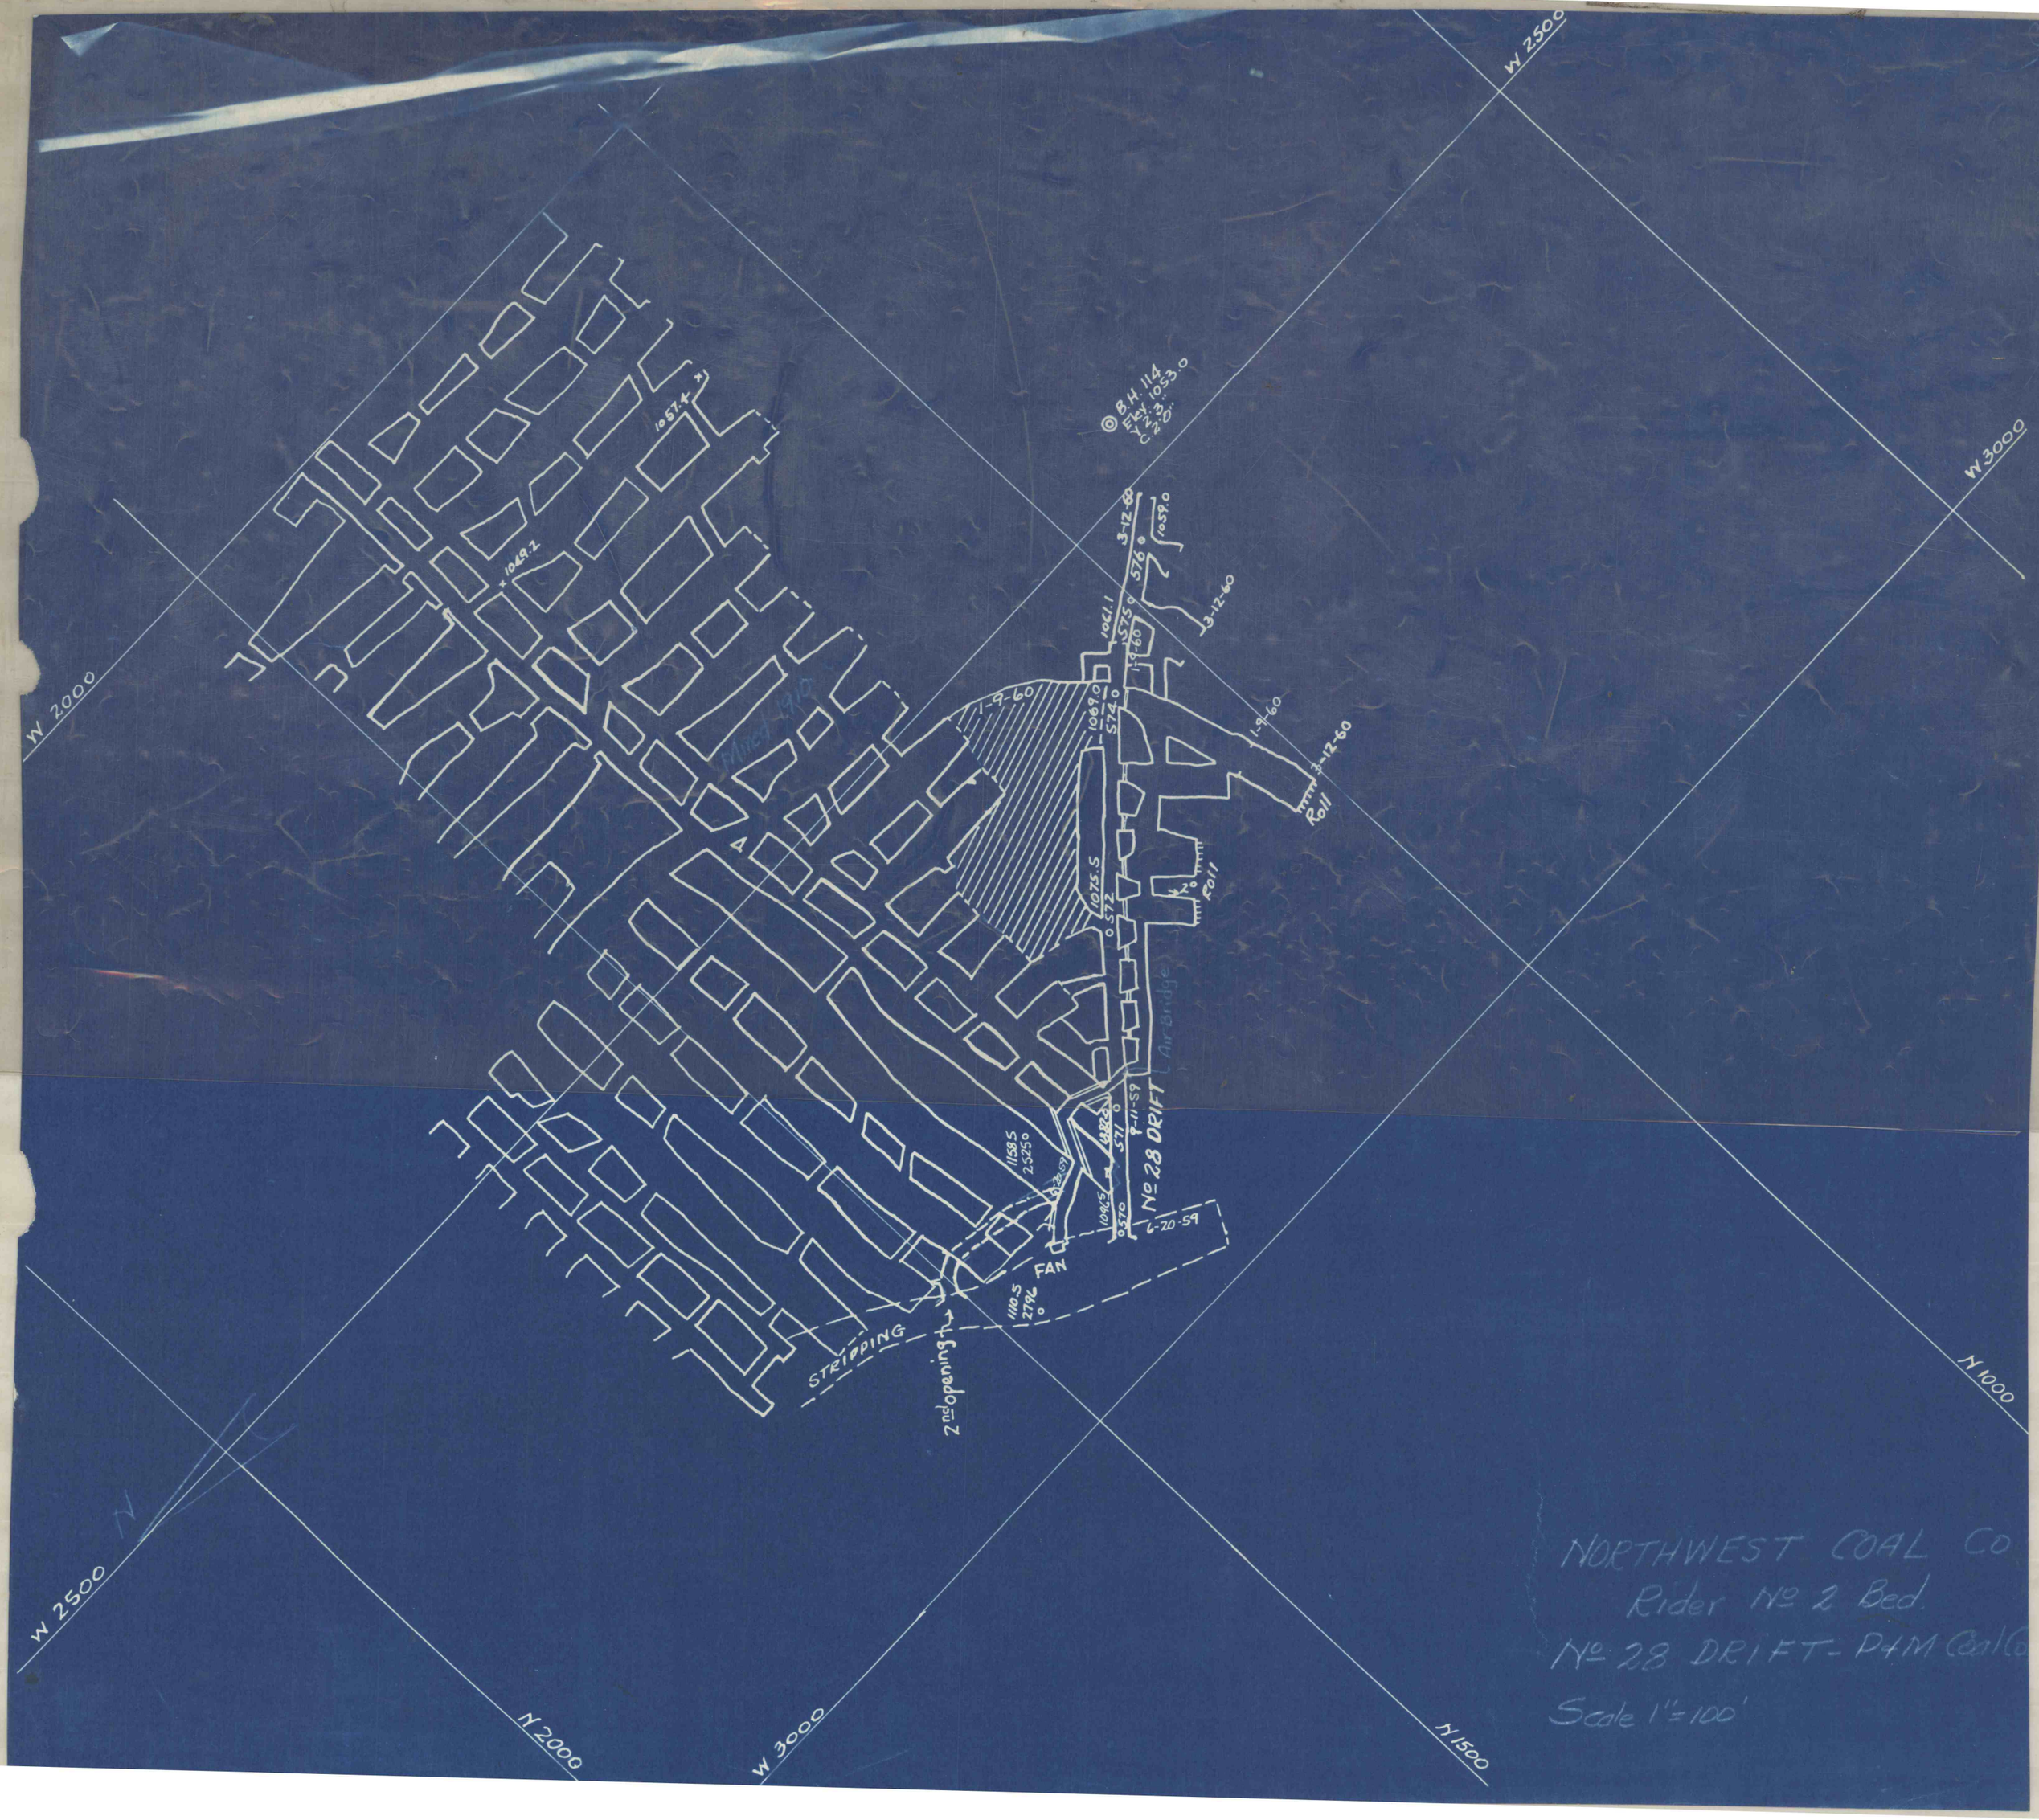
W 2500
W 3000
W 2000
N 1000
N 1500
N 2000
W 3000
W 2500
B.H. 114
Elev. 1053.0
Y 2.3
C 2.0
1057.4
1049.2
3-12-60
1059.0
576.0
1061.1
575.0
1-9-60
1069.0
574.0
1-9-60
3-12-60
Roll
1075.5
572.0
Roll
Air Bridge
9-11-59
571.0
No 28 DRIFT
1158.5
2525.0
1096.5
570.0
6-20-59
FAN
1110.5
2796.0
STRIPPING
2nd opening
N
NORTHWEST COAL Co
Rider No 2 Bed
No 28 DRIFT - P&M Coal Co
Scale 1" = 100'