

B.H. 15
CLARK 980.0
DUNN 816.3
DUNN 861.7

B.H. 21
CLARK 725.0
DUNN 870.0
DUNN 870.5

B.H. 183
CLARK 787.0
DUNN 881.5
DUNN 885.2

B.H. 12
CLARK 727.0
DUNN 871.3


B.H. 132
CLARK 730.0
DUNN 875.3
DUNN 889.0

10 Acres
2.2
Ten to Place 514,870

B.H. 182
CLARK 725.0
DUNN 887.2

B.H. 136
CLARK 939.0
DUNN 871.7
DUNN 860.0

B.H. 56
CLARK 720.0
DUNN 870.0
DUNN 870.5

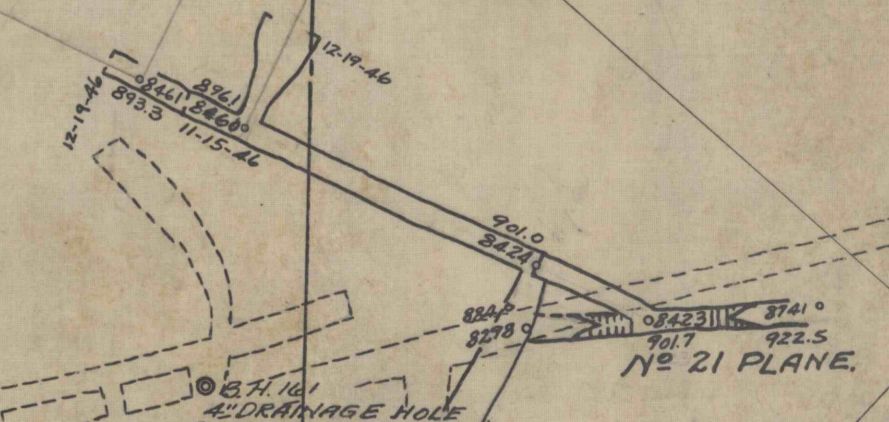

B.H. 121
CLARK 731.7
DUNN 871.3

B.H. 134
CLARK 731.7
DUNN 871.3

Northwest Coal Co. Cartersdale