

NORTHWEST

HUDSON

COAL

COAL

CO.


CO.

*Robbed back to here 8/3/50*

*Robbed to here 12/7/49*

N# 2 SLOPE

N# 6 SLOPE

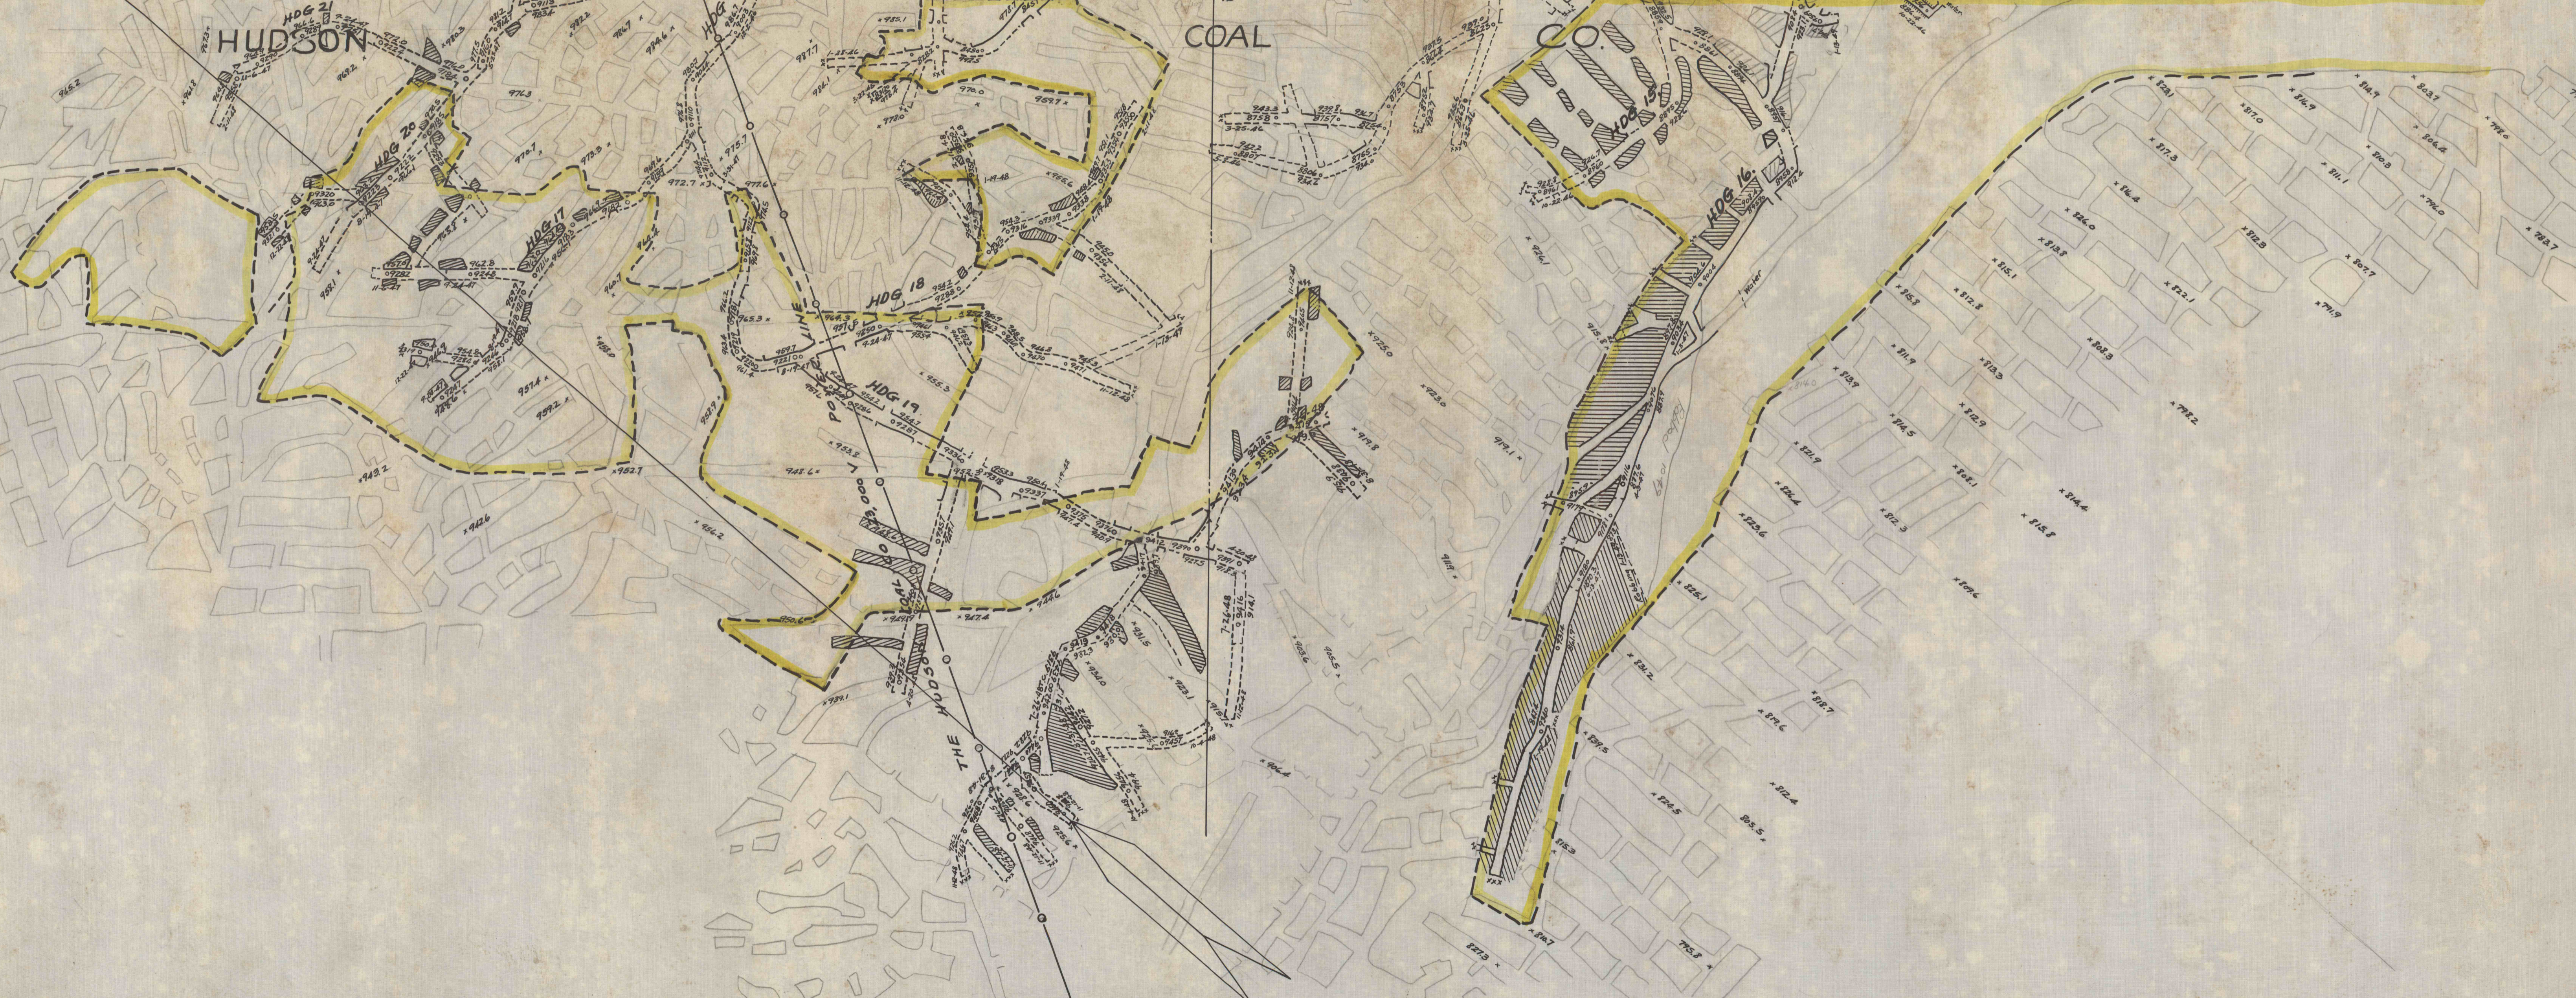

ACADEMY ST.

MAIN ST.