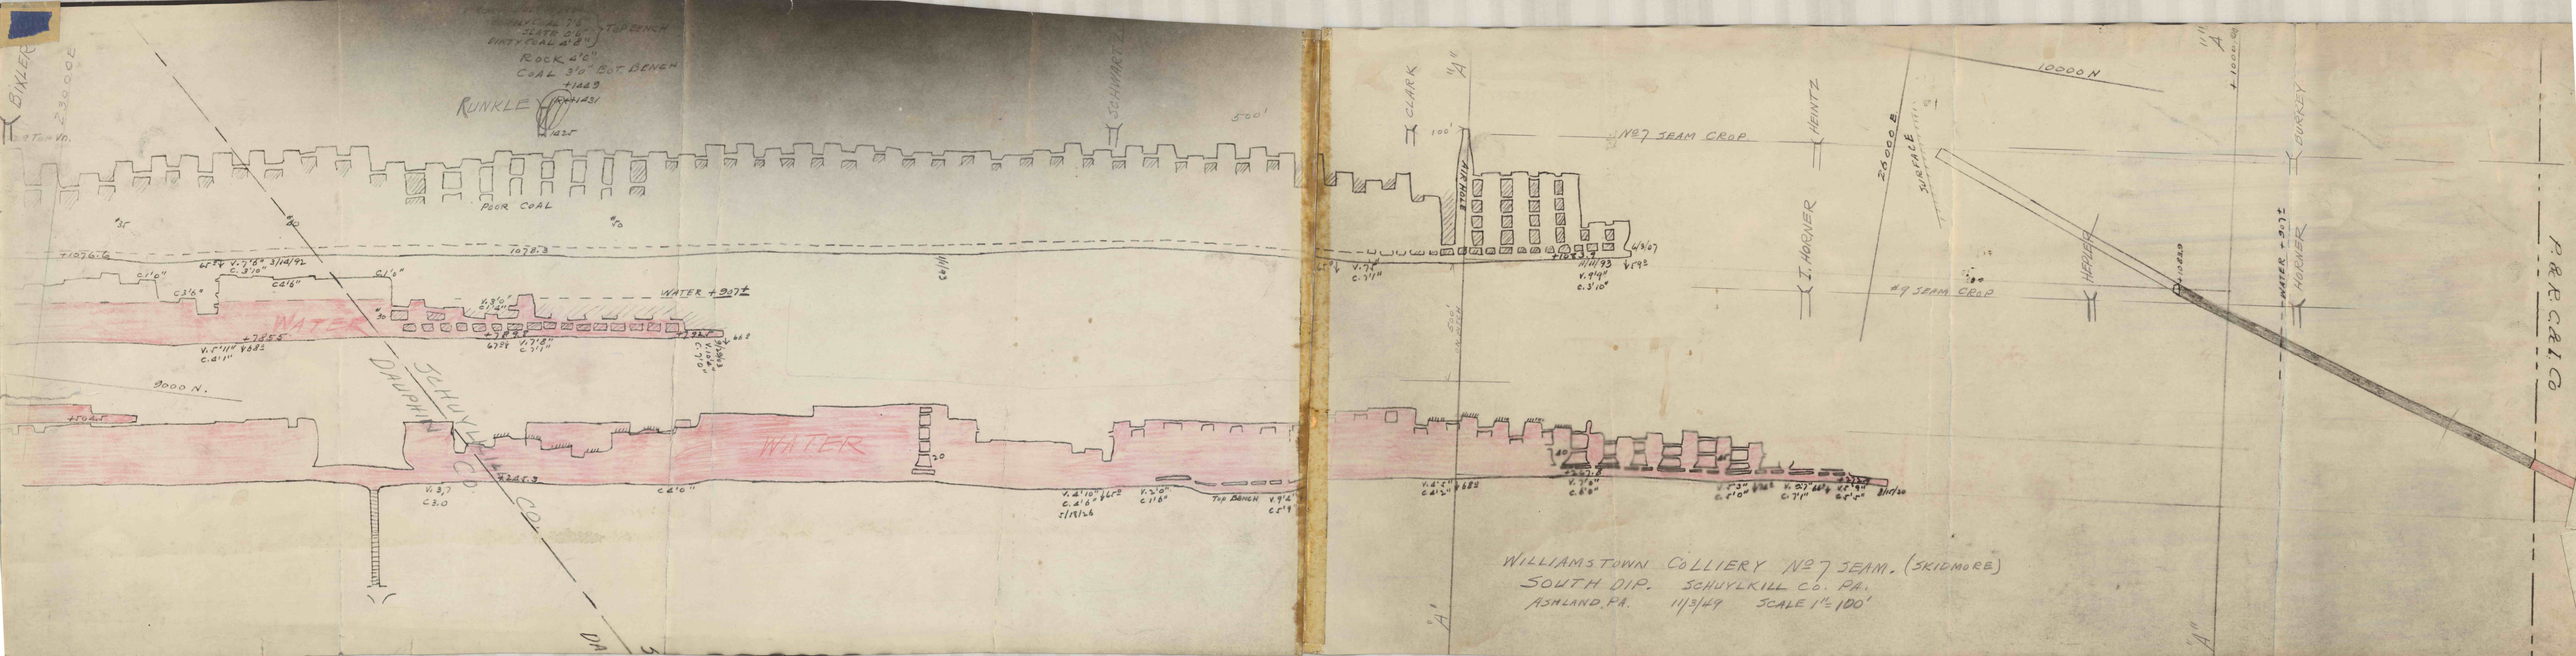
BIXLER
230000E
TOP BENCH
DIRTY COAL 4'6"
ROCK 4'6"
COAL 3'0" BOT. BENCH
RUNKLE
SCHWARTZ
500'
POOR COAL
WATER
WATER +907±
DAUPHIN
SCHUYLKILL CO.
9000 N.
STOPE
Top Bench
CLARK
100'
No 7 SEAM CROP
HEINTZ
I. HOGNER
20,000 E
SURFACE
#7 SEAM CROP
10000 N
HEPLER
WATER +907±
HOGNER
PURKEY
P.R.R. CR. I. CO.
WILLIAMSTOWN COLLIERY No 7 SEAM. (SKIDMORE)
SOUTH DIP. SCHUYLKILL CO. PA.
ASHLAND, PA. 1/3/49 SCALE 1" = 100'