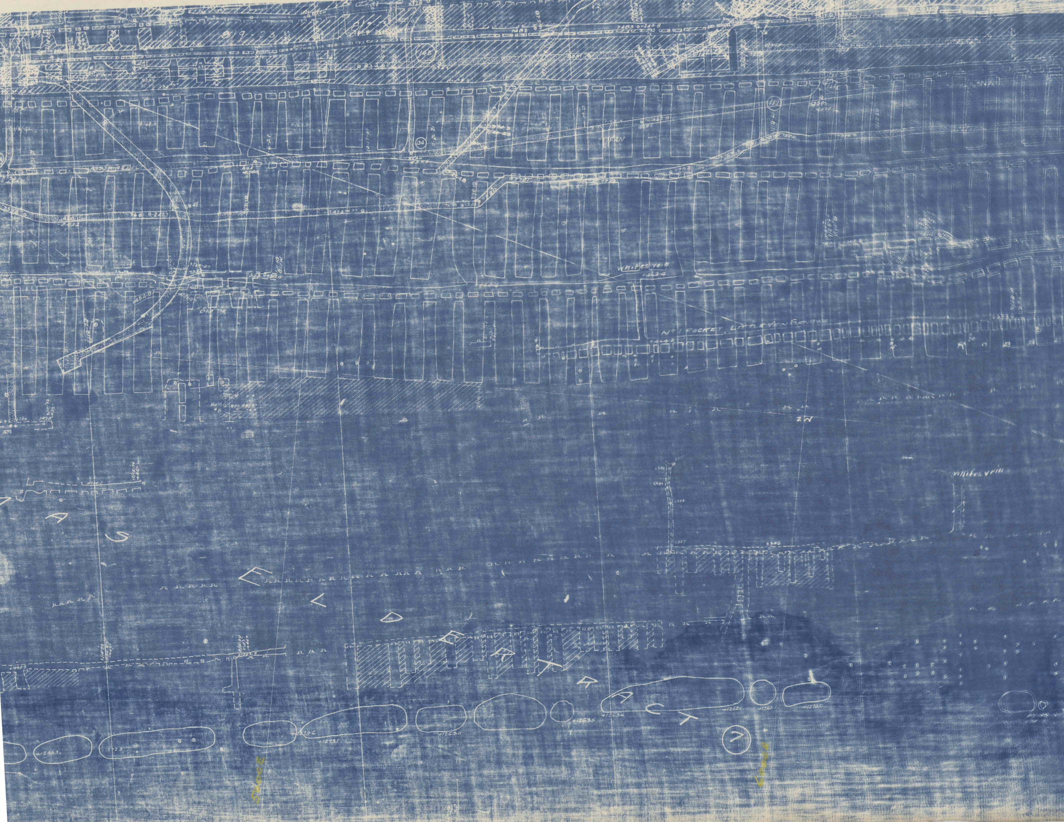
Whites Vein
+463.4
No 1 Pocket, Little Vein Gangway
+464.2
2W
Whites Vein
AS ELDER TRACT
+1279.6
+1273.1
+1269.0
+1263.5
+1263.4
+1262.1
+1268.1
7
5000E
6000

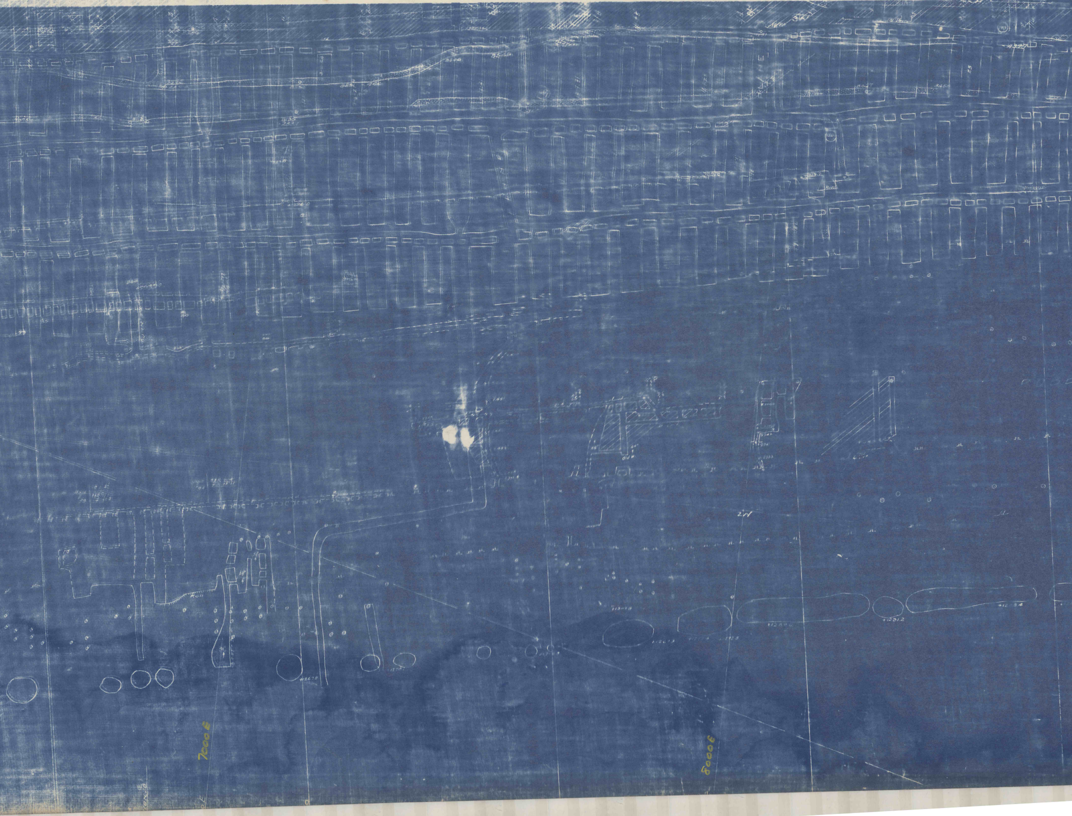

7000E
6000E

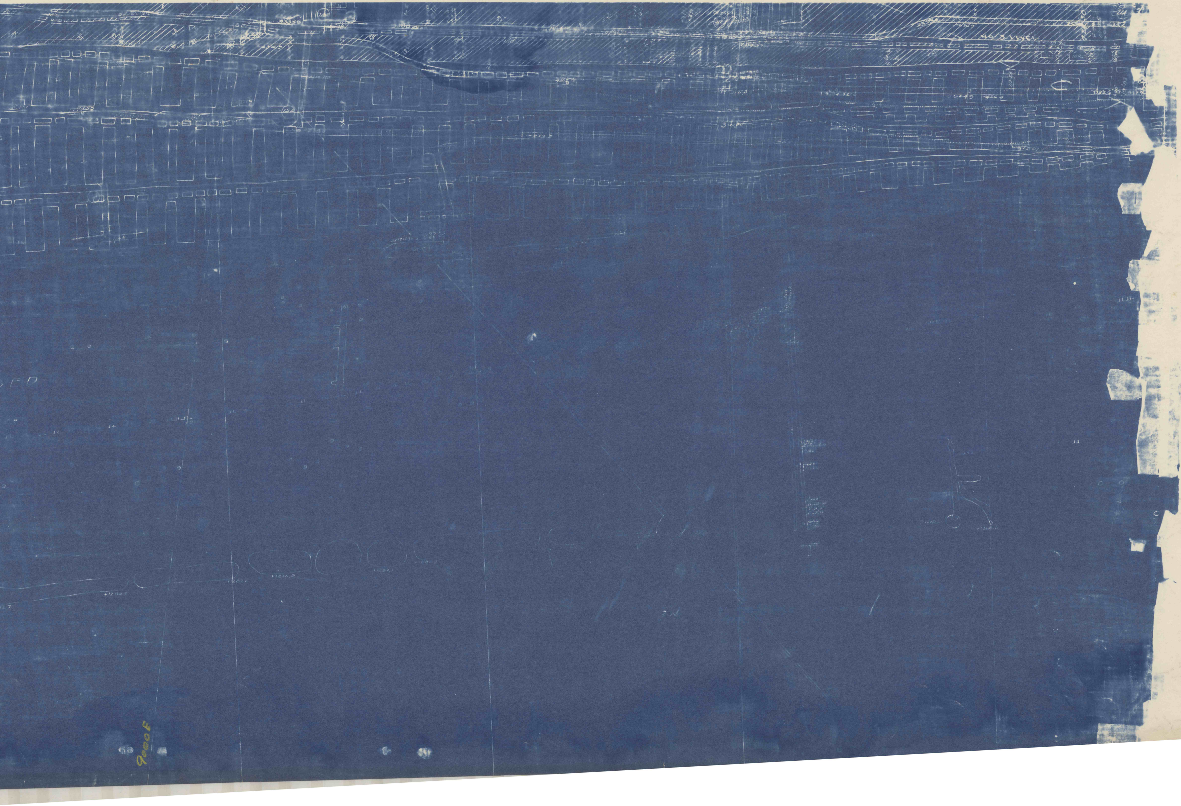
NO 3 LEVEL
22A
5249
4264
9000E

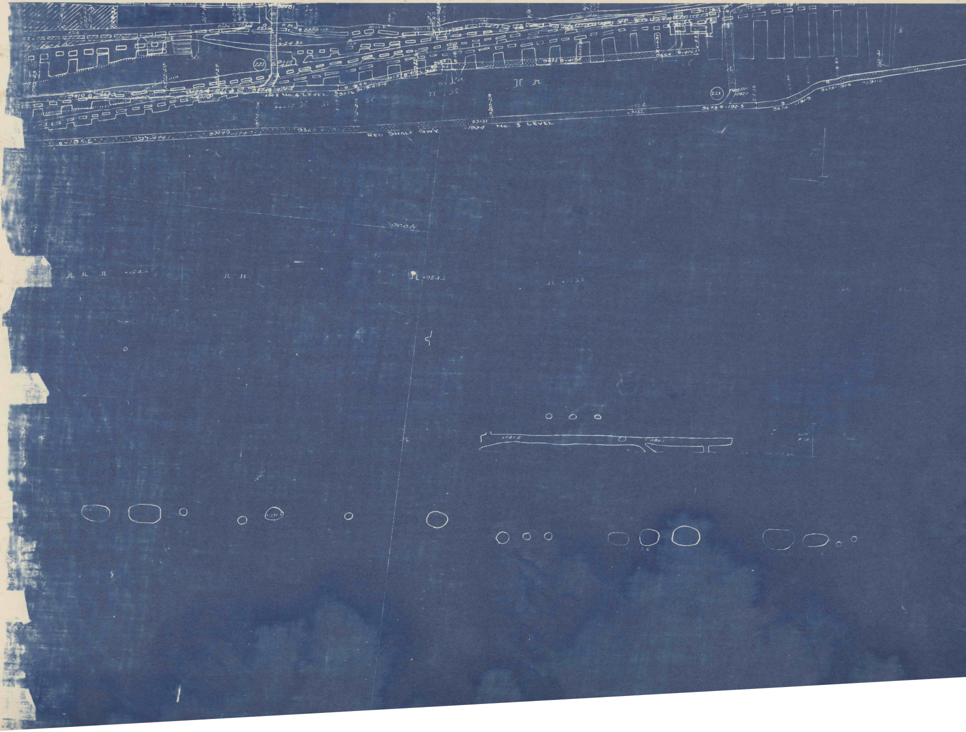

222
221
3-24-30
No. 4 LEVEL
No. 3 LEVEL
RED SHALE GWY.
1924
9410
9555
9556
9619-419.4
9621-417.6
9564-416.1
9673-192.3
9675-191.6
9481
9325
9324-174
9323-174.1
-195.6
-192.4
-191.2
3/20-29
3000N

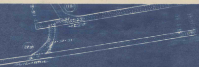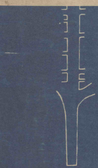
11