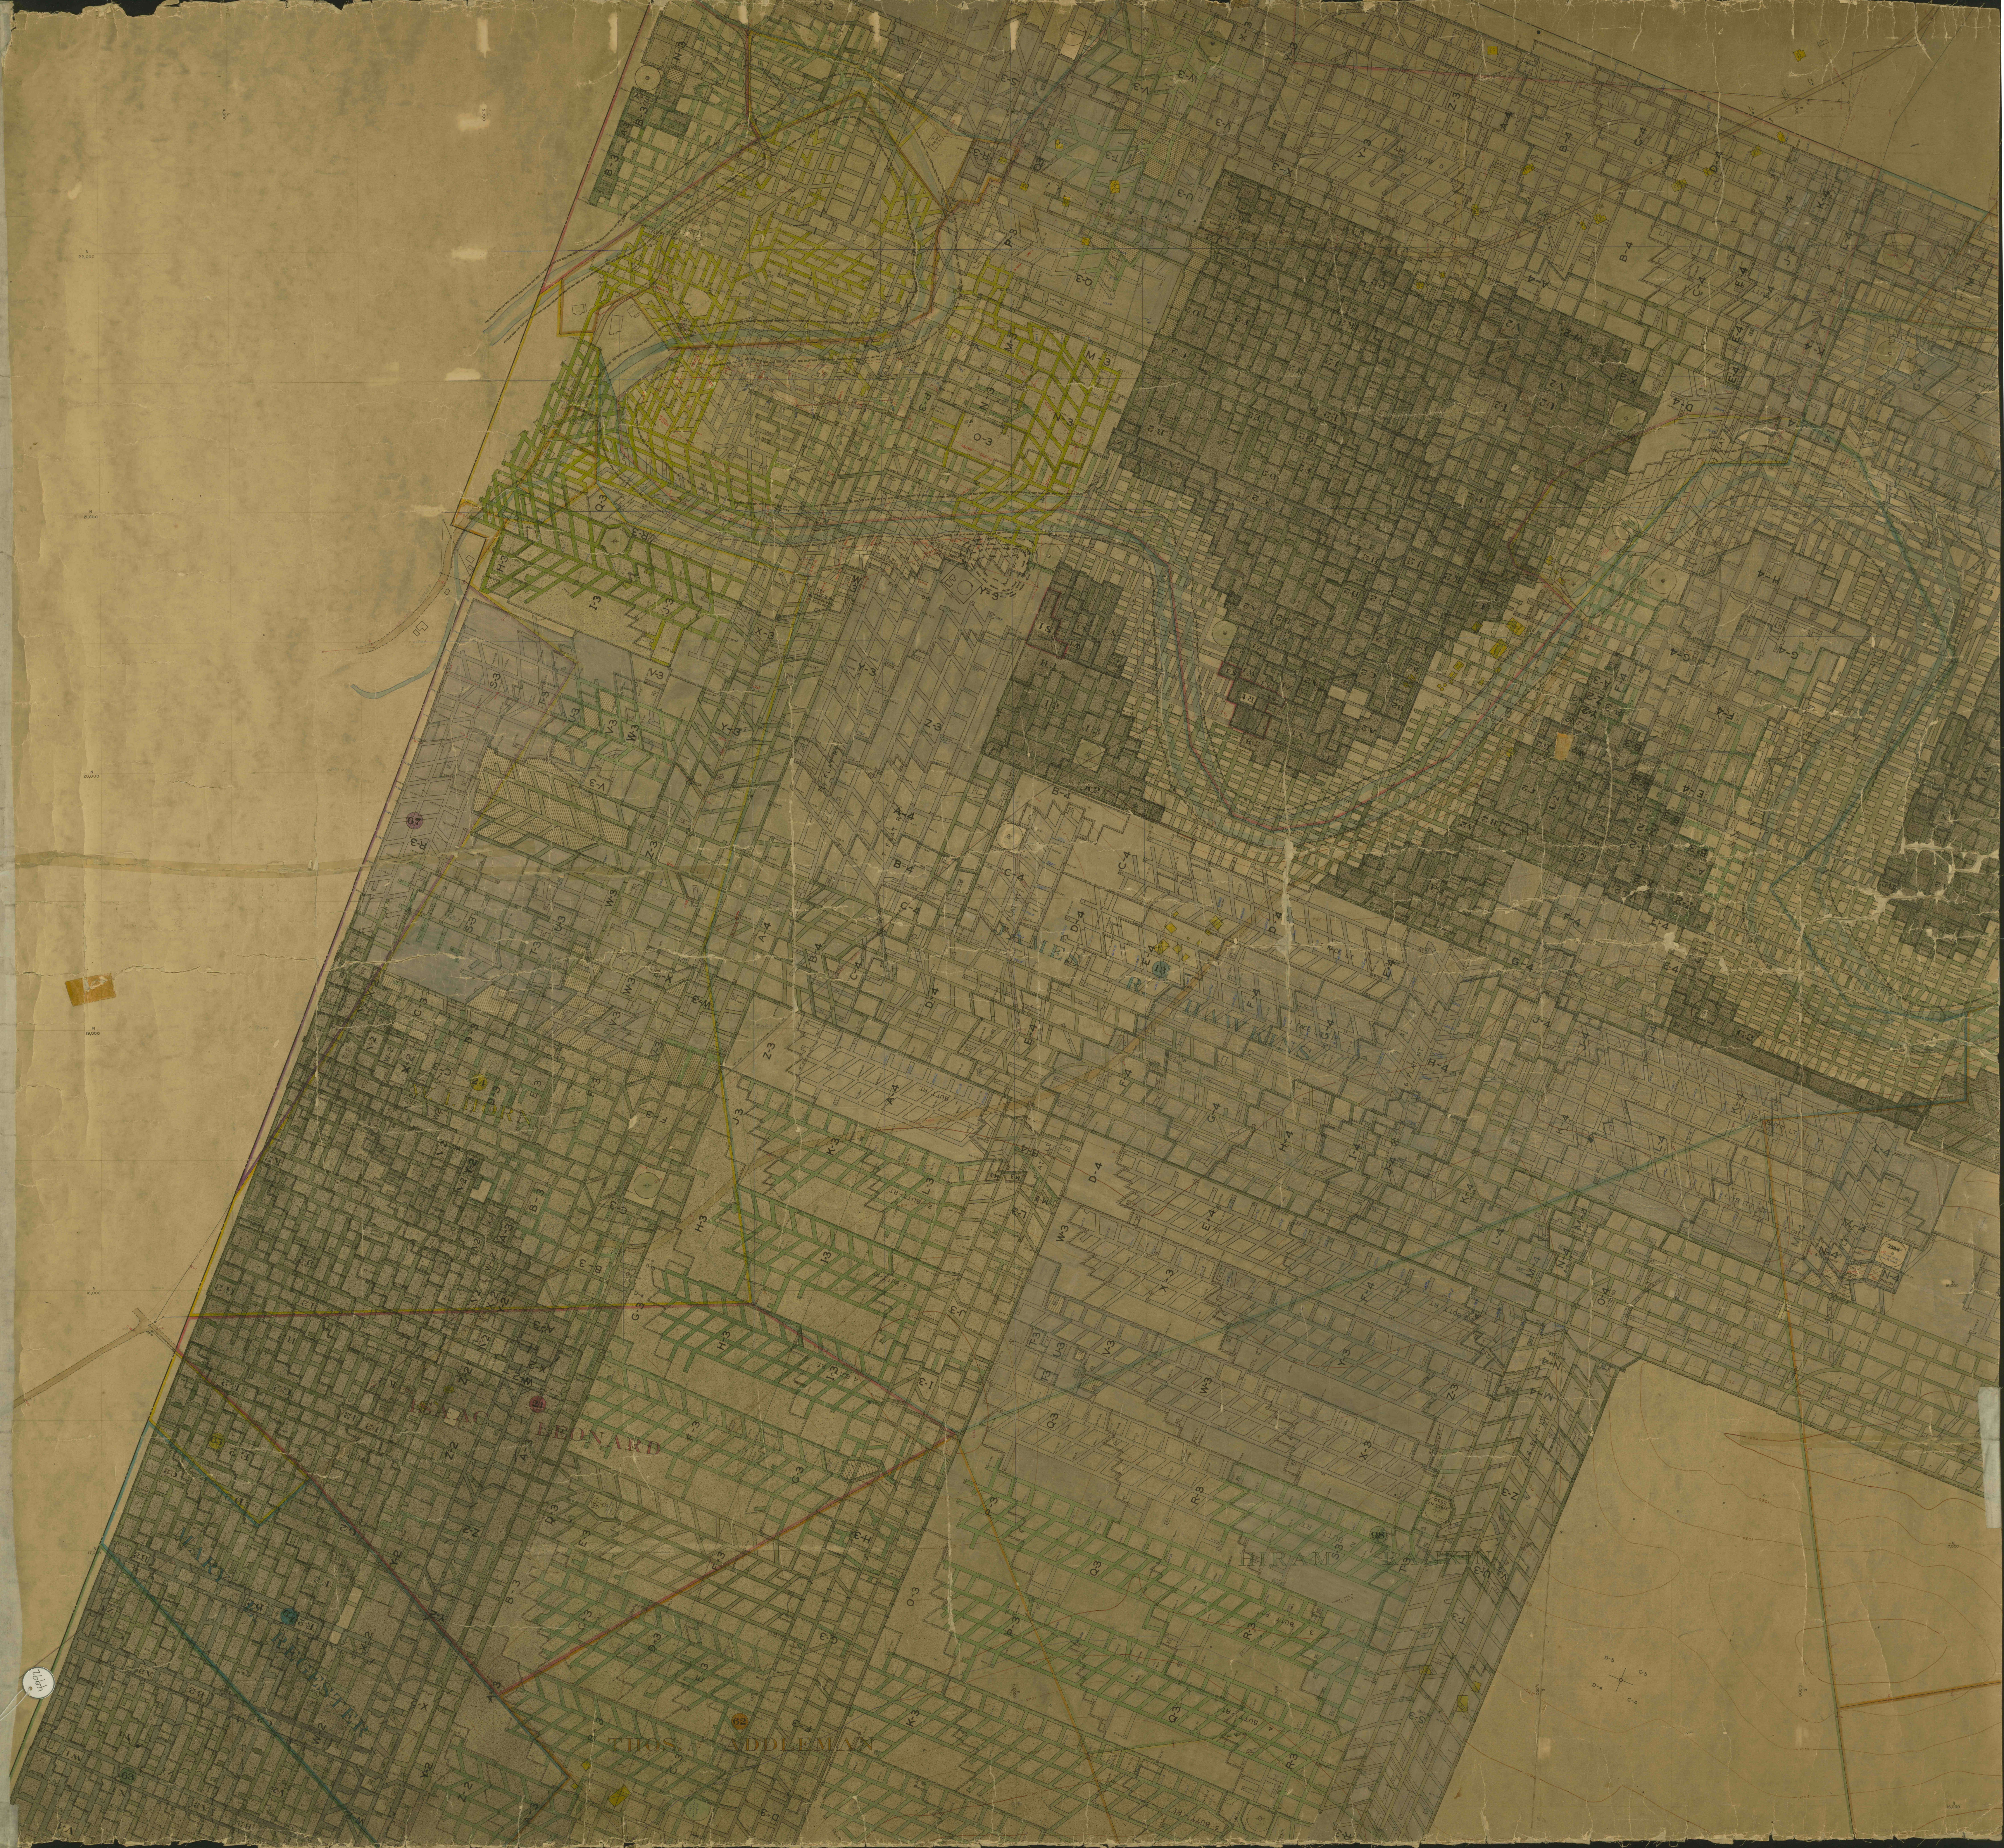
ISAAC LEONARD
THOS. ADDLEMAN
JAMES R. HAWKINS
HIRAM RANKIN
MARY E. REGESTER
21
62
18
98
63
64
55
N 17,000

4692