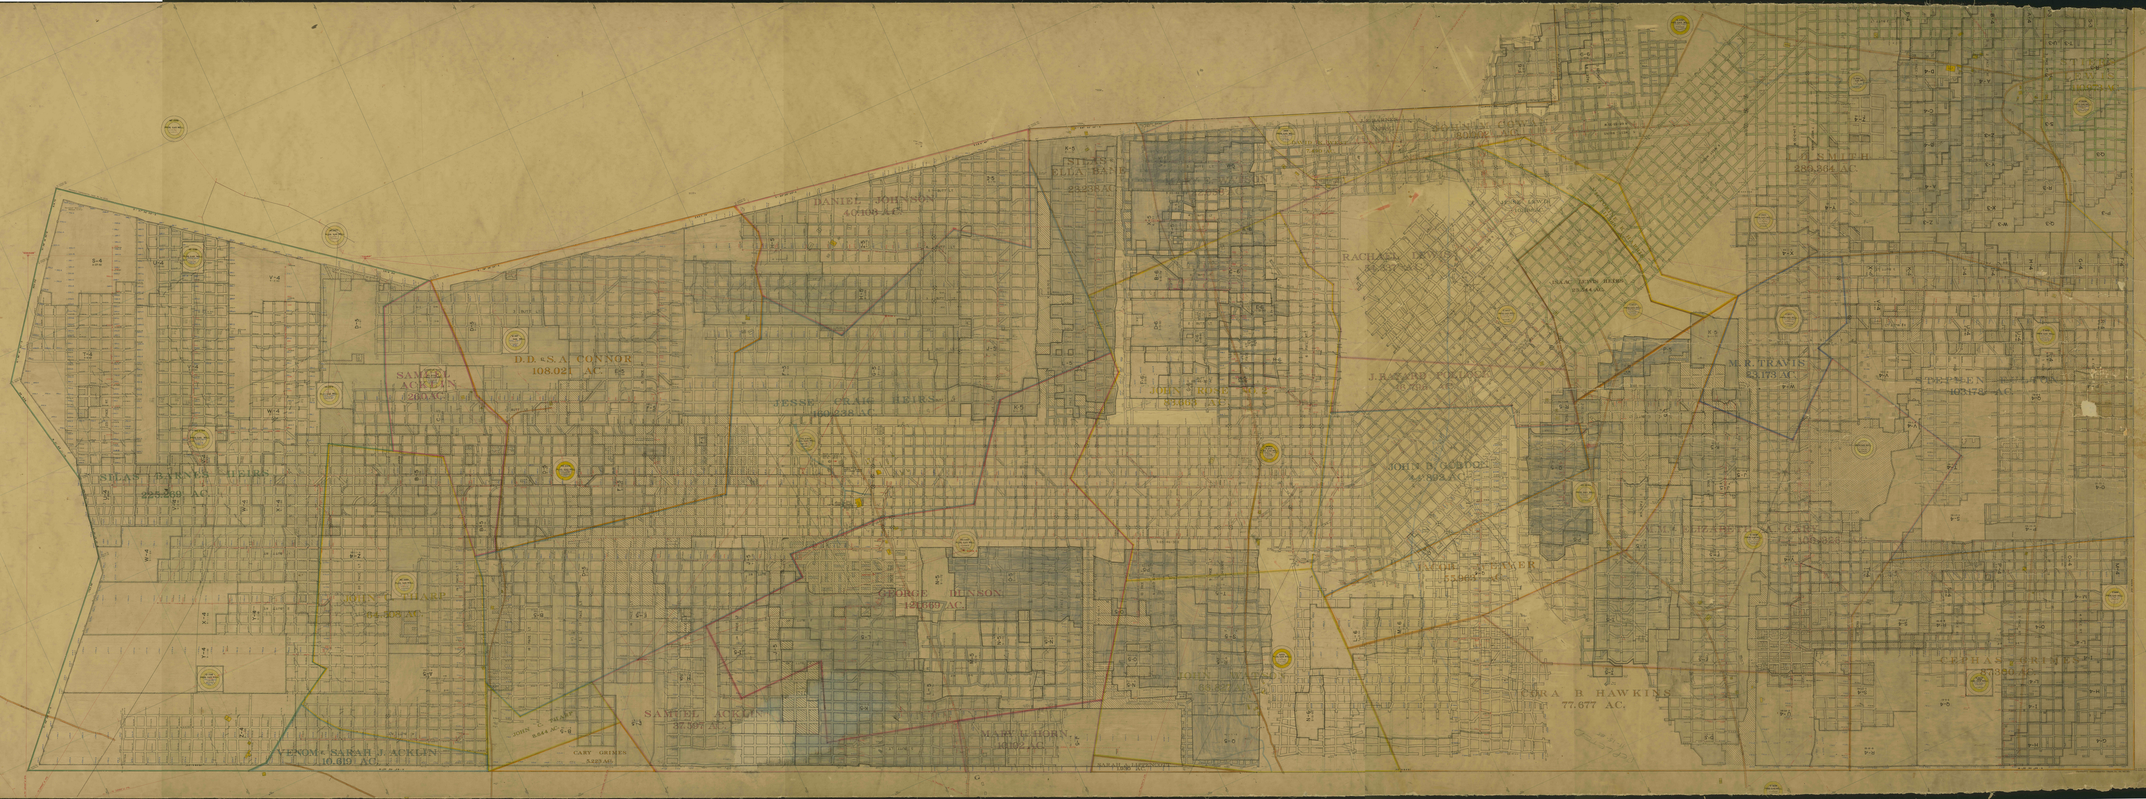

DANIEL JOHNSON
4.0109 AC.
ELIAS BARNES
23.238 AC.
RACHAEL LOWE
SAMUEL ACKLIN
120 AC.
D.D. & S.A. CONNOR
108.021 AC.
JESSE CRAIG HEIRS
150.238 AC.
JOHN B. GEORGE
4.782 AC.
J. RACHEL FOLAND
10.008 AC.
M.R. TRAVIS
3.173 AC.
G.L. SMITH
250.804 AC.
SILAS BARNES HEIRS
225.209 AC.
GEORGE HENSON
123.857 AC.
SAMUEL ACKLIN
27.797 AC.
MARY E. HORN
9.912 AC.
VENOM & SARAH J. ACKLIN
10.619 AC.
CORA B HAWKINS
77.677 AC.