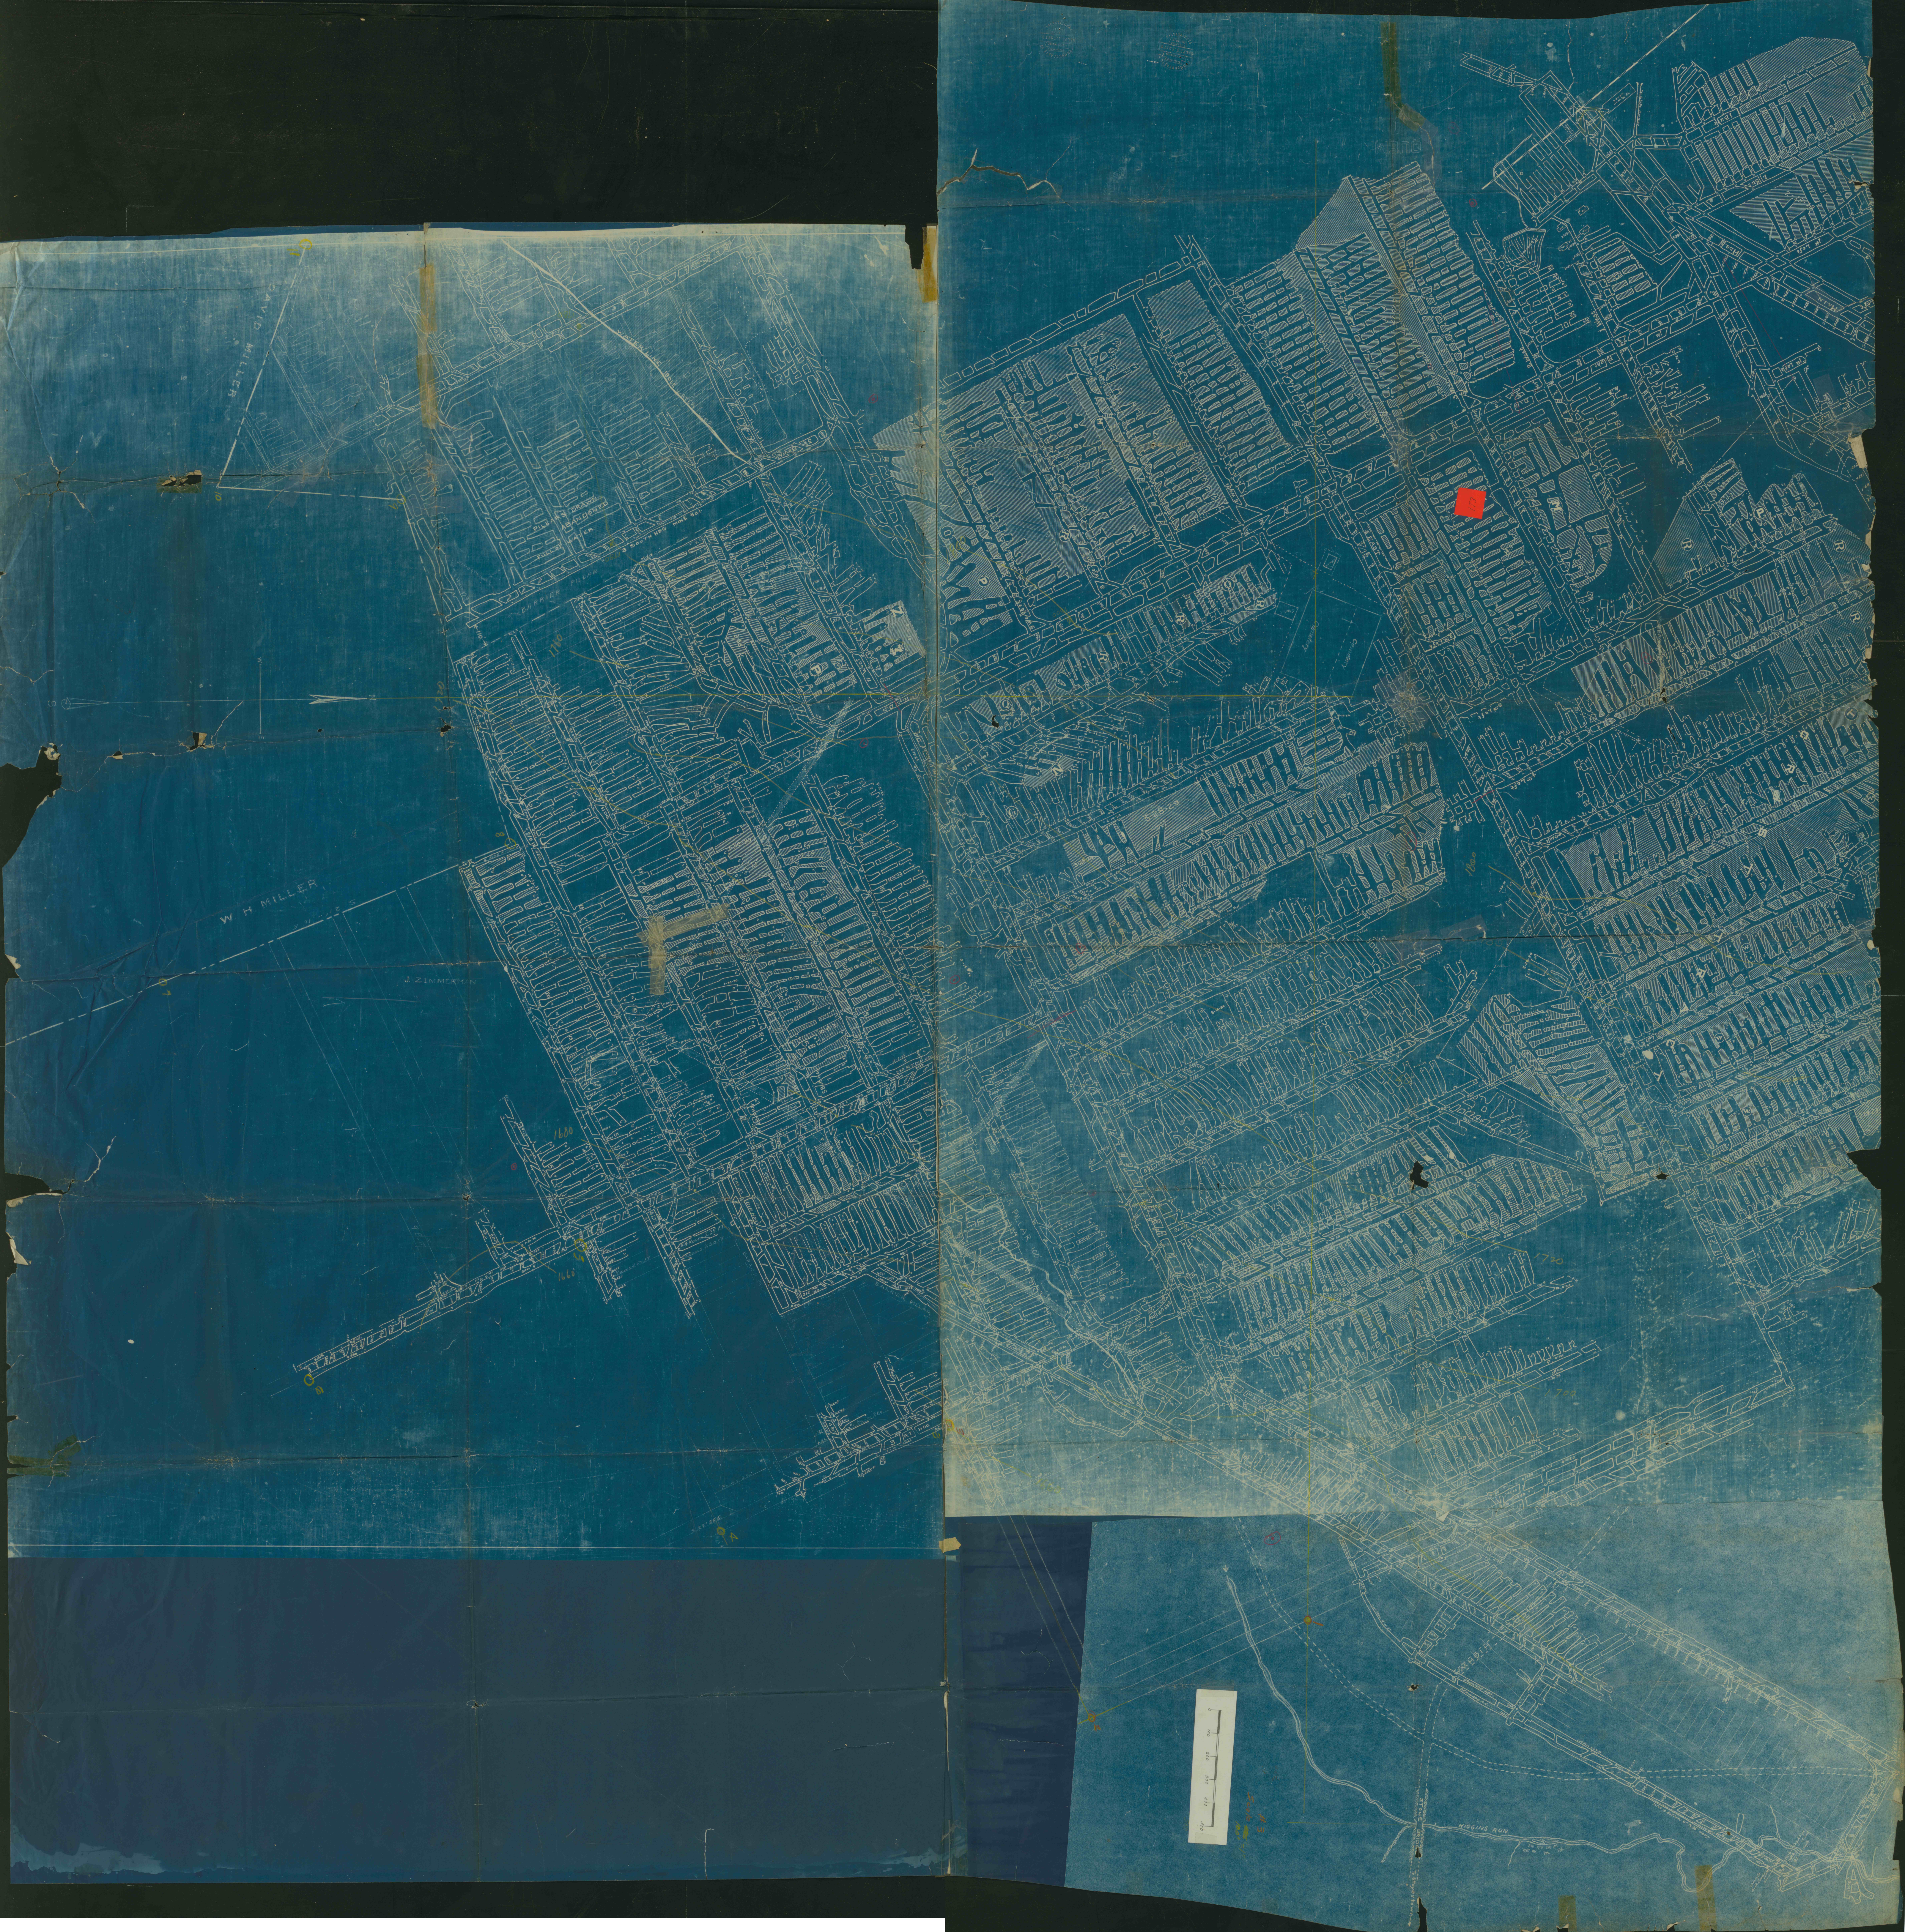
DAVID MILLER
11
10
WATER LINE
PILLARS DRAWN
ABANDONED
FULL OF WATER
3 SOUTH HDG MINE No 1
BARRIER PILLAR
1780
1720
W H MILLER
J. ZIMMERMAN
1680
1660
8
S 25° 25' E
A
3 RT HDG
BARRIER PILLAR
Cemetery
173
1800
1720
1700
HIGGINS RUN
STONE BRIDGE
0
100
200
300
400
500