


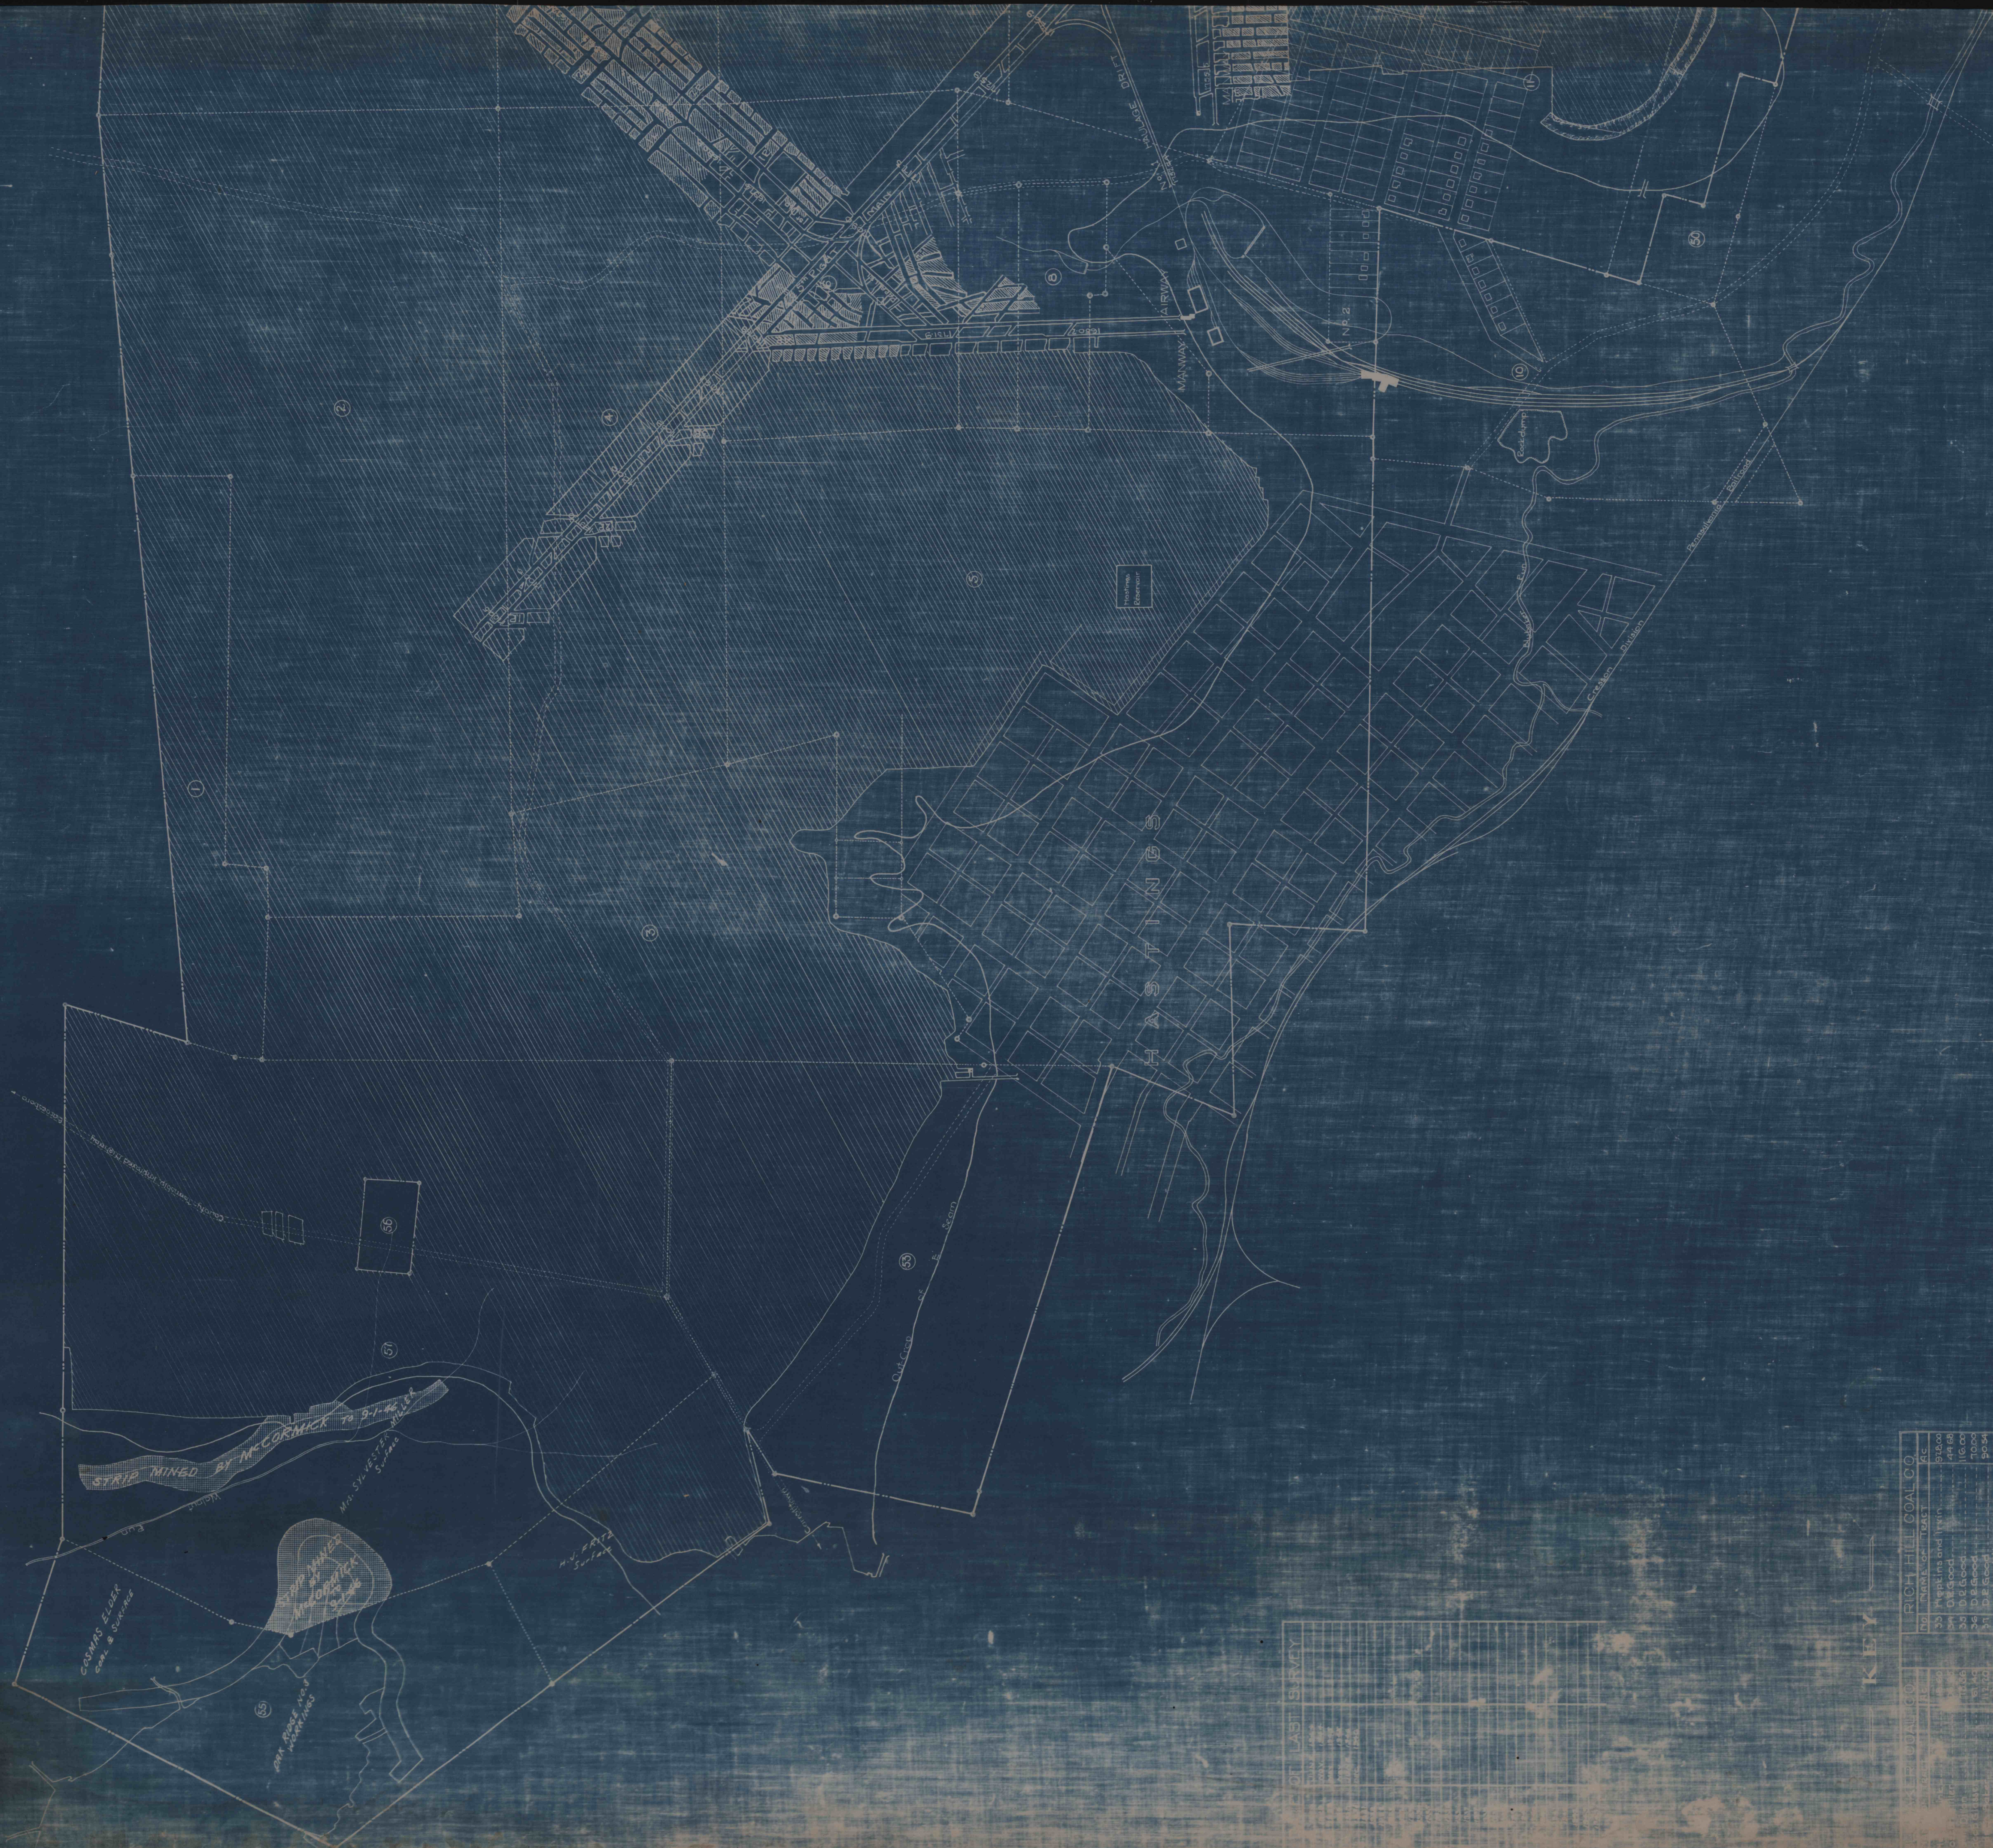

MAP OF
RICH HILL No. 1 MINE
 OPERATED BY
RICH HILL COAL CO.
 HASTINGS, CAMBRIA COUNTY, PENNA.
 E. SEAM


