


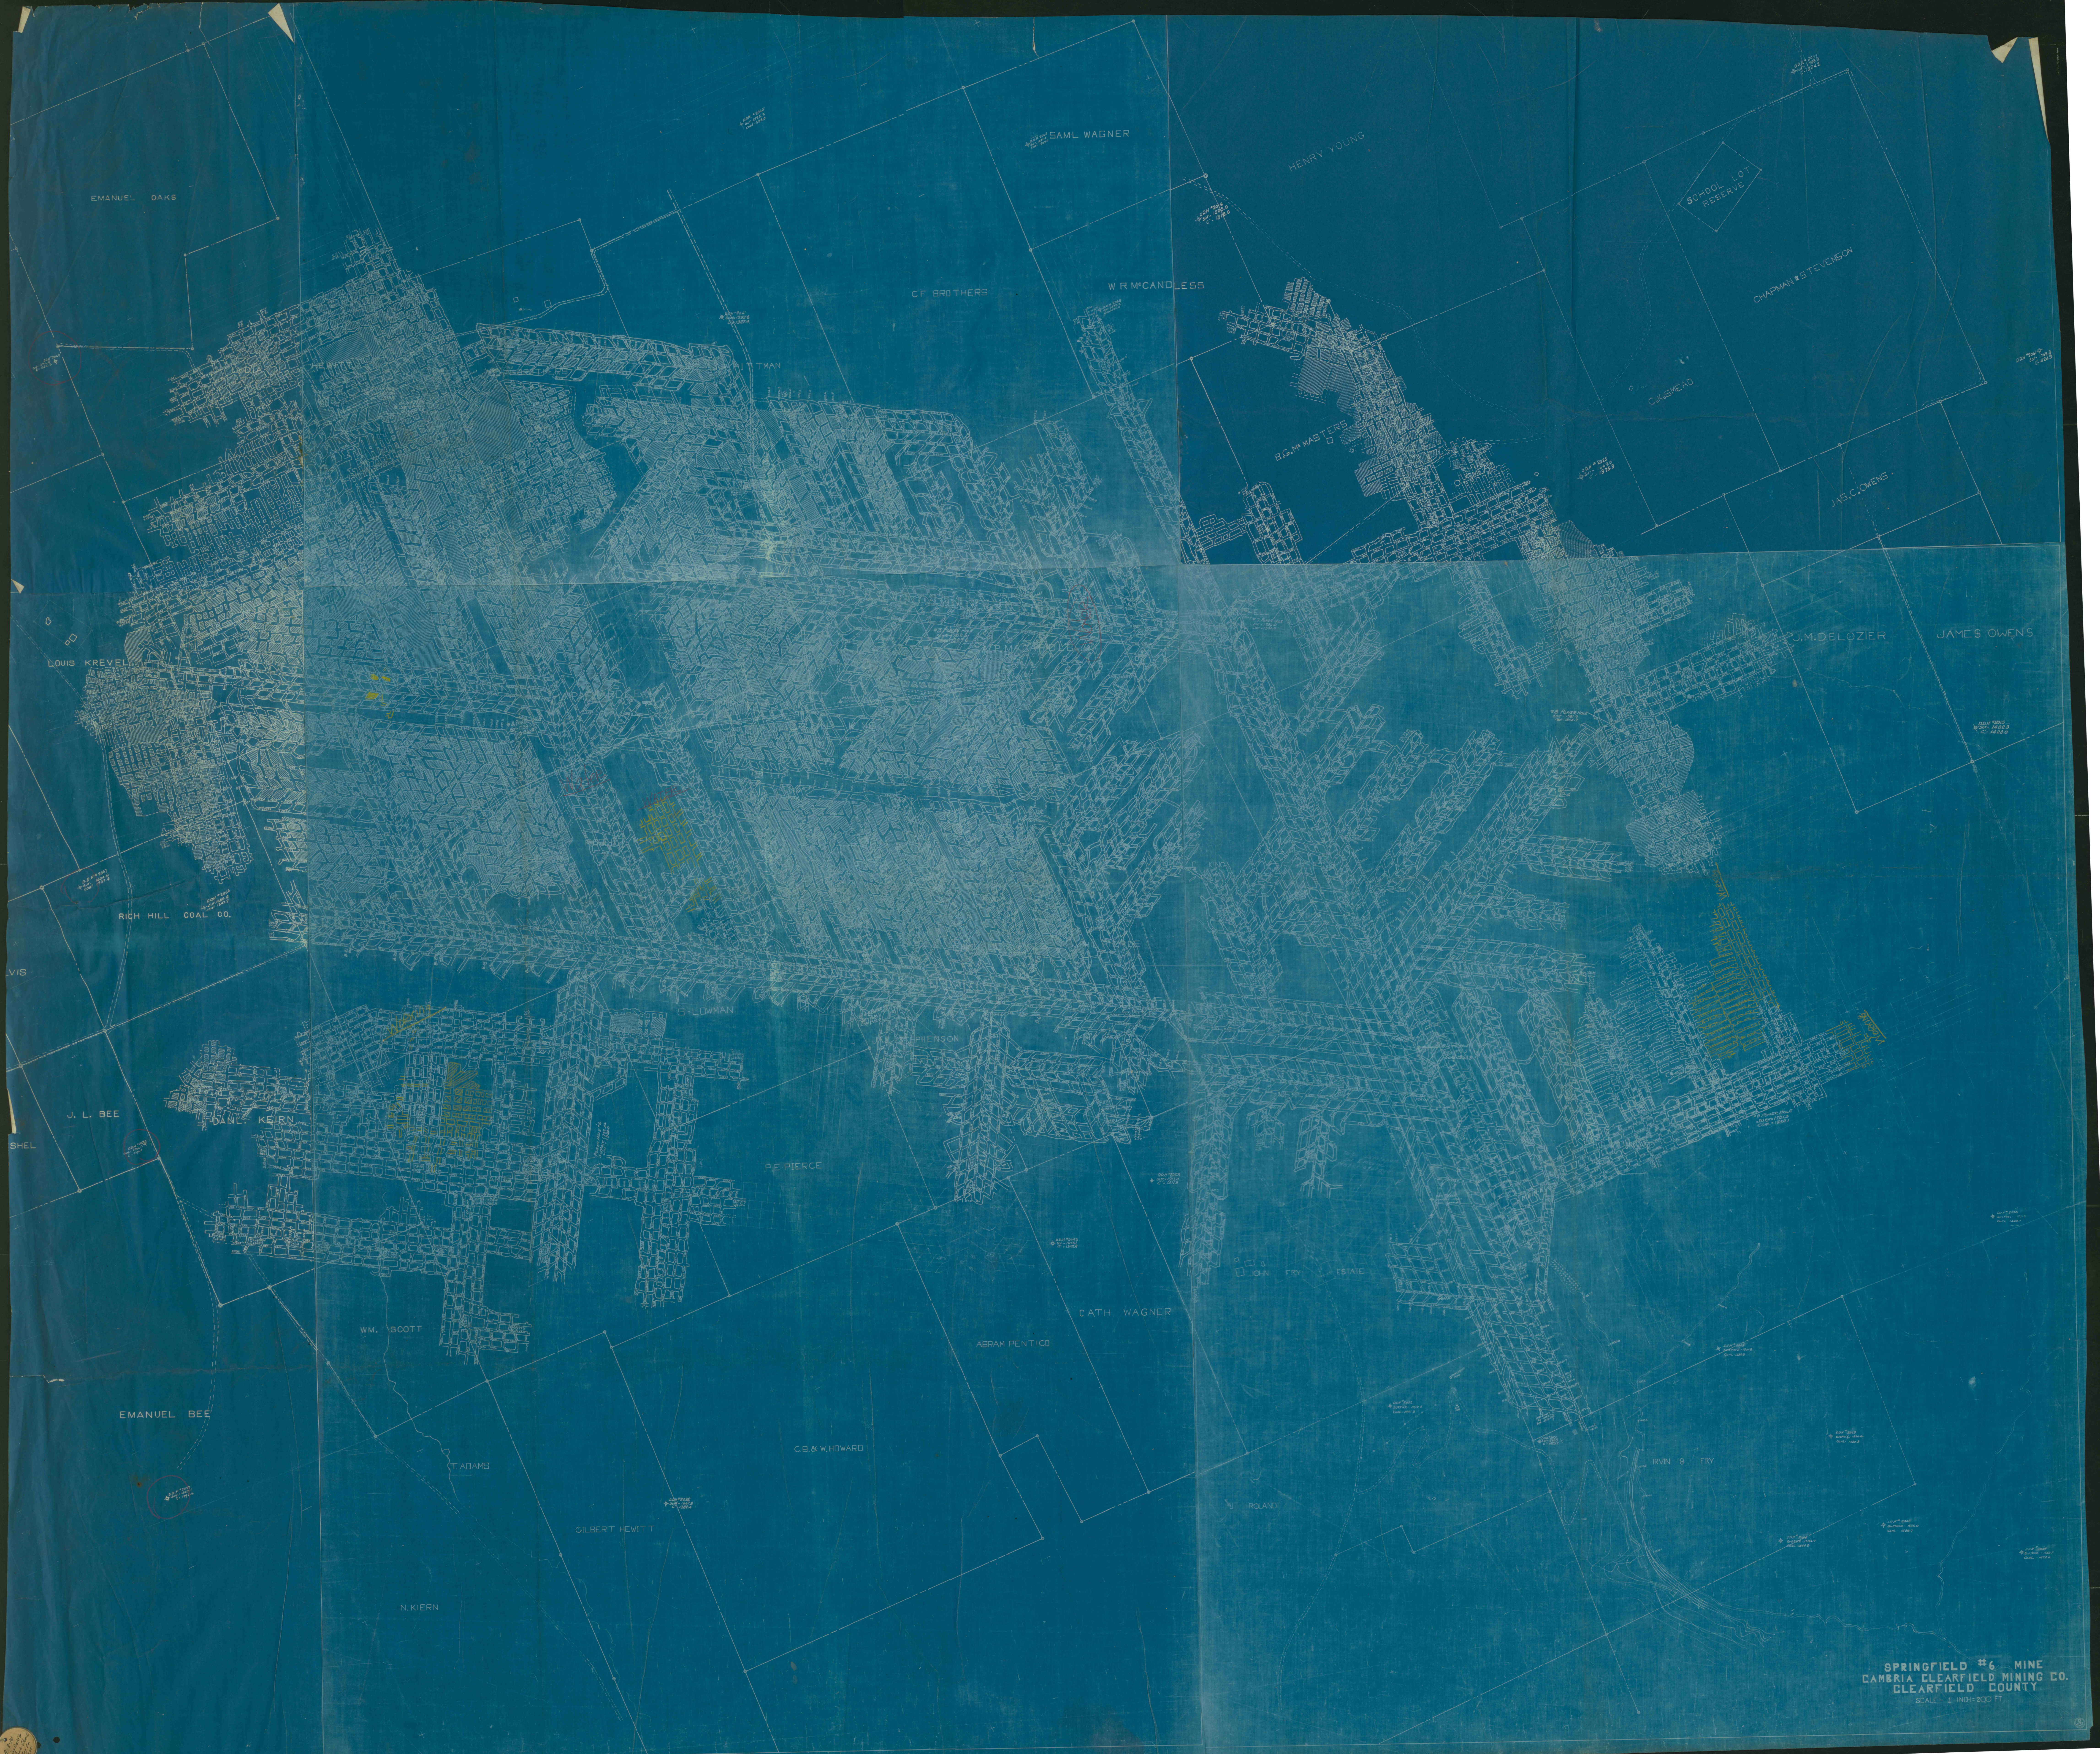

SPRINGFIELD #6 MINE
CAMBRIA CLEARFIELD MINING CO.
CLEARFIELD COUNTY
SCALE - 1" = 400 FT.