


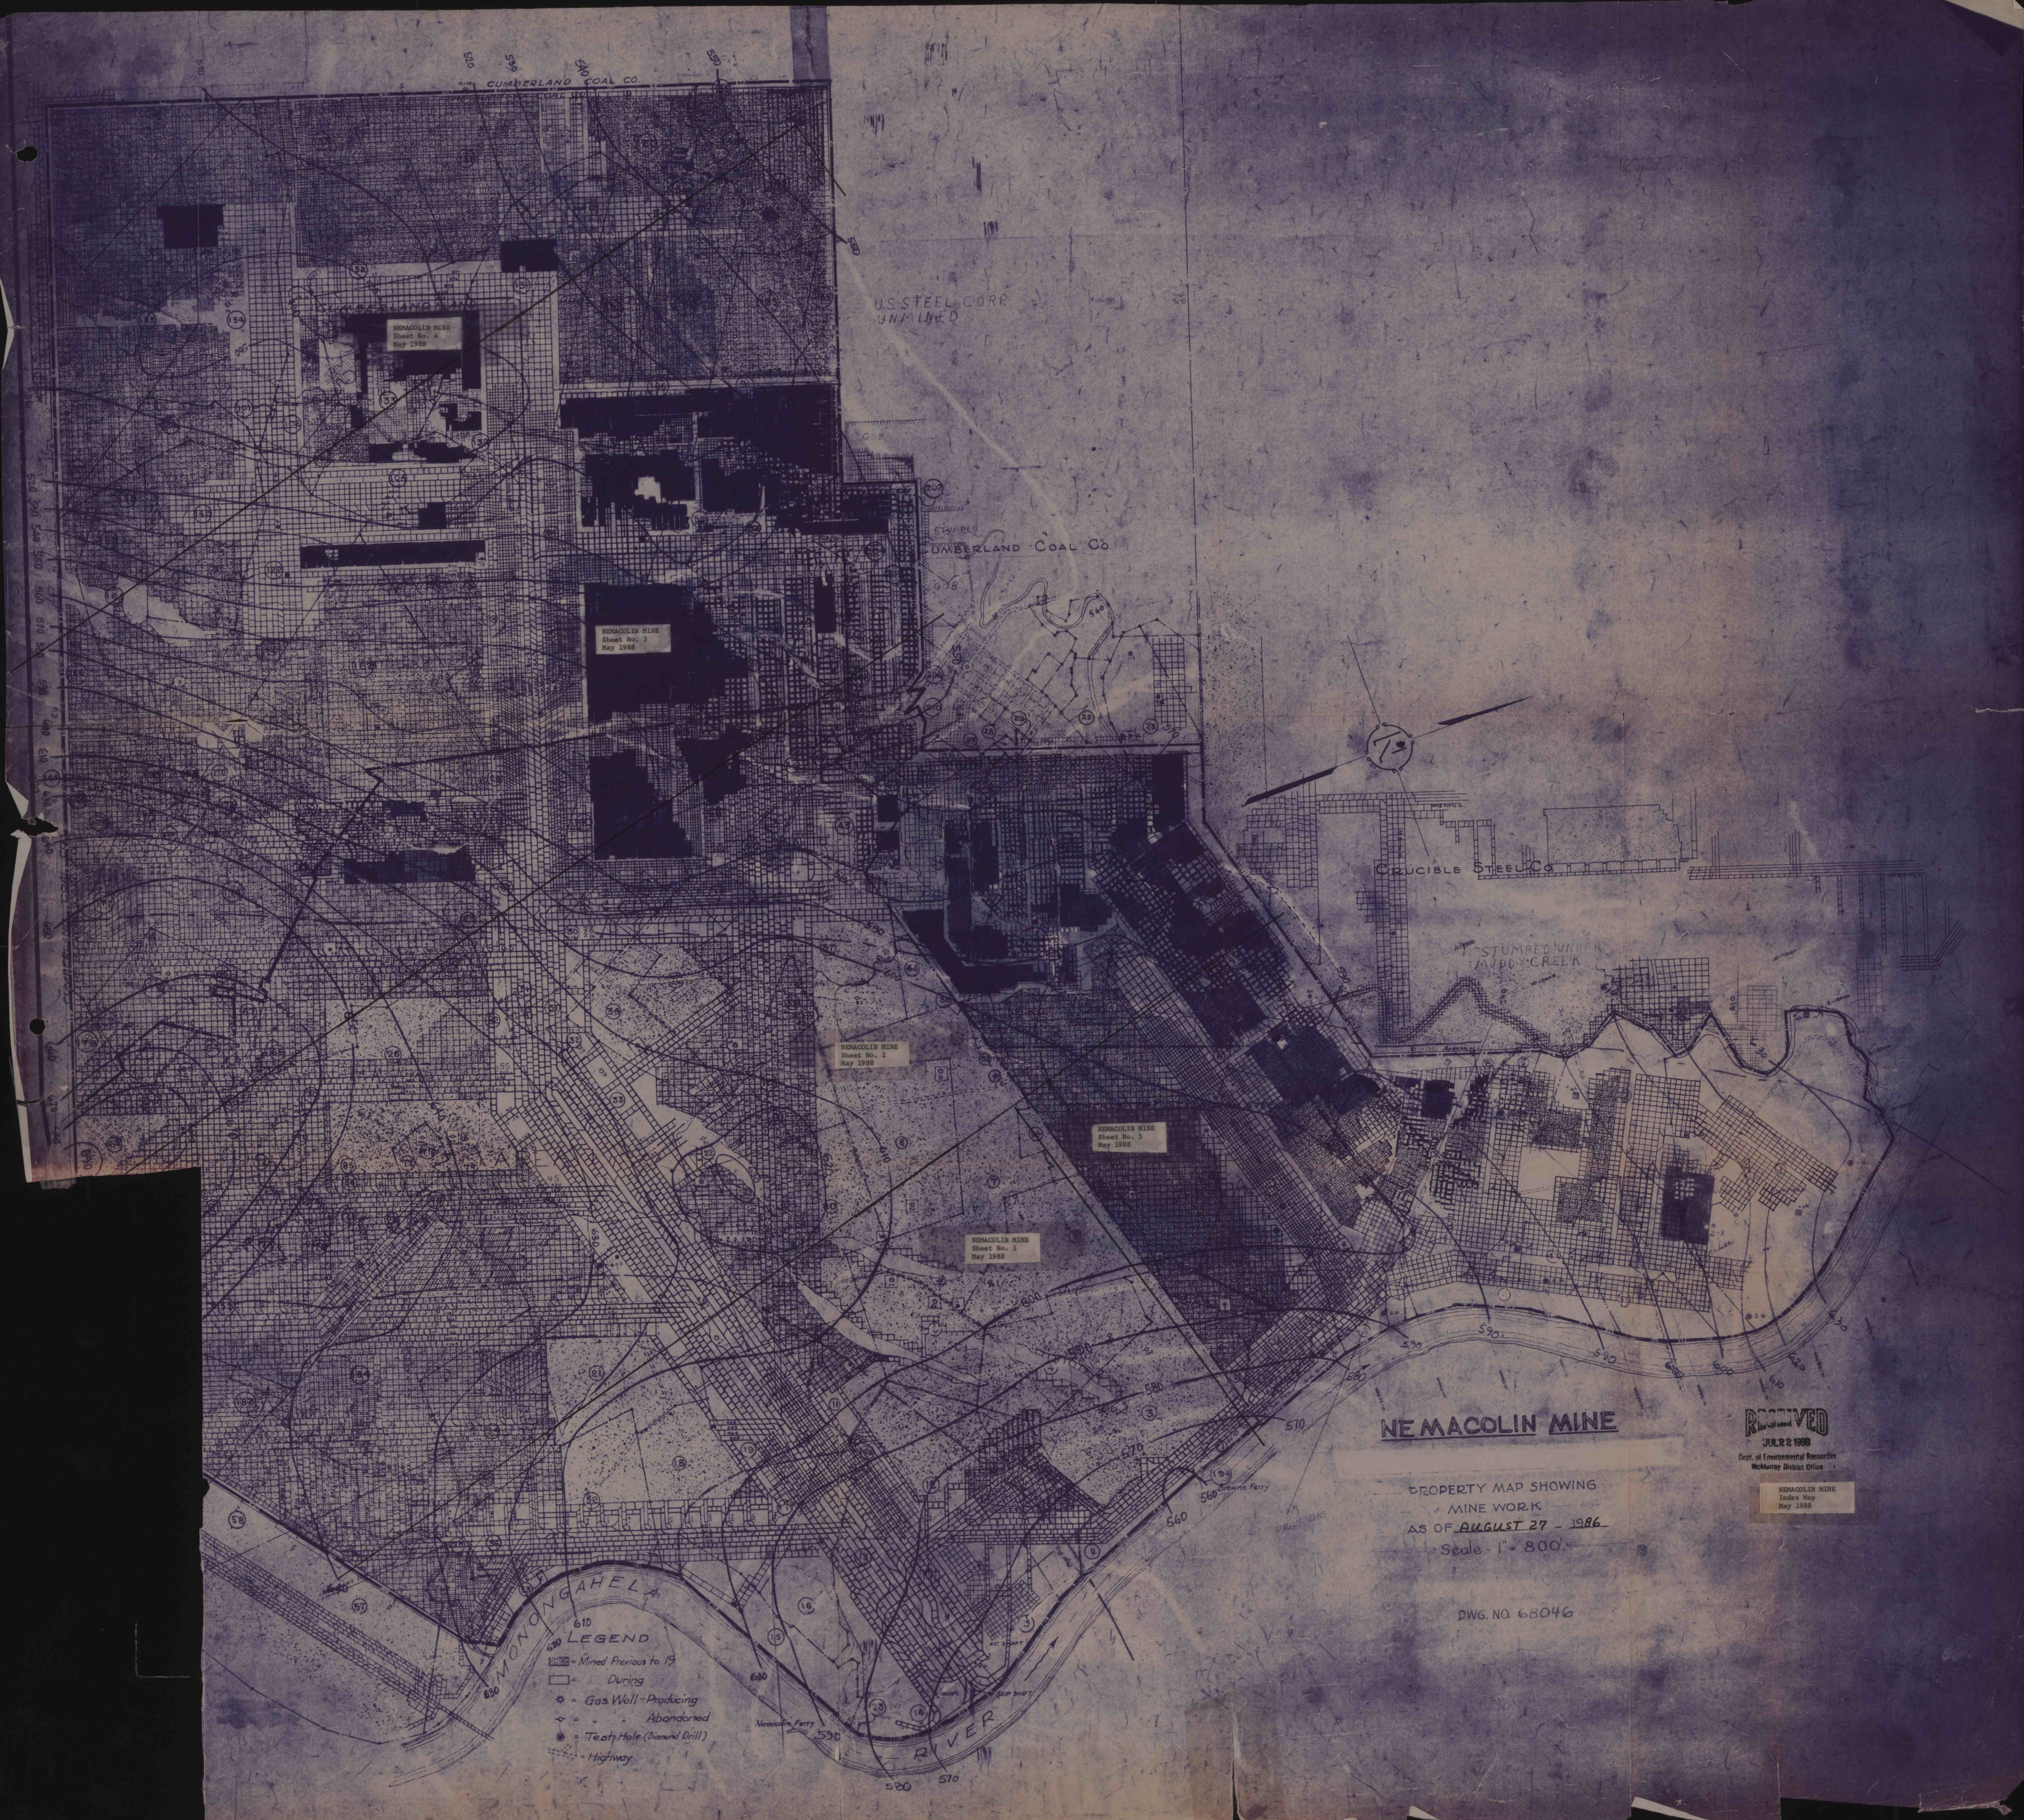

CUMBERLAND COAL CO.

U.S. STEEL CORP.
UNMINE

CUMBERLAND COAL CO.

CRUCIBLE STEEL CO.

STUMPED UNDER
HADDY CREEK

NEMA COLIN MINE

PROPERTY MAP SHOWING
MINE WORK
AS OF AUGUST 27 - 1986
Scale - 1" = 800'

DWG. NO. 68046

- LEGEND**
- ▨ - Mined Previous to 19
 - - During
 - * = Gas Well - Producing
 - = Abandoned
 - = Test Hole (Diamond Drill)
 - = Highway

RECEIVED
JUL 22 1988
Dept. of Environmental Resources
McMurray District Office

NEMA COLIN MINE
Index Map
May 1988