

CUMBERLAND





I CERTIFY THAT THIS IS A TRUE AND
CORRECT COPY OF THE ORIGINAL MINE MAP.
DATE OF MAP: 4-2-64

R. R. RYLAND, REGISTERED
PROFESSIONAL ENGINEER,
#11868-E
DATE: 1-8-70

THE BUCKEYE COAL CO.
NEMACOLIN MINE

GREENE COUNTY MINE MAP
SCALE: 1"=400'
DATE: 7-19-66
DWG. # 66041
SHEET NO. 2
BLOWN UP FROM 800 SCALE MAP
INDEX MAP IS ON SHEET NO. 4

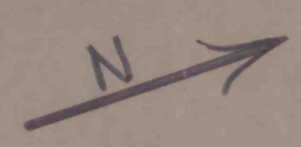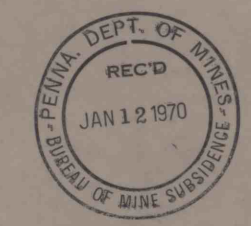

- LEGEND
- [Hatched Box] = Mined Previous to 19
 - [Empty Box] = " During
 - [Star] = Gas Well - Producing
 - [Star with Circle] = " " Abandoned
 - [Circle with Dot] = Test Hole (Diamond Drill)
 - [Double Line] = Highway

MICROFILMED

Nemacolin Ferry

RIVER

AIR SHAFT
SLOPE
SKIP SHAFT