



INDEX MAP	
SHEET NO-3	SHEET NO-4
SHEET NO-2	SHEET NO-1

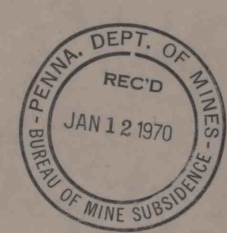

INSERT - A
SCALE 1"=100'
NOTE - ALL NO. PREFIX
BY NO. 0533

AND COAL CO.

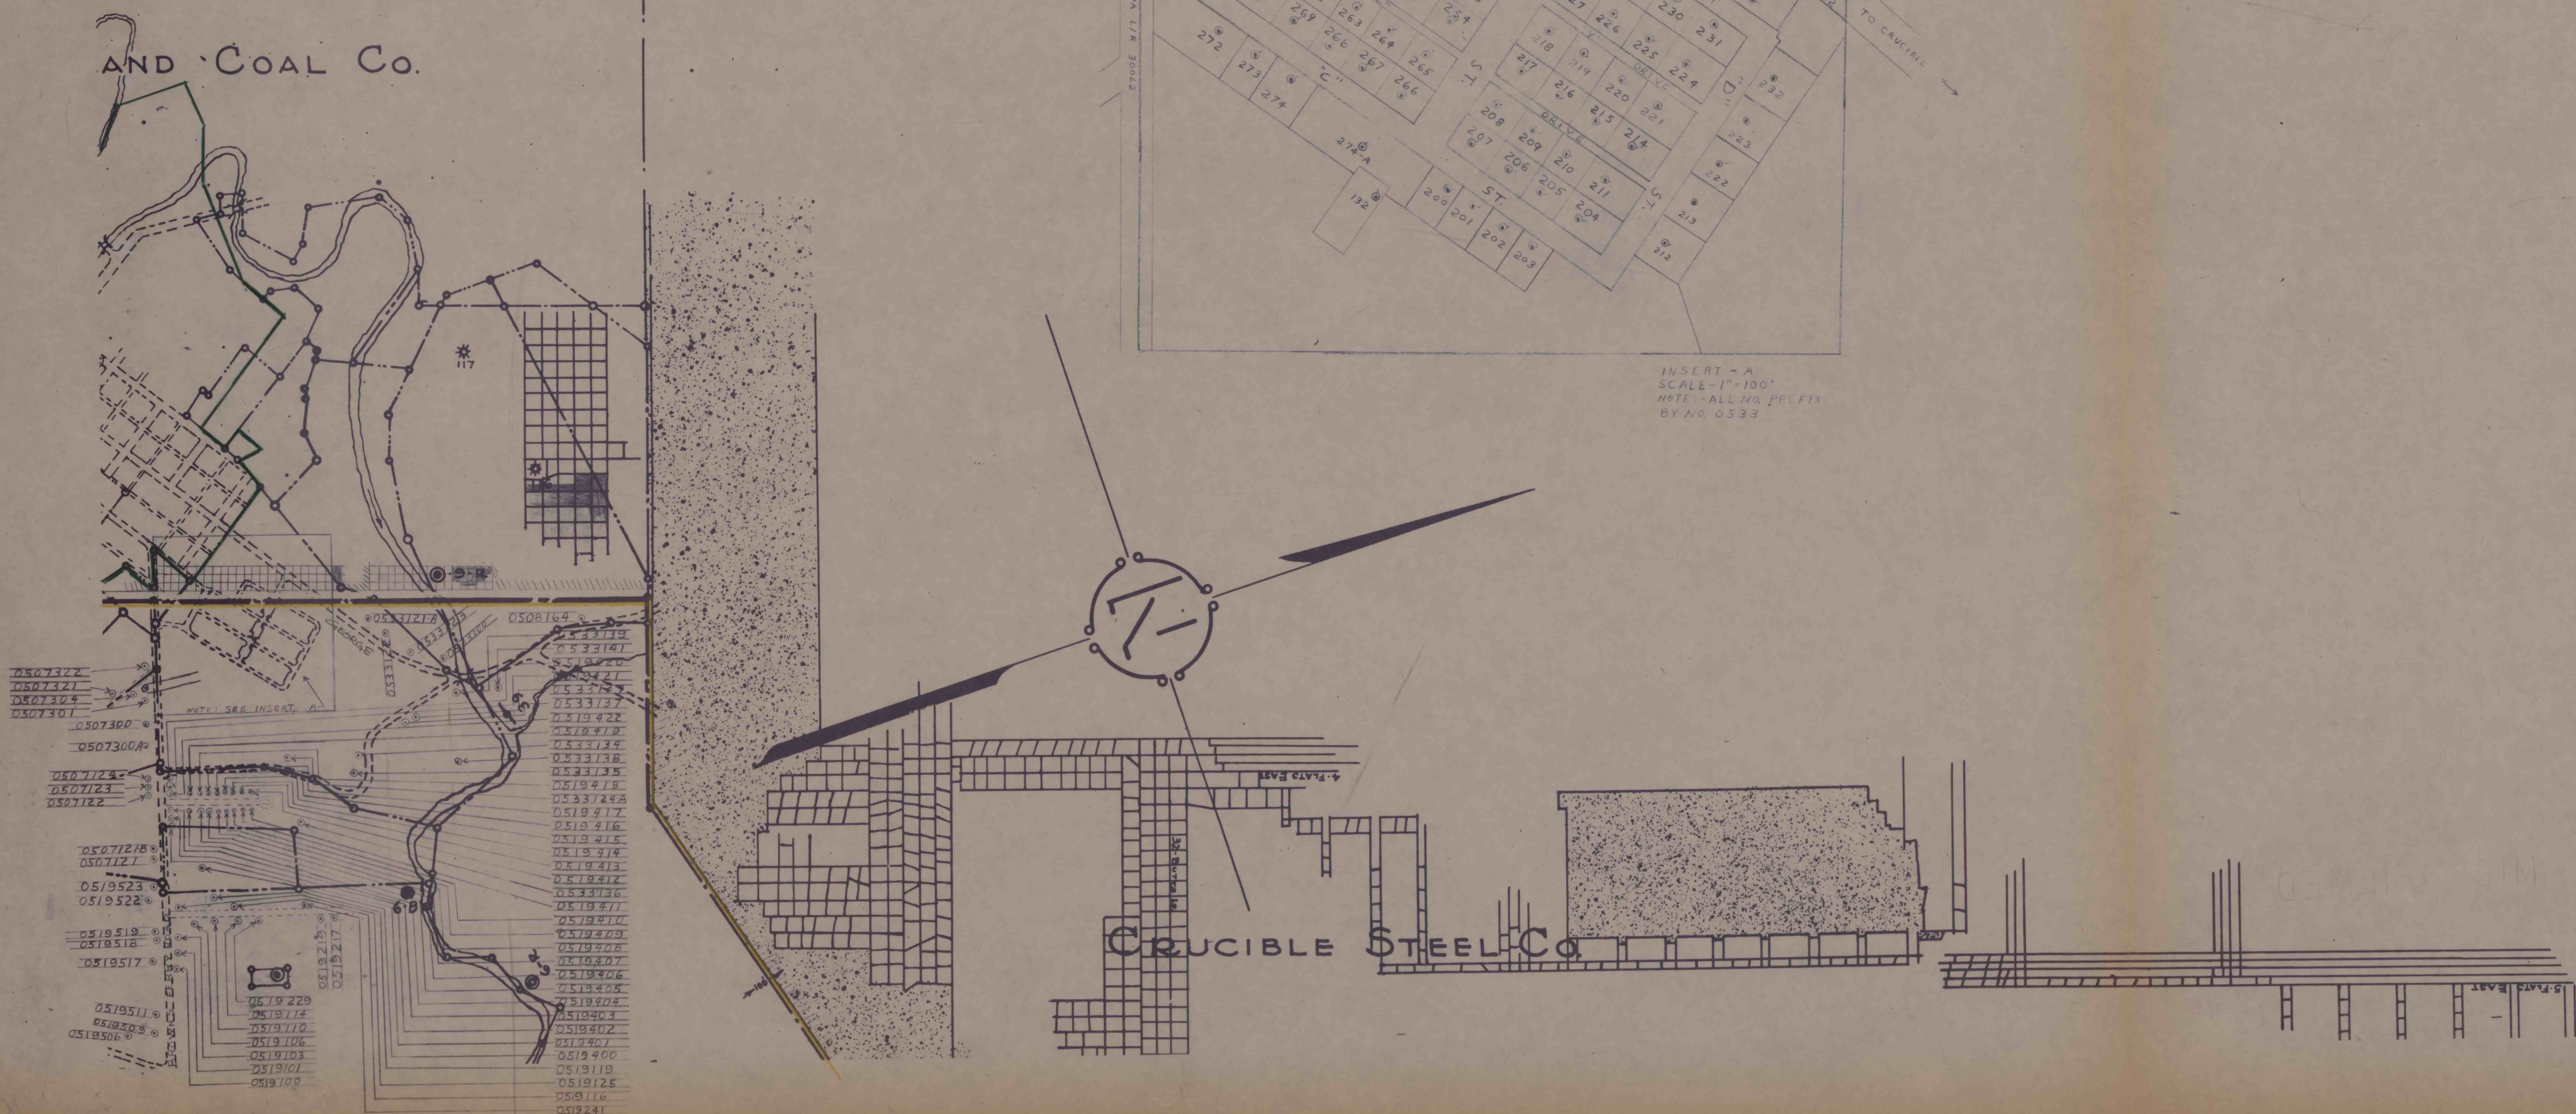

I CERTIFY THAT THIS IS A TRUE AND
CORRECT COPY OF THE ORIGINAL MINING
DATE OF MAP: 4-27-66
R. R. Ryland
R. R. RYLAND, REGISTERED
PROFESSIONAL ENGINEER,
#11865-E
DATE: 4-8-70

THE BUCKEYE COAL CO.
NEMACOLIN MINE

GREENE COUNTY MINE MAP
SCALE: 1"=400'
DATE: 7-19-66
DWG. # 66041
SHEET NO-4
BLOWN UP FROM 800 SCALE MAP
INDEX MAP IS ON SHEET NO-1