


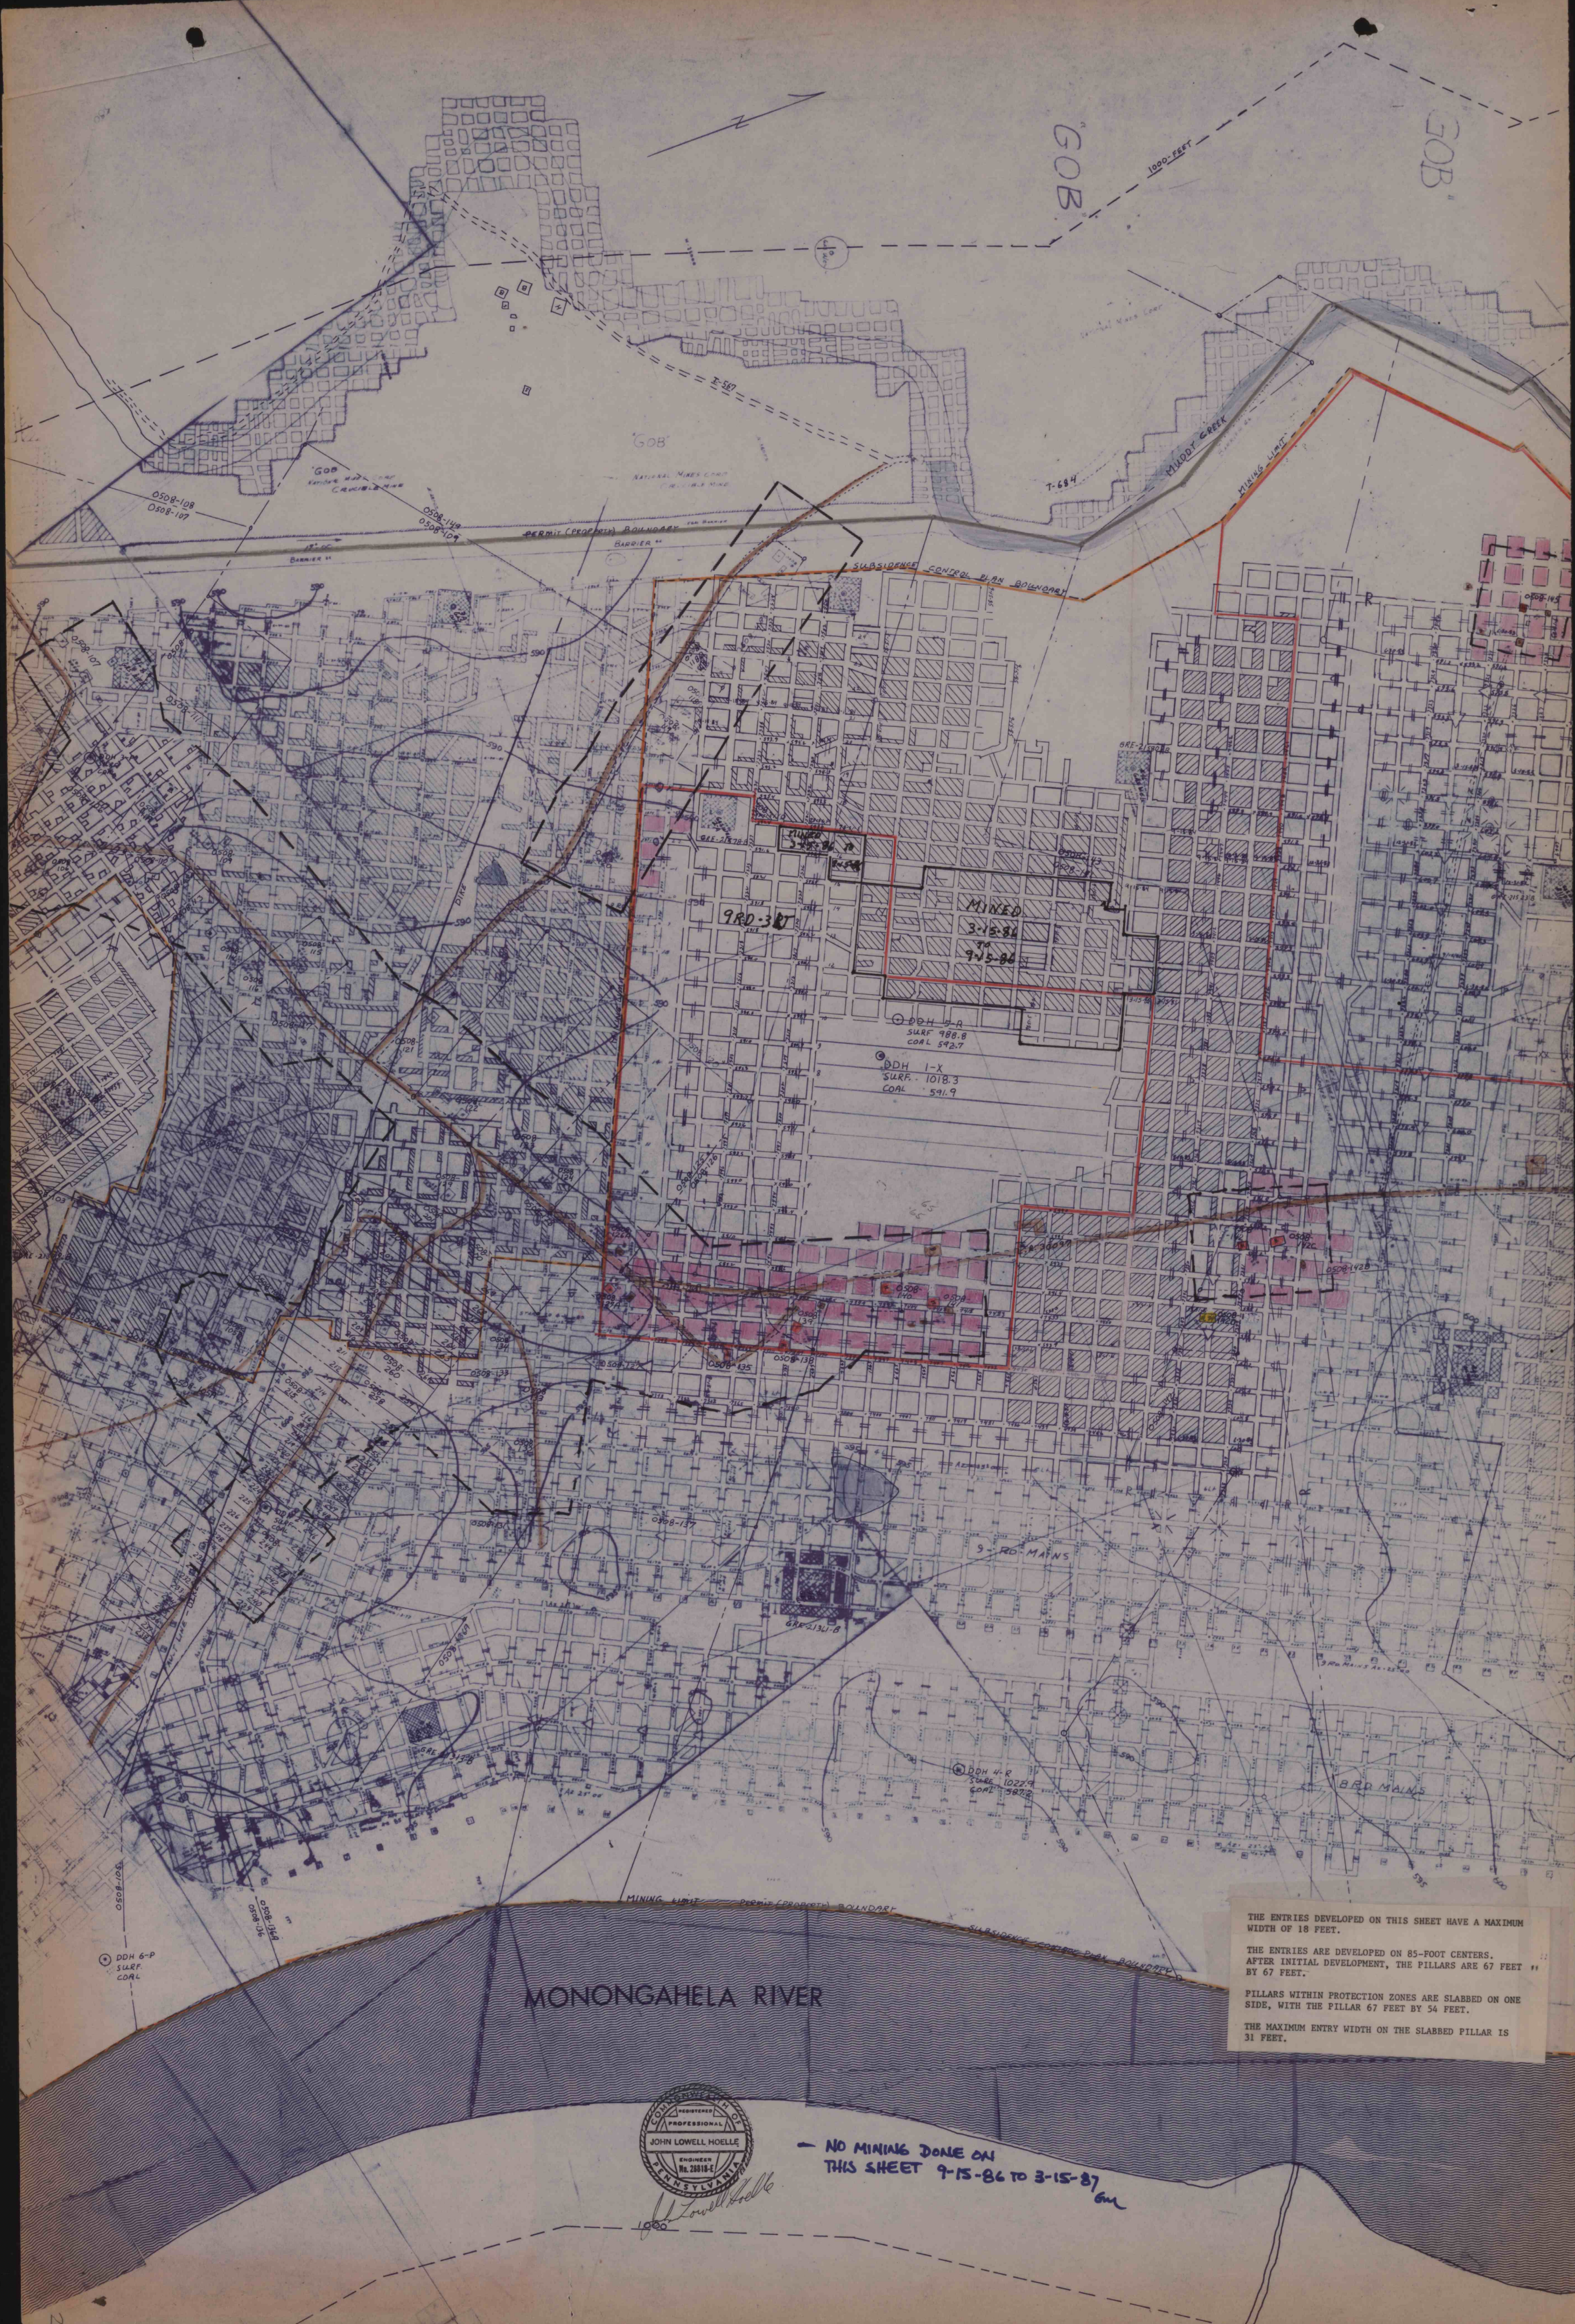

THE ENTRIES DEVELOPED ON THIS SHEET HAVE A MAXIMUM WIDTH OF 18 FEET.

THE ENTRIES ARE DEVELOPED ON 85-FOOT CENTERS. AFTER INITIAL DEVELOPMENT, THE PILLARS ARE 67 FEET BY 67 FEET.

PILLARS WITHIN PROTECTION ZONES ARE SLABBED ON ONE SIDE, WITH THE PILLAR 67 FEET BY 54 FEET.

THE MAXIMUM ENTRY WIDTH ON THE SLABBED PILLAR IS 31 FEET.

MONONGAHELA RIVER



NO MINING DONE ON THIS SHEET 7-15-86 TO 3-15-87