


3-15-86 TO 9-15-86 3

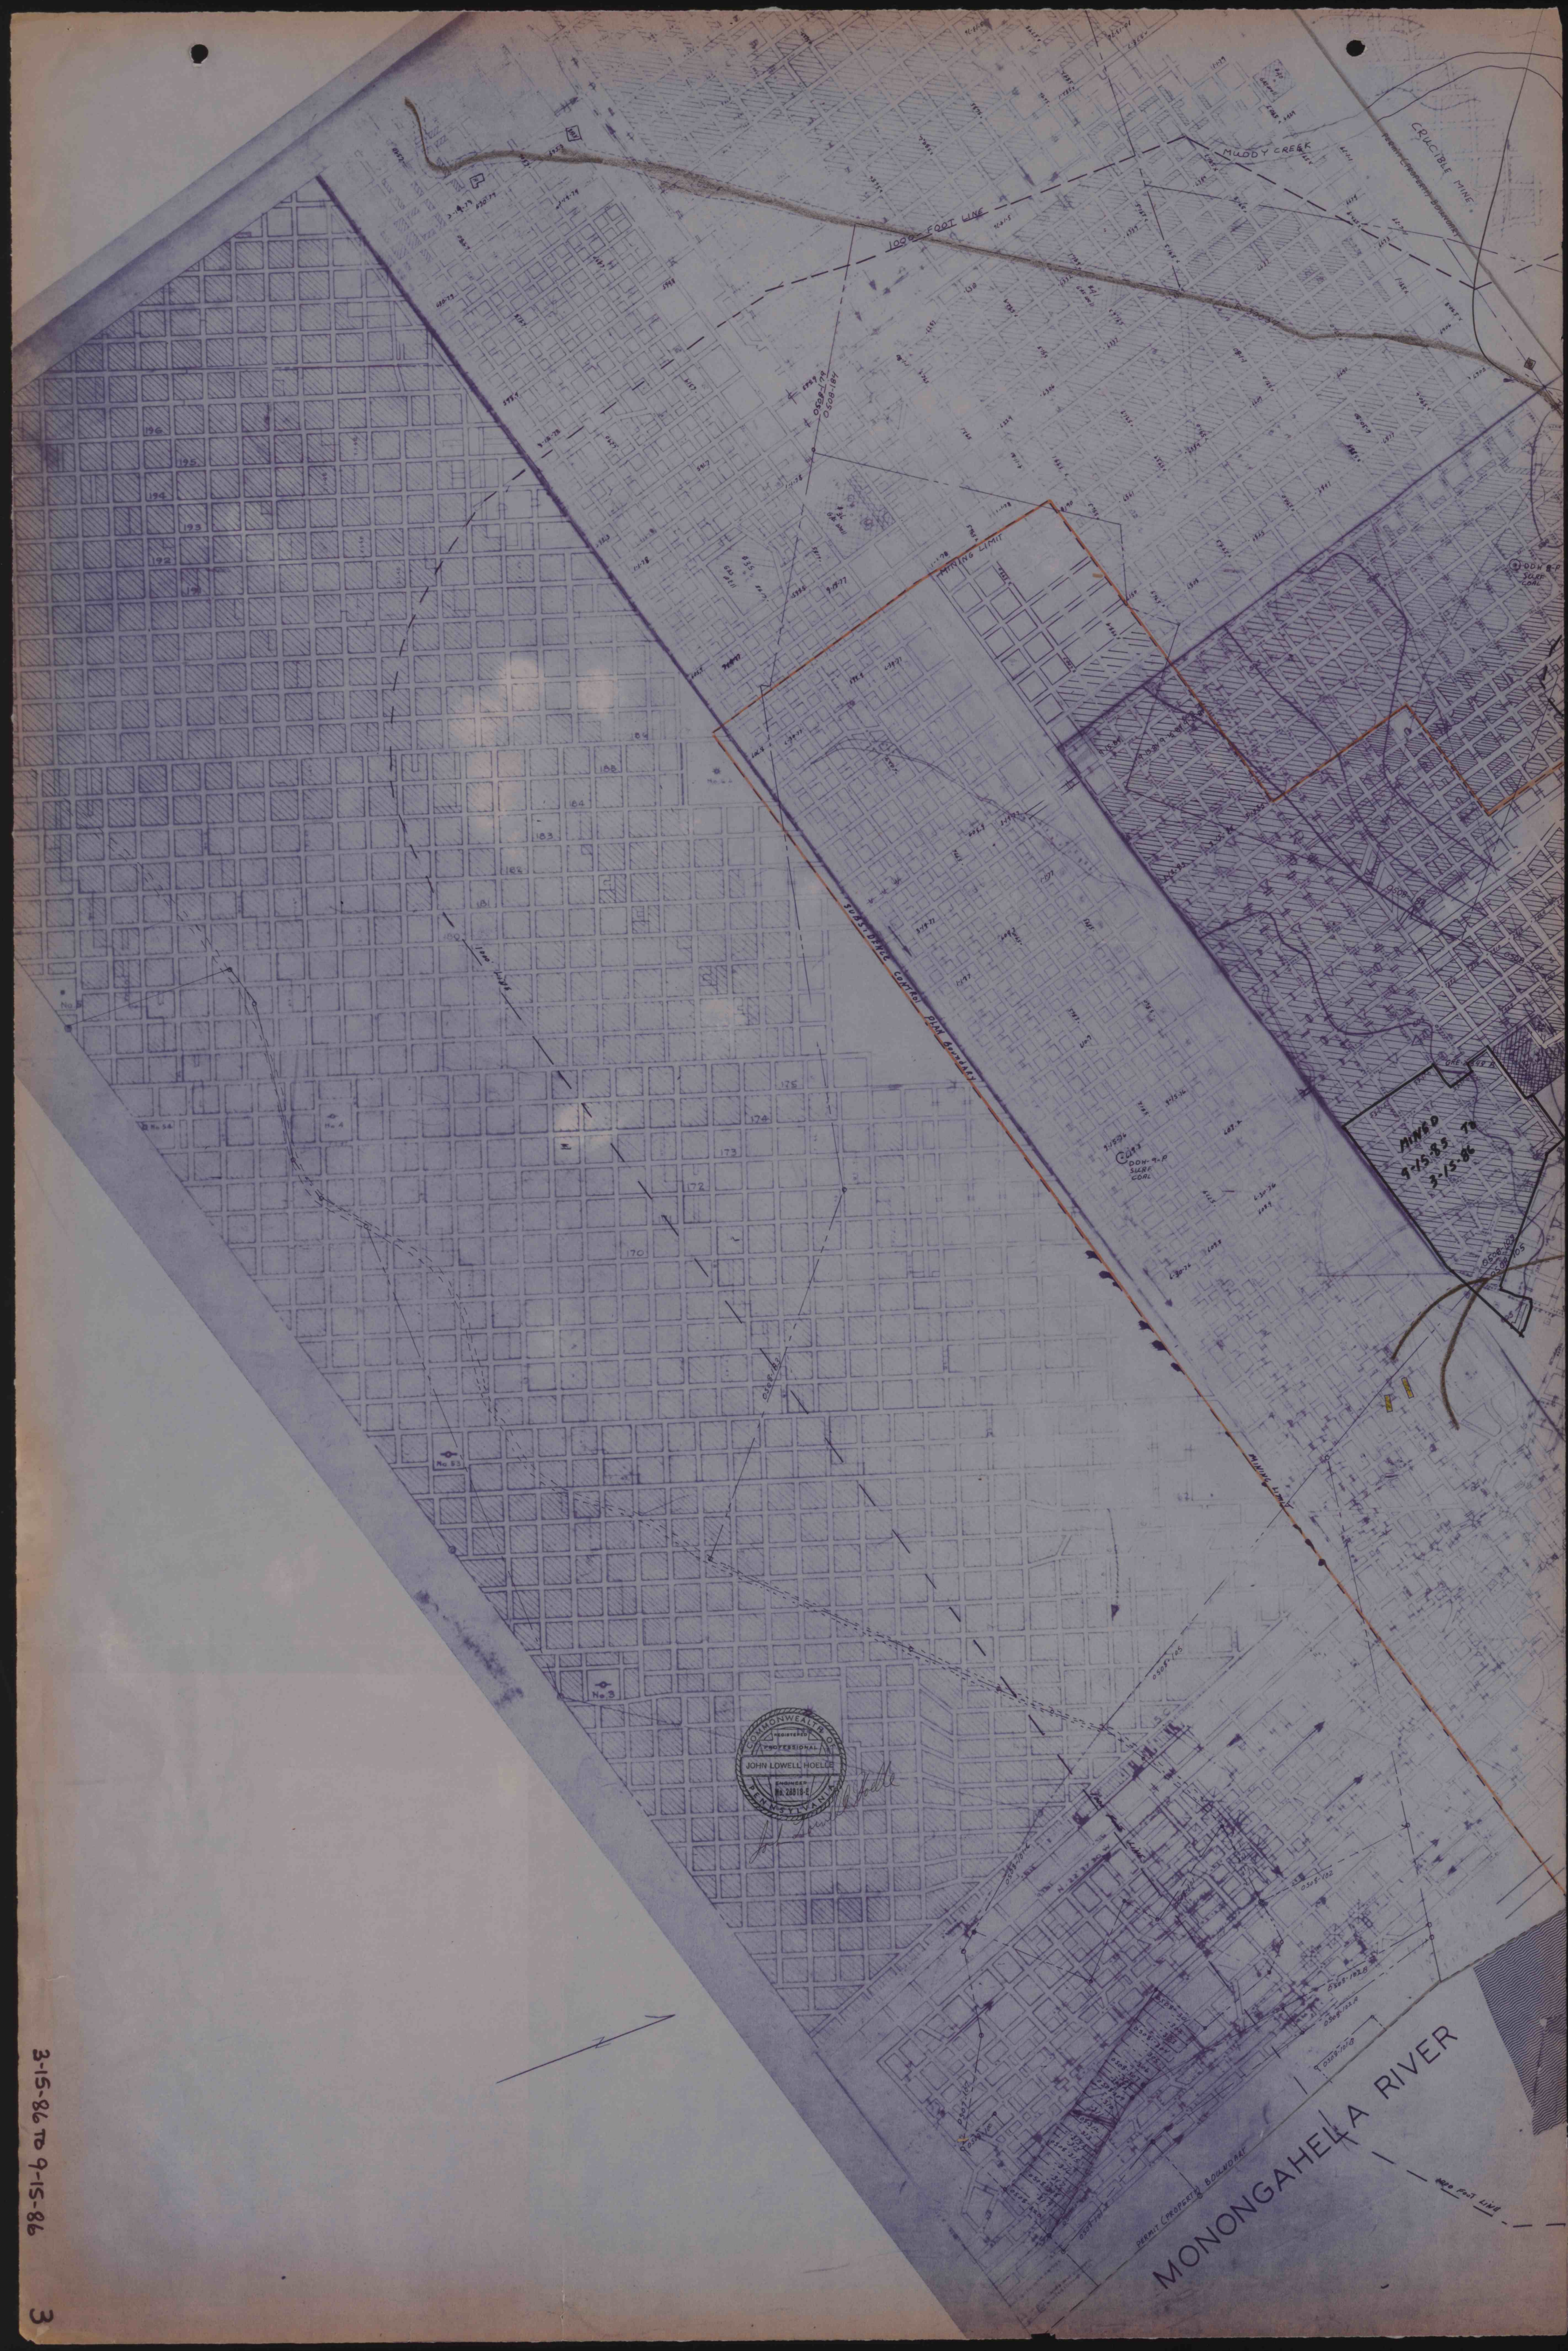

COMMONWEALTH OF
PENNSYLVANIA
REGISTERED
PROFESSIONAL
SURVEYOR
JOHN LOWELL HOELZ
EXPIRATION
04-28-18-E

MONONGAHELA RIVER

MIND
9-15-86 TO
3-15-86