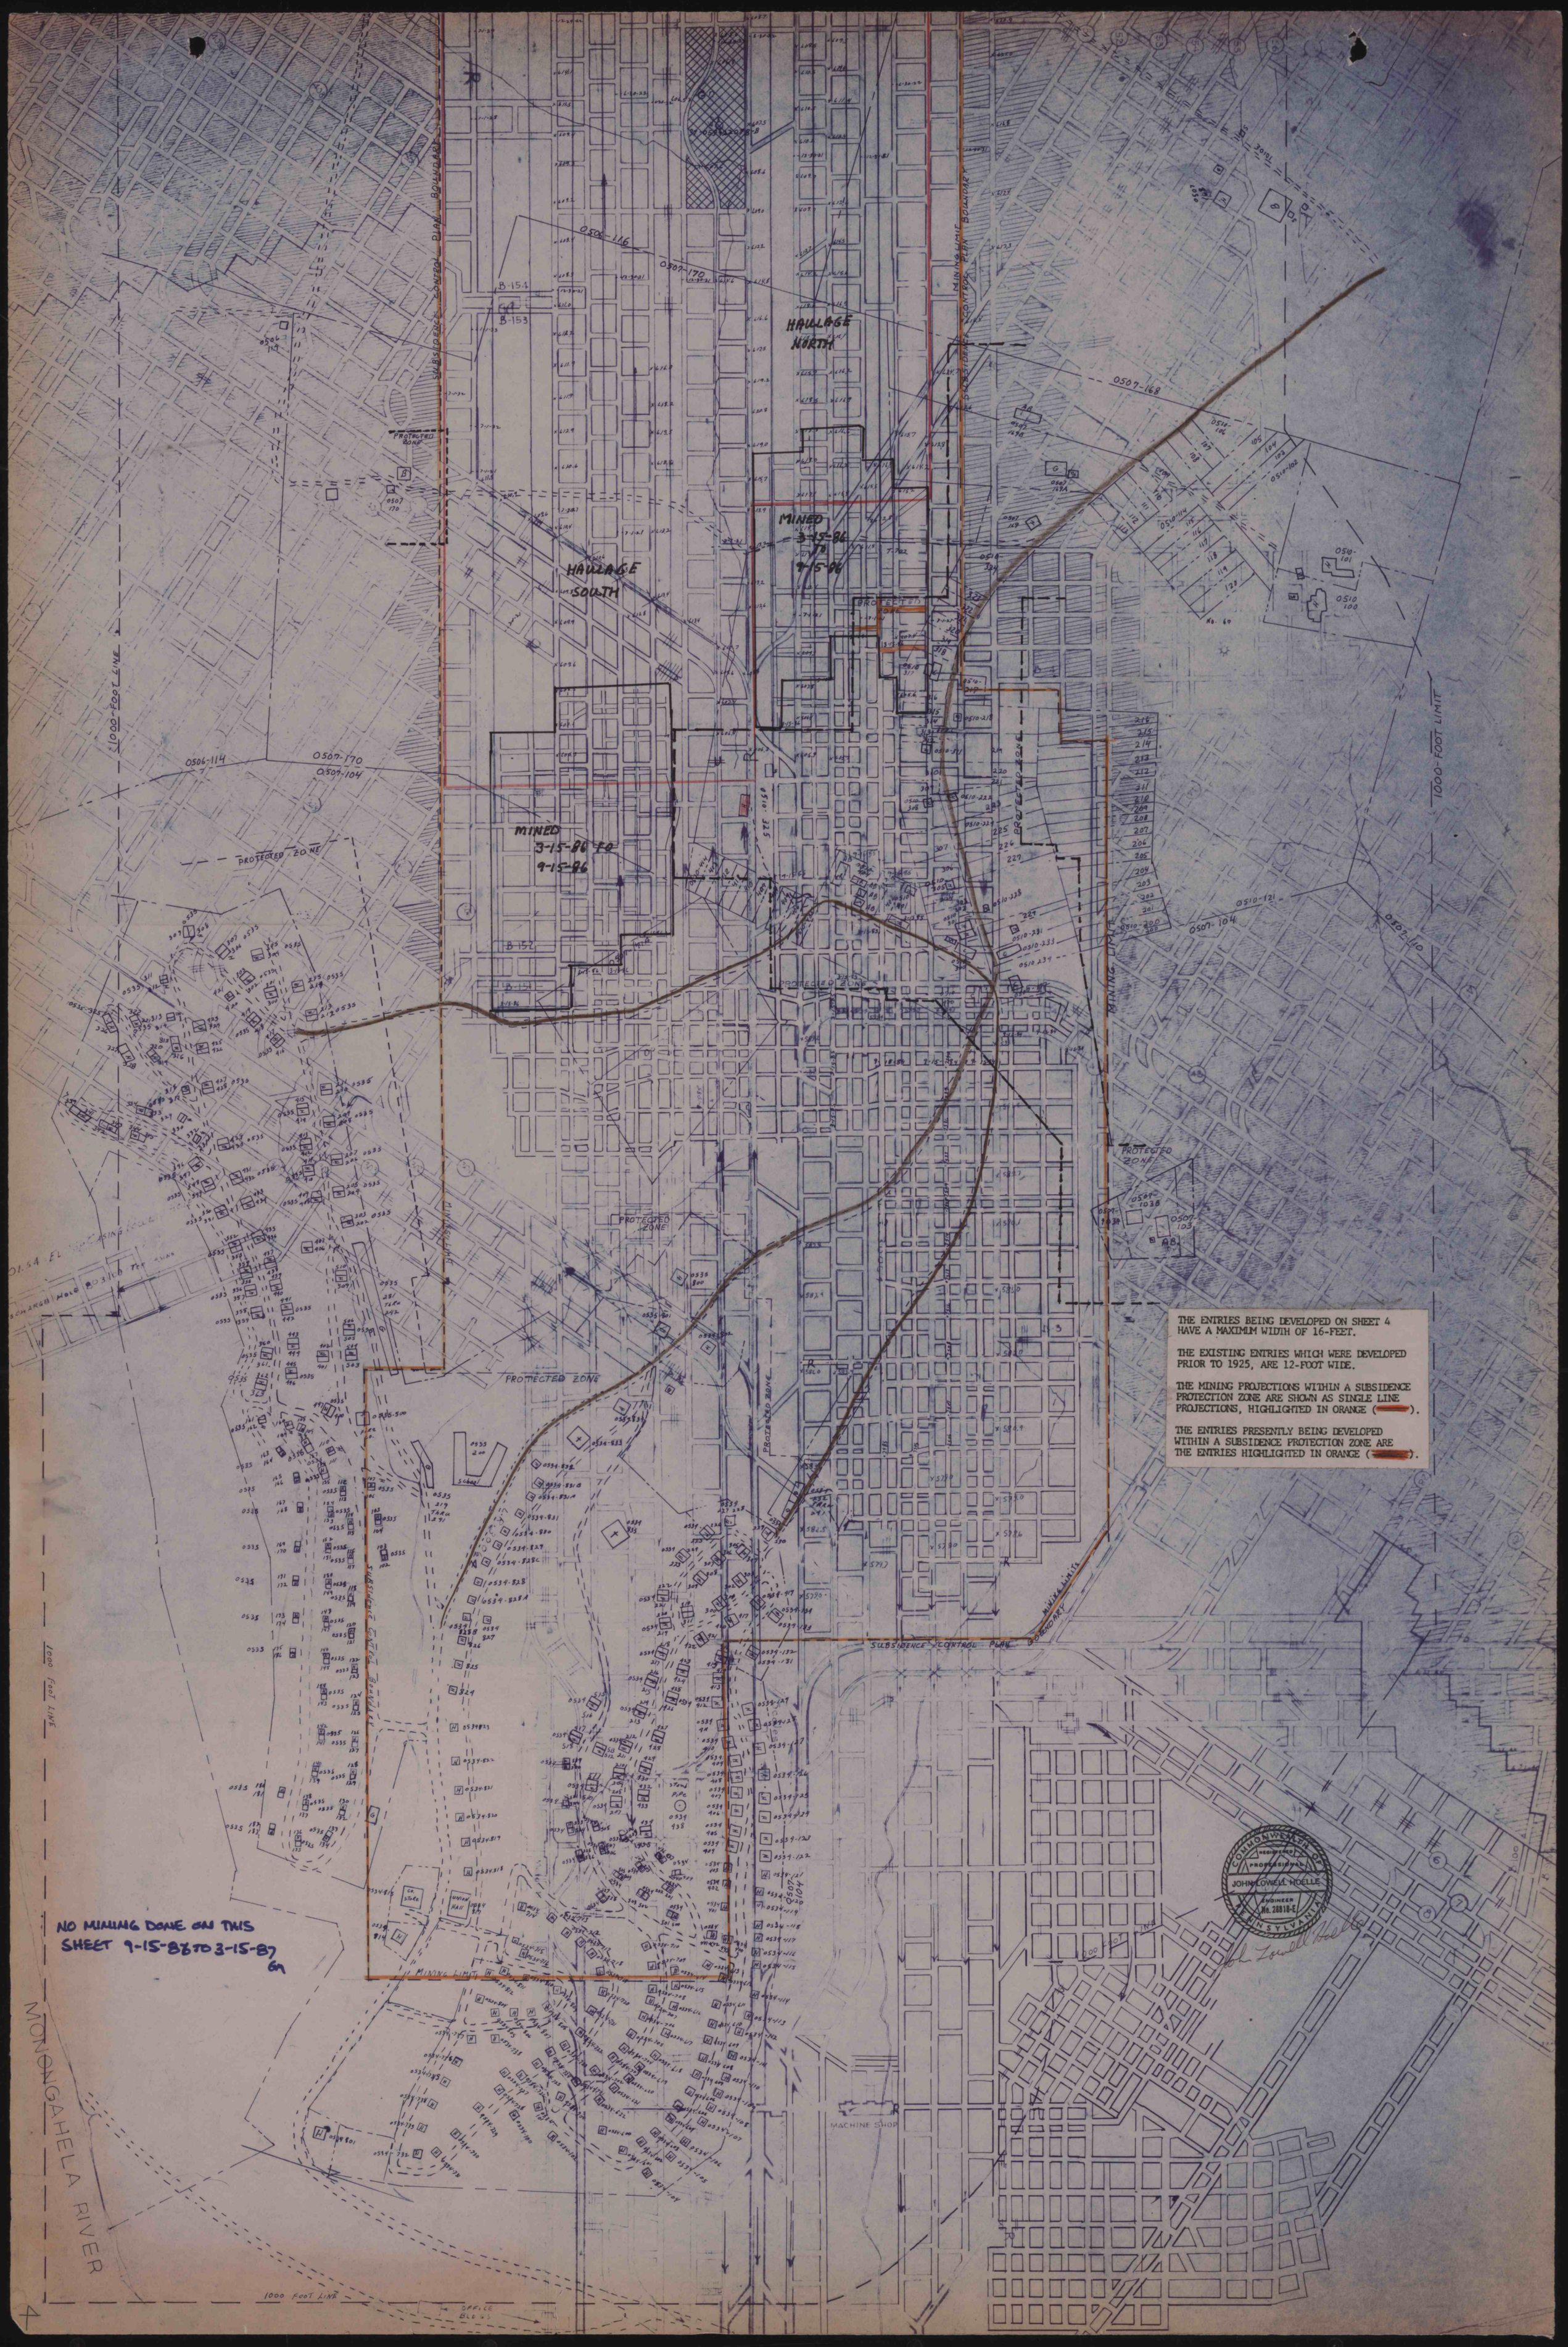
HAULAGE NORTH
HAULAGE SOUTH
MINED 3-15-86 TO 9-15-86
MINED 3-15-86 TO 9-15-86
PROTECTED ZONE
SUBSIDENCE CONTROL PLAN BOUNDARY
MINING LIMIT
1000-FOOT LINE
1000 foot LINE
MONONGAHELA RIVER
MACHINE SHOP
OFFICE BLDGS
THE ENTRIES BEING DEVELOPED ON SHEET 4 HAVE A MAXIMUM WIDTH OF 16-FEET.
THE EXISTING ENTRIES WHICH WERE DEVELOPED PRIOR TO 1925, ARE 12-FOOT WIDE.
THE MINING PROJECTIONS WITHIN A SUBSIDENCE PROTECTION ZONE ARE SHOWN AS SINGLE LINE PROJECTIONS, HIGHLIGHTED IN ORANGE ( ).
THE ENTRIES PRESENTLY BEING DEVELOPED WITHIN A SUBSIDENCE PROTECTION ZONE ARE THE ENTRIES HIGHLIGHTED IN ORANGE ( ).
NO MINING DONE ON THIS SHEET 9-15-86 TO 3-15-87
COMMONWEALTH OF PENNSYLVANIA
REGISTERED PROFESSIONAL
JOHN LOWELL HOELLE
ENGINEER
No. 28818-E