


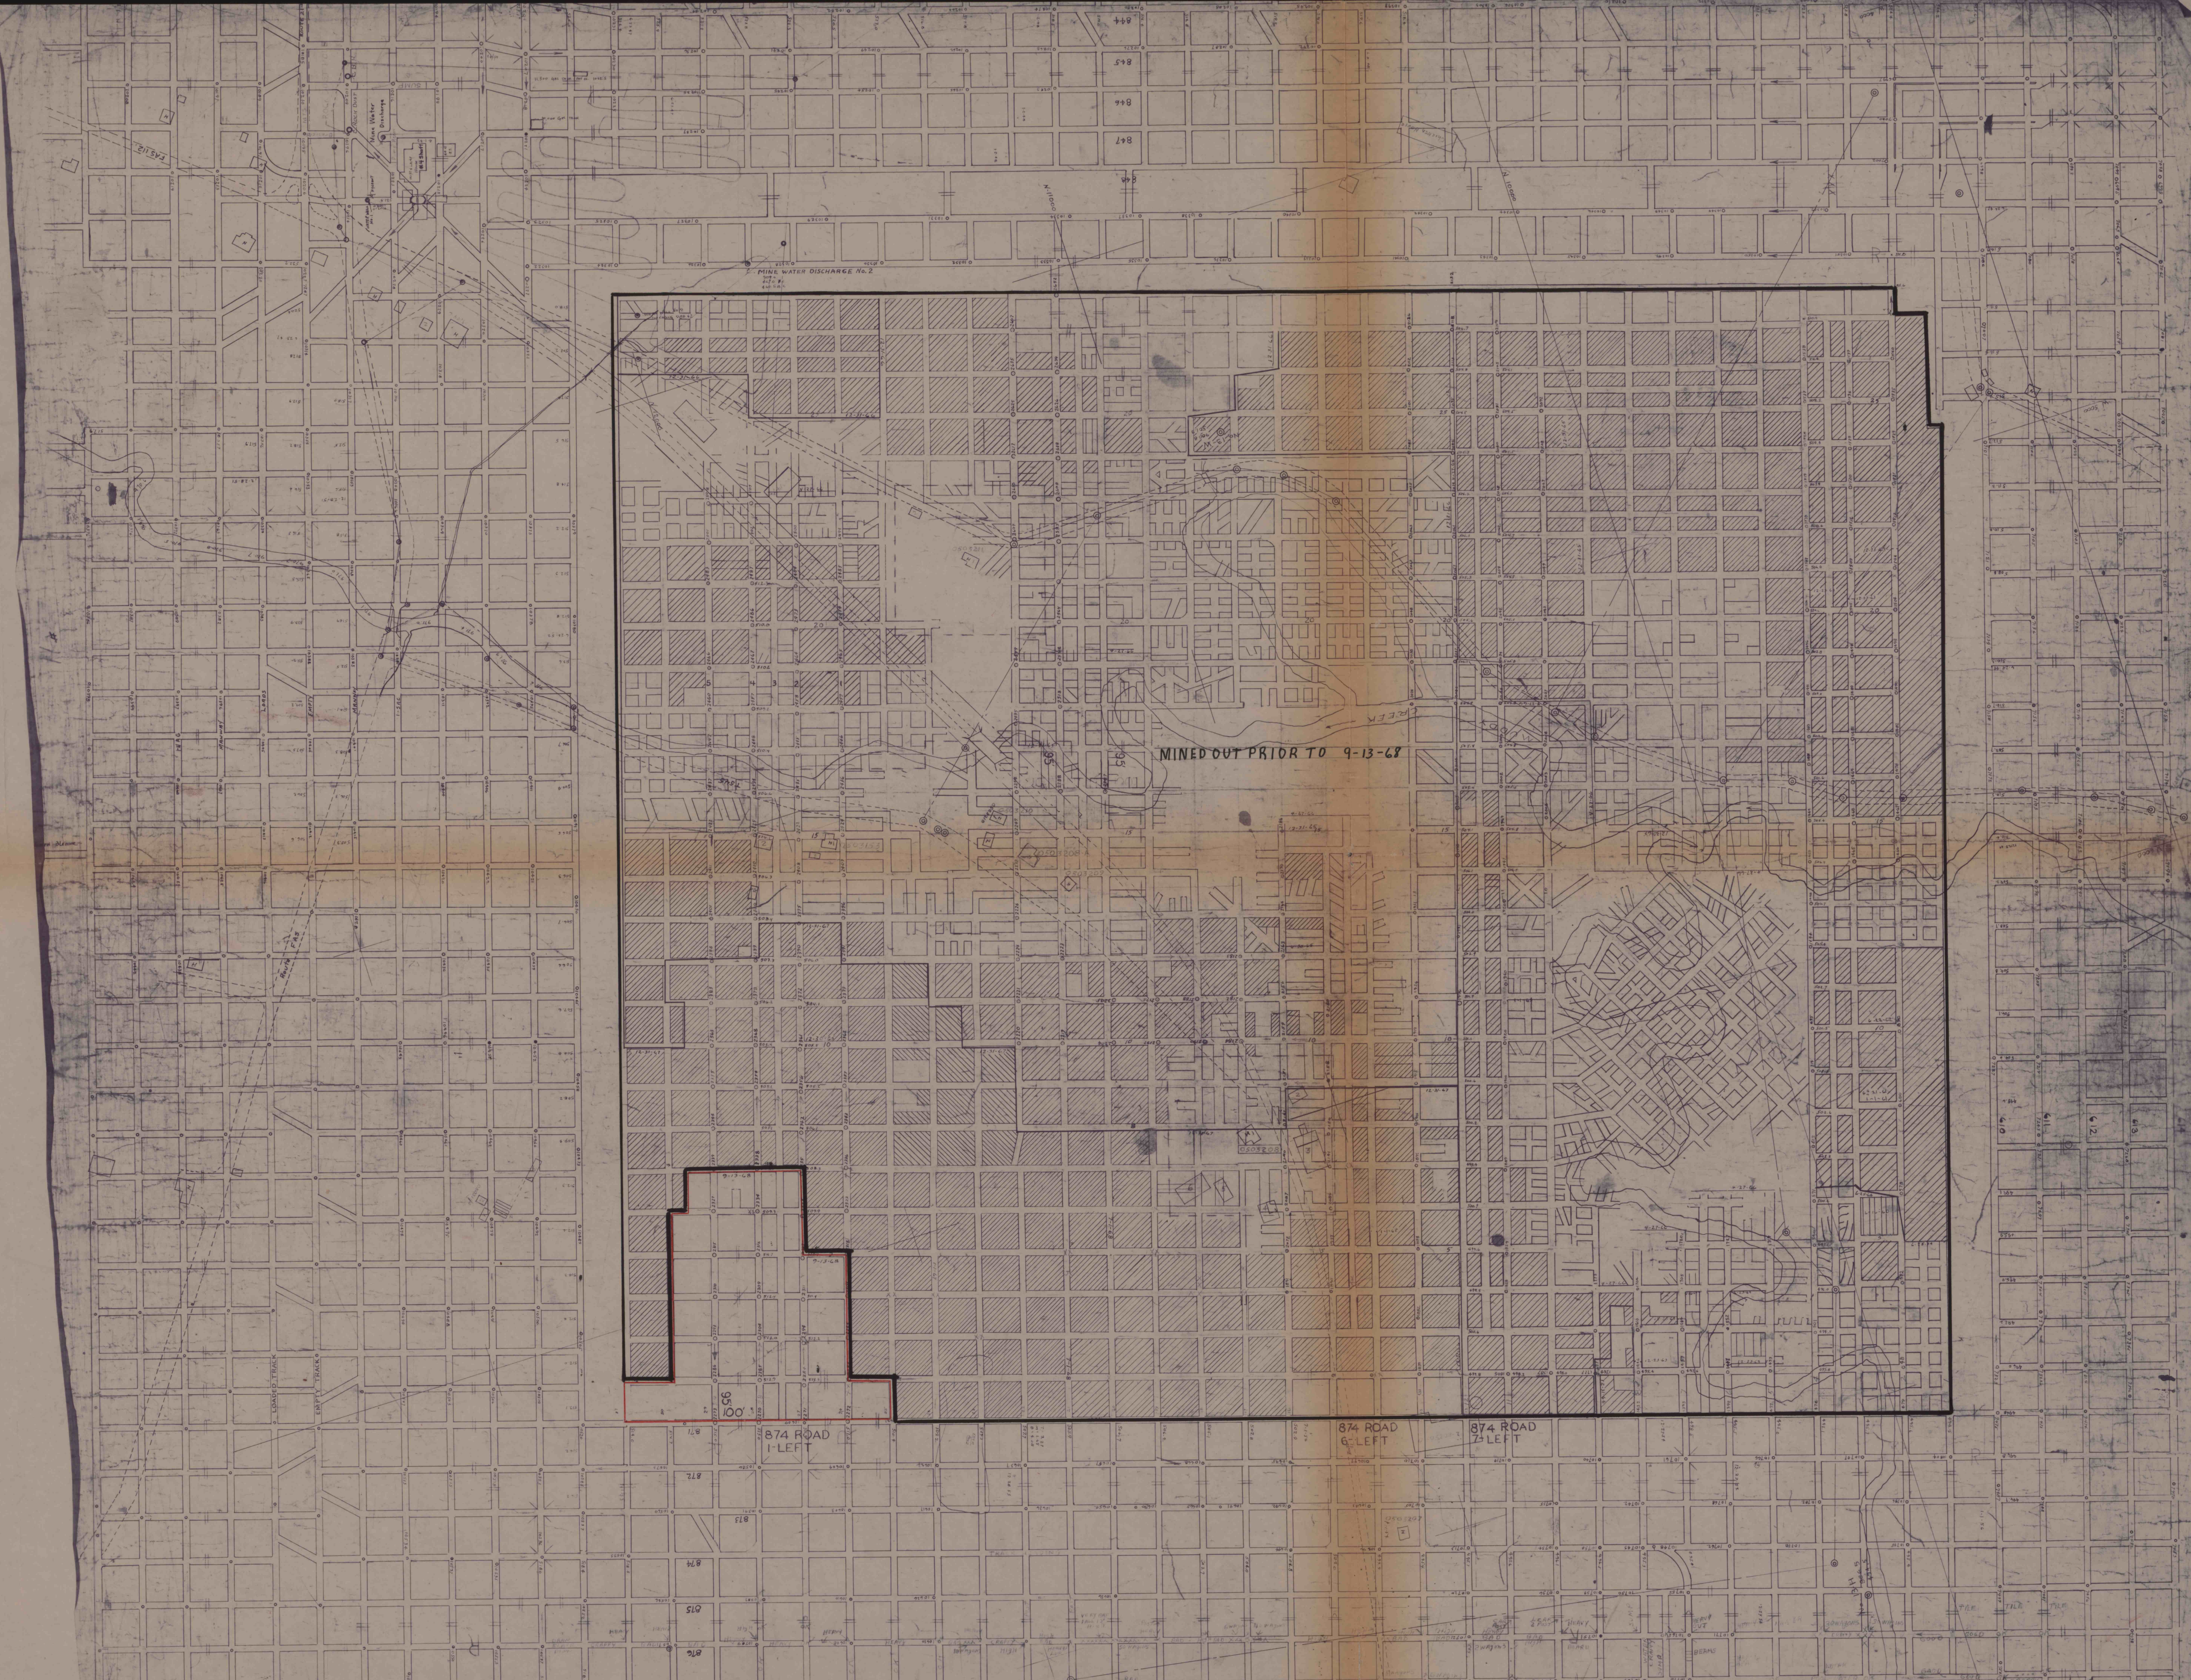


THE BUCKEYE COAL COMPANY
NEMACOLIN, GREENE COUNTY, PENN'A.

NEMACOLIN MINE
PROJECTION OF MINE WORK ANTICIPATED WITHIN THE NEXT SIX MONTHS

MINE MAP TRACING NO. 11
AREA 874 Rd
DATE OF MAP 9-13-68

RED LINE: ENCLOSES MINING PROJECTION AREA FOR THE NEXT SIX MONTHS STARTING ON 9-13-68
DASHED LINE: ENCLOSES BOUNDARY OF SUPPORT PILLAR WHEREIN 80% OF THE COAL WILL BE UNIFORMLY LEFT IN PLACE

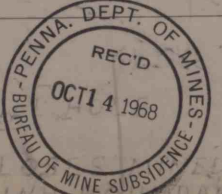

THE BUCKEYE COAL COMPANY
NEMACOLIN MINE

874 AREA - MINE MAP TRACING # 11

908