


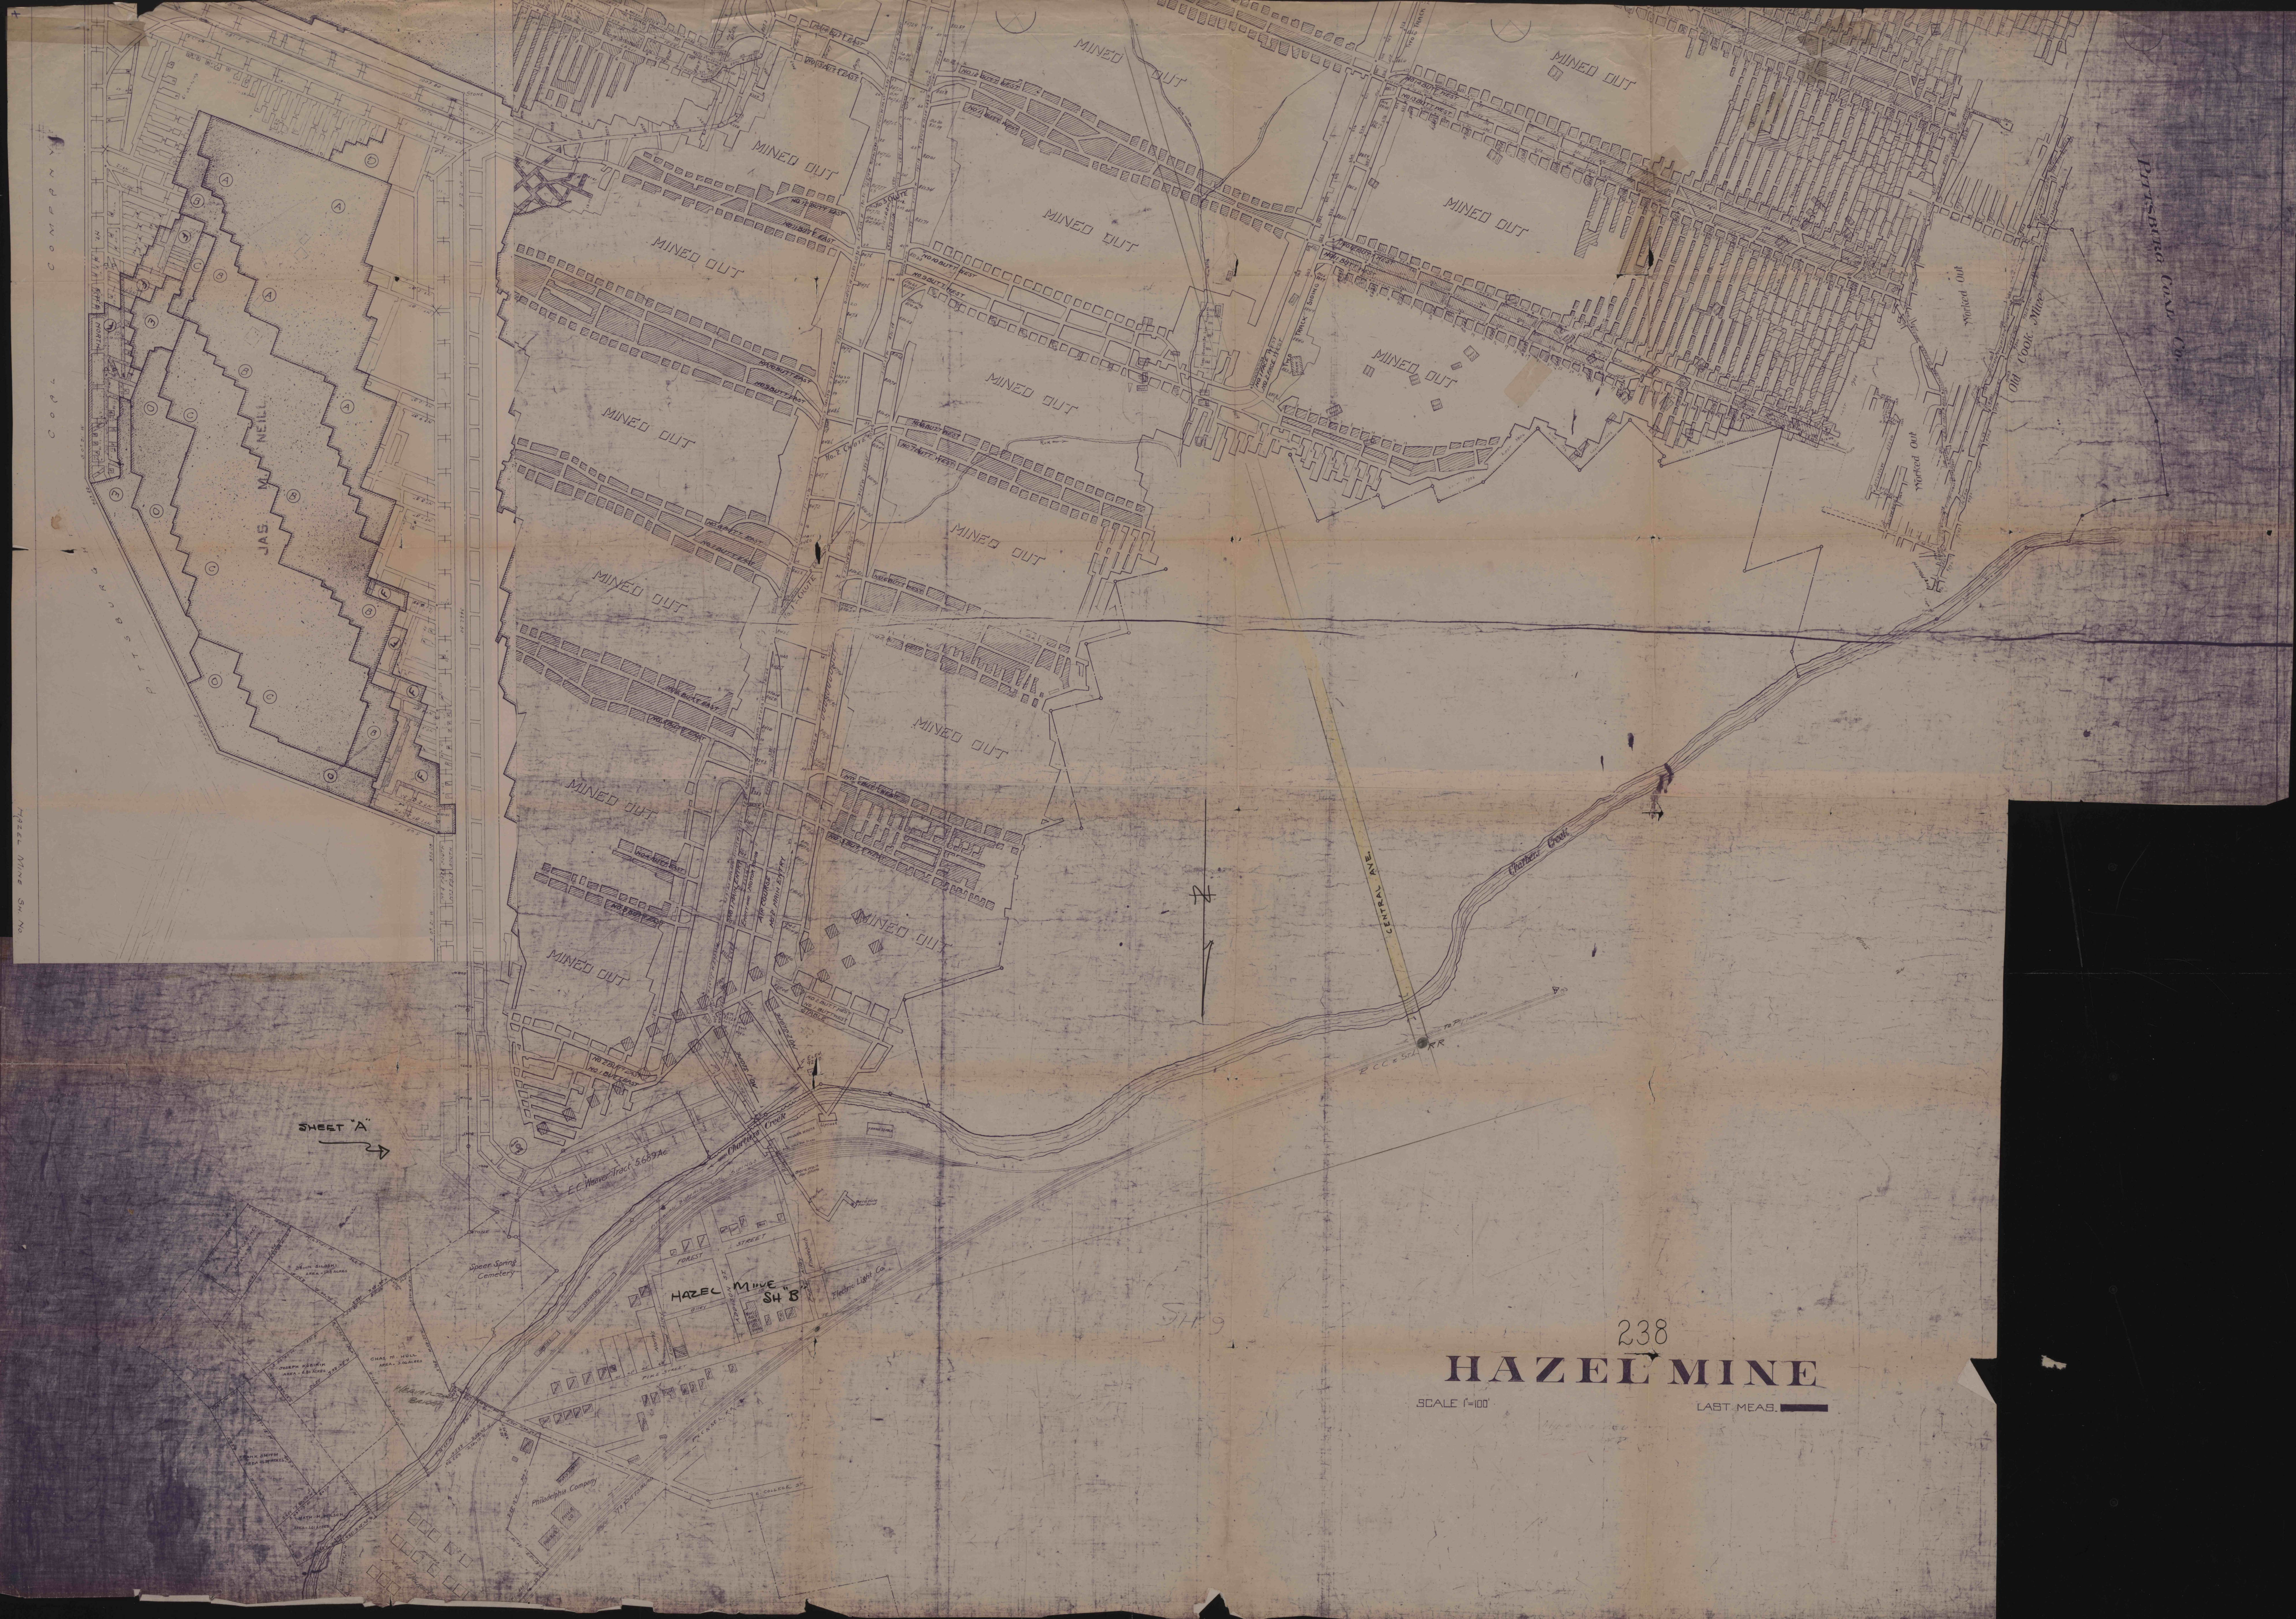

Hazel Mine Sh. No.

SHEET A

HAZEL MINE SH 8

238

HAZEL MINE

SCALE 1"=100'

LAST MEAS.