


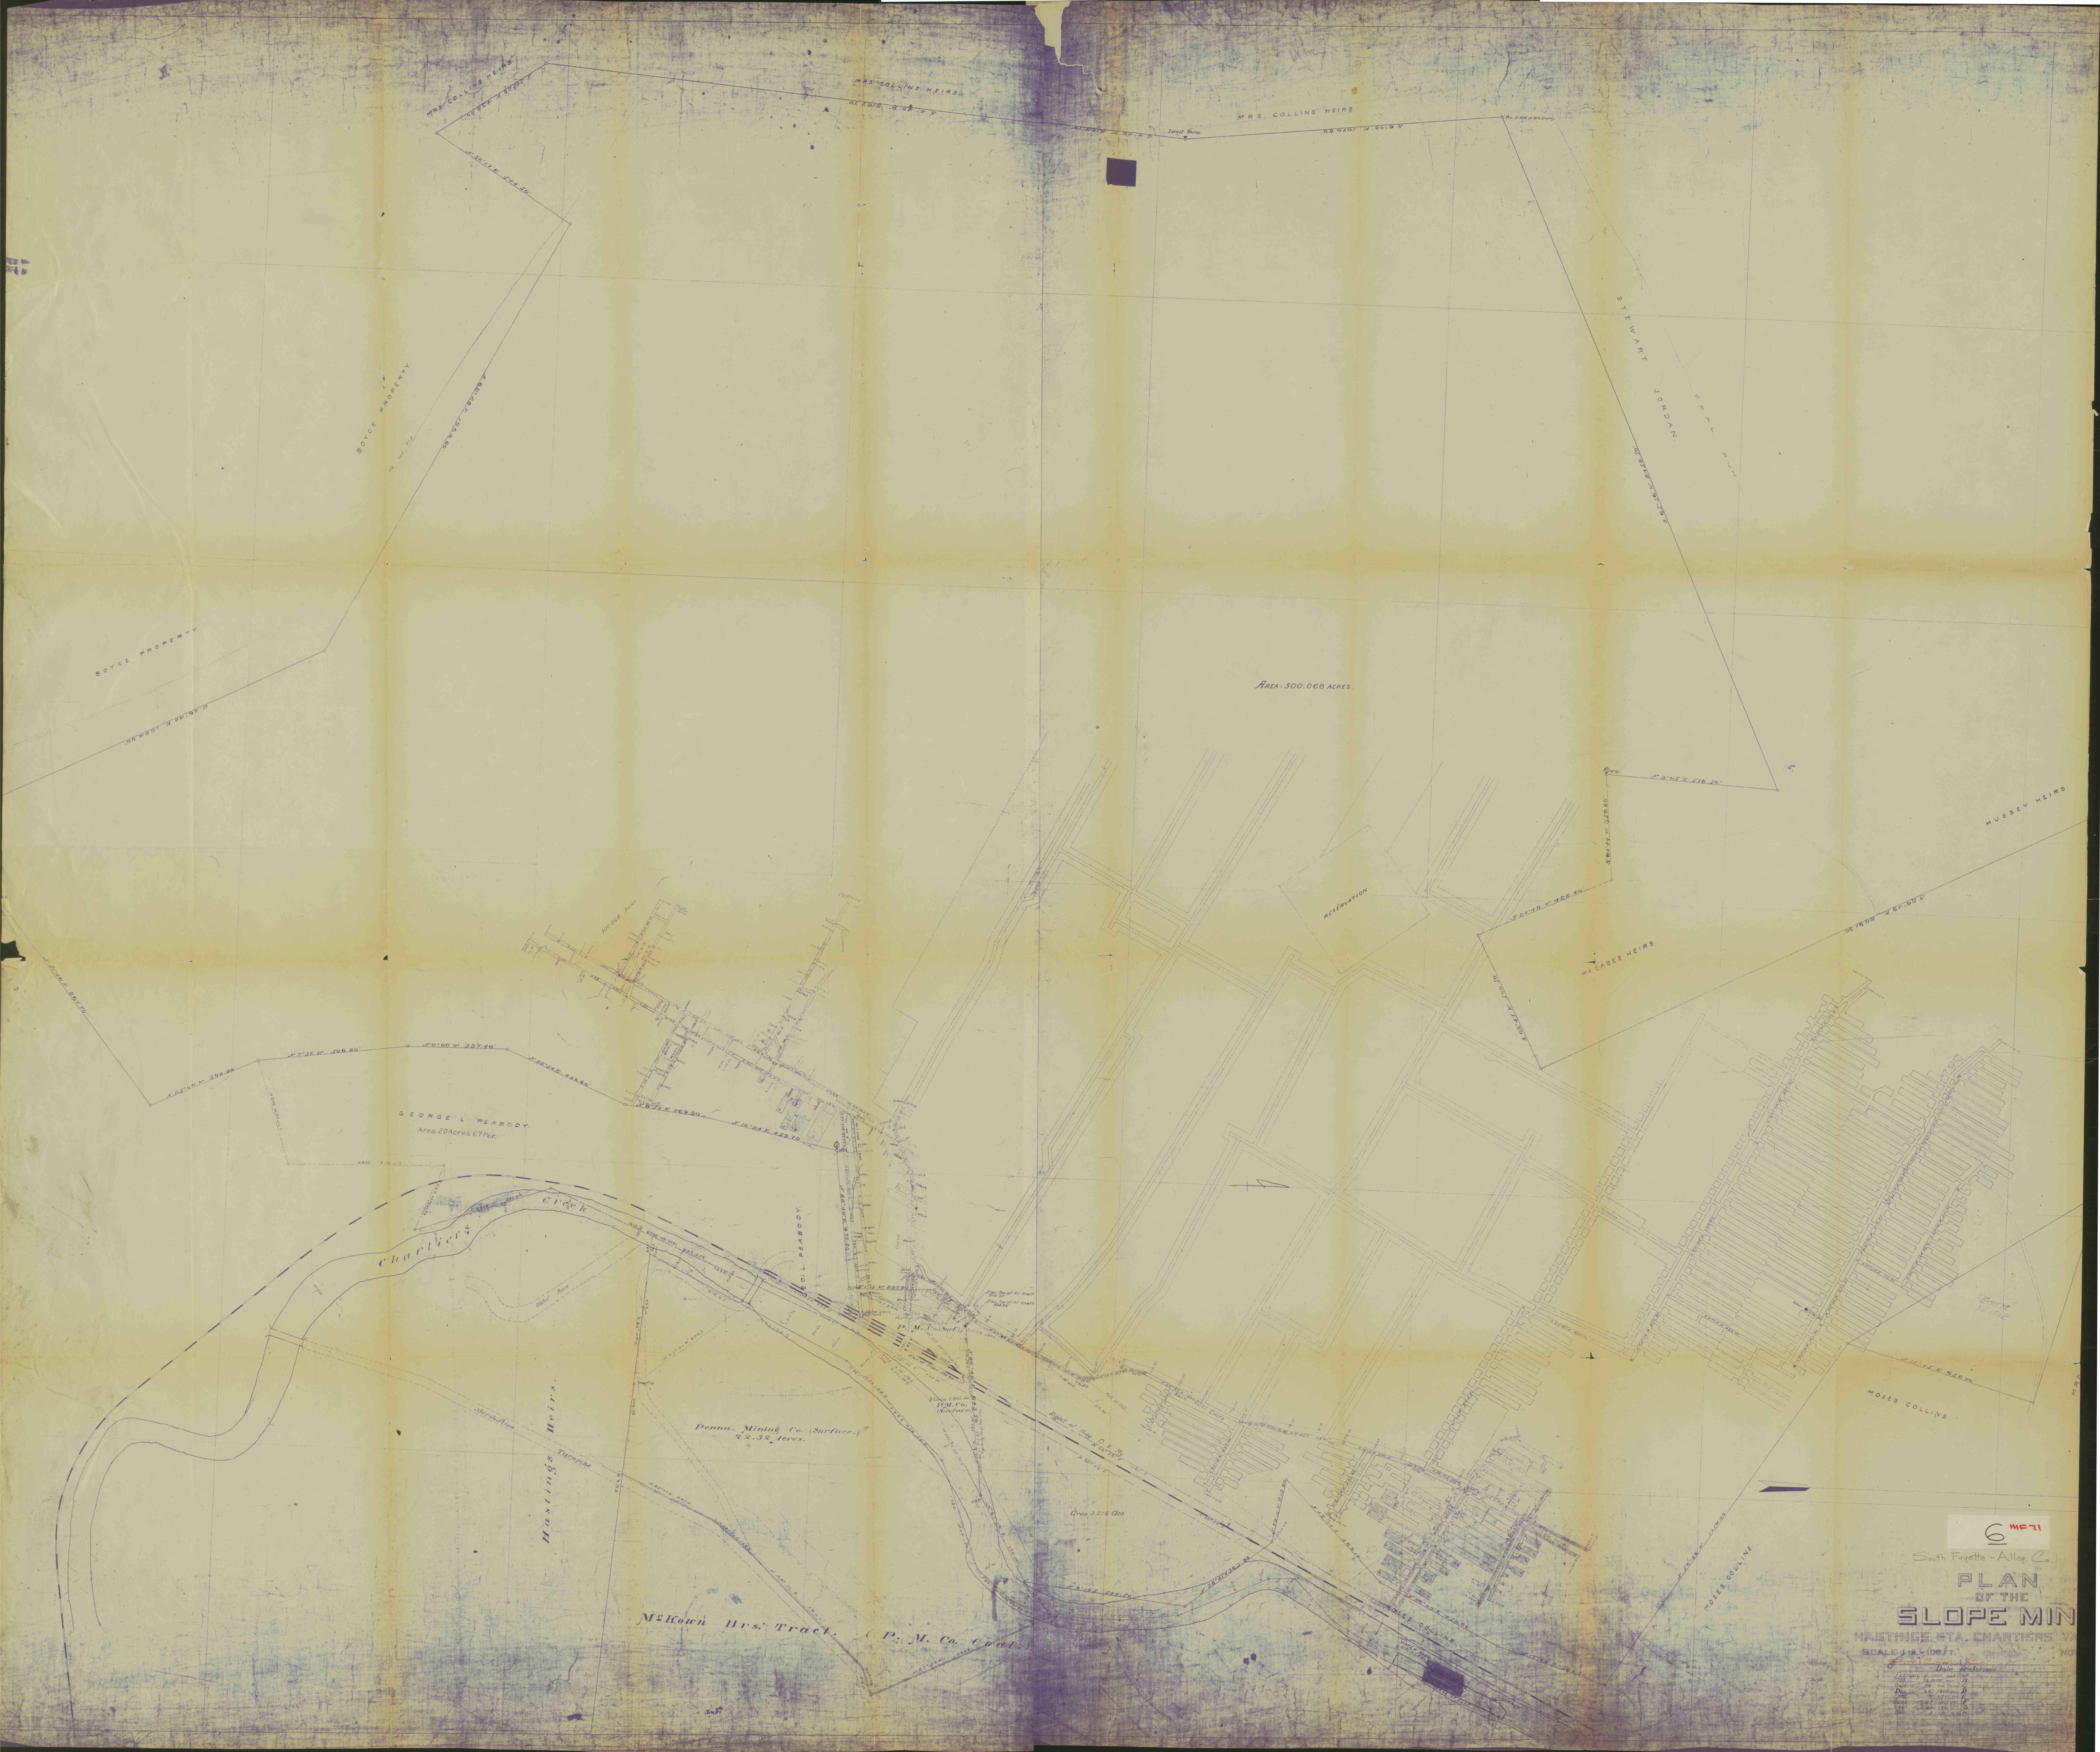

6 ME 71
South Fayette - Alleg 2
PLAN
OF THE
SLOPE MIN
HASTINGS STA. CHARTERS VA
SCALE 1" = 100 FT.
Date of Survey
