


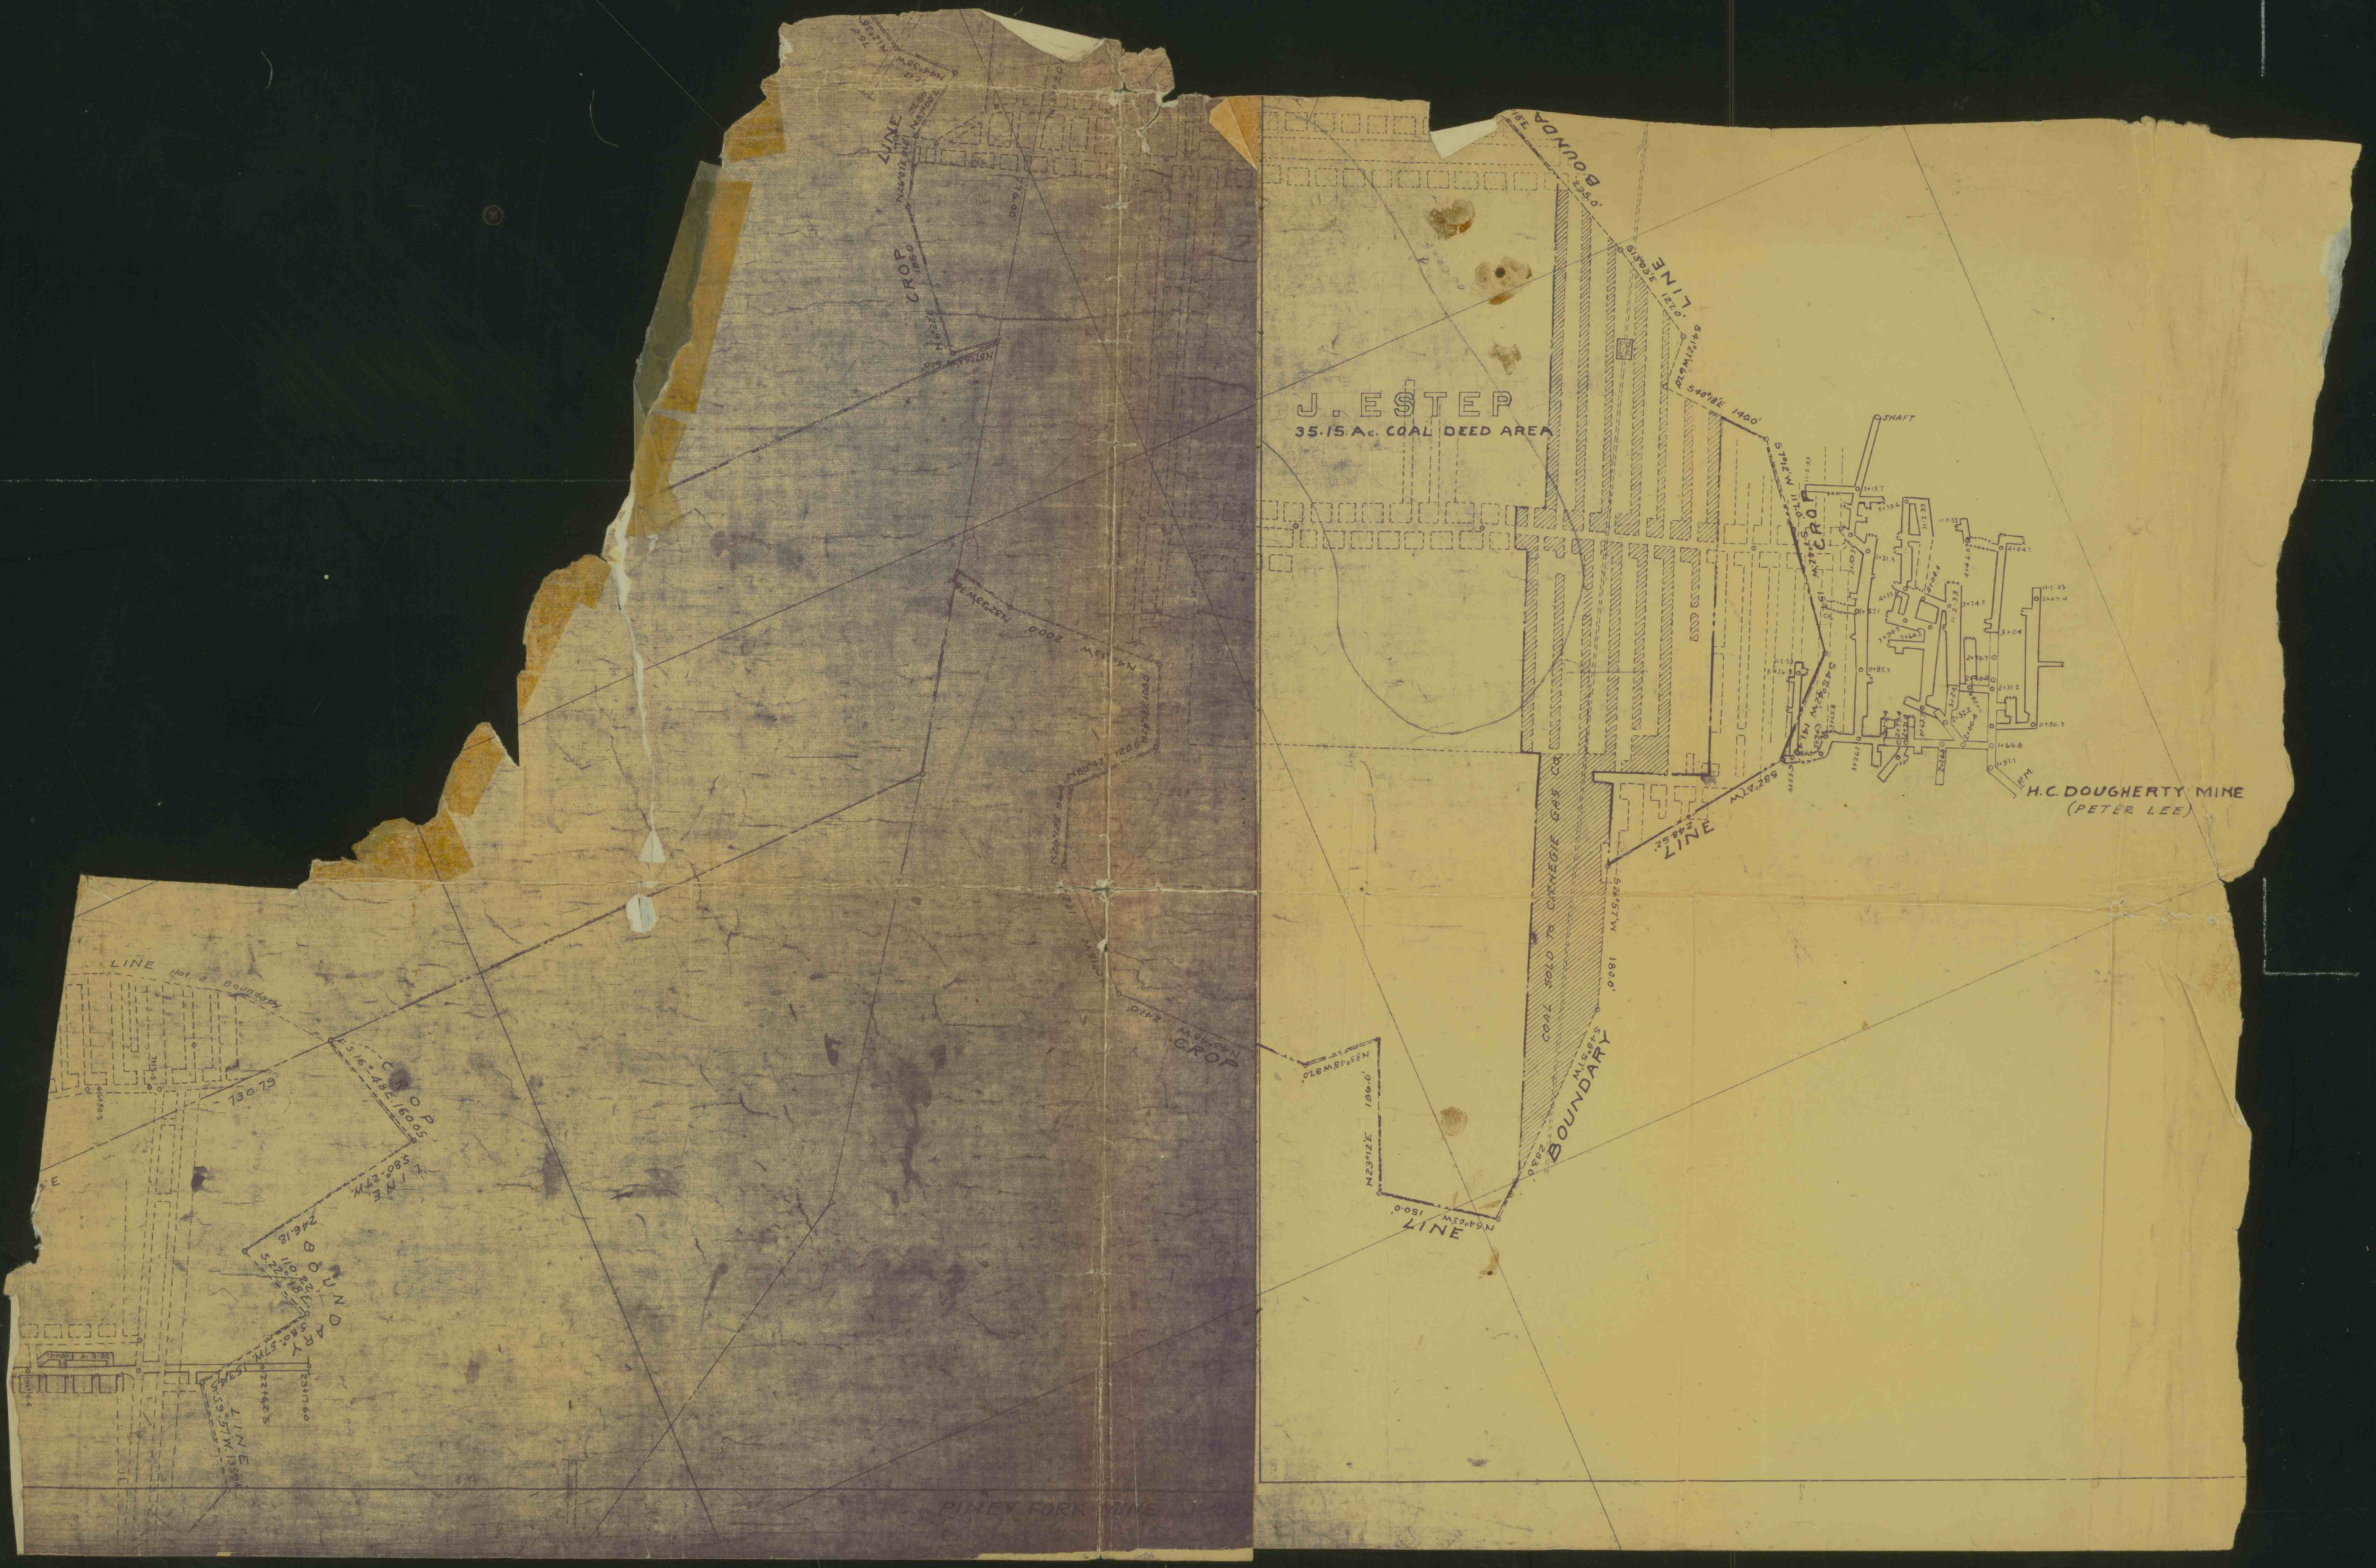

J. ESTEP
35.15 AC. COAL DEED AREA

H.C. DOUGHERTY MINE
(PETER LEE)

BOUNDARY

LINE


SHAFT

CROP

CROP

LINE

CLAMP

LINE

BOUNDARY

LINE

PINEY FORK MINE