


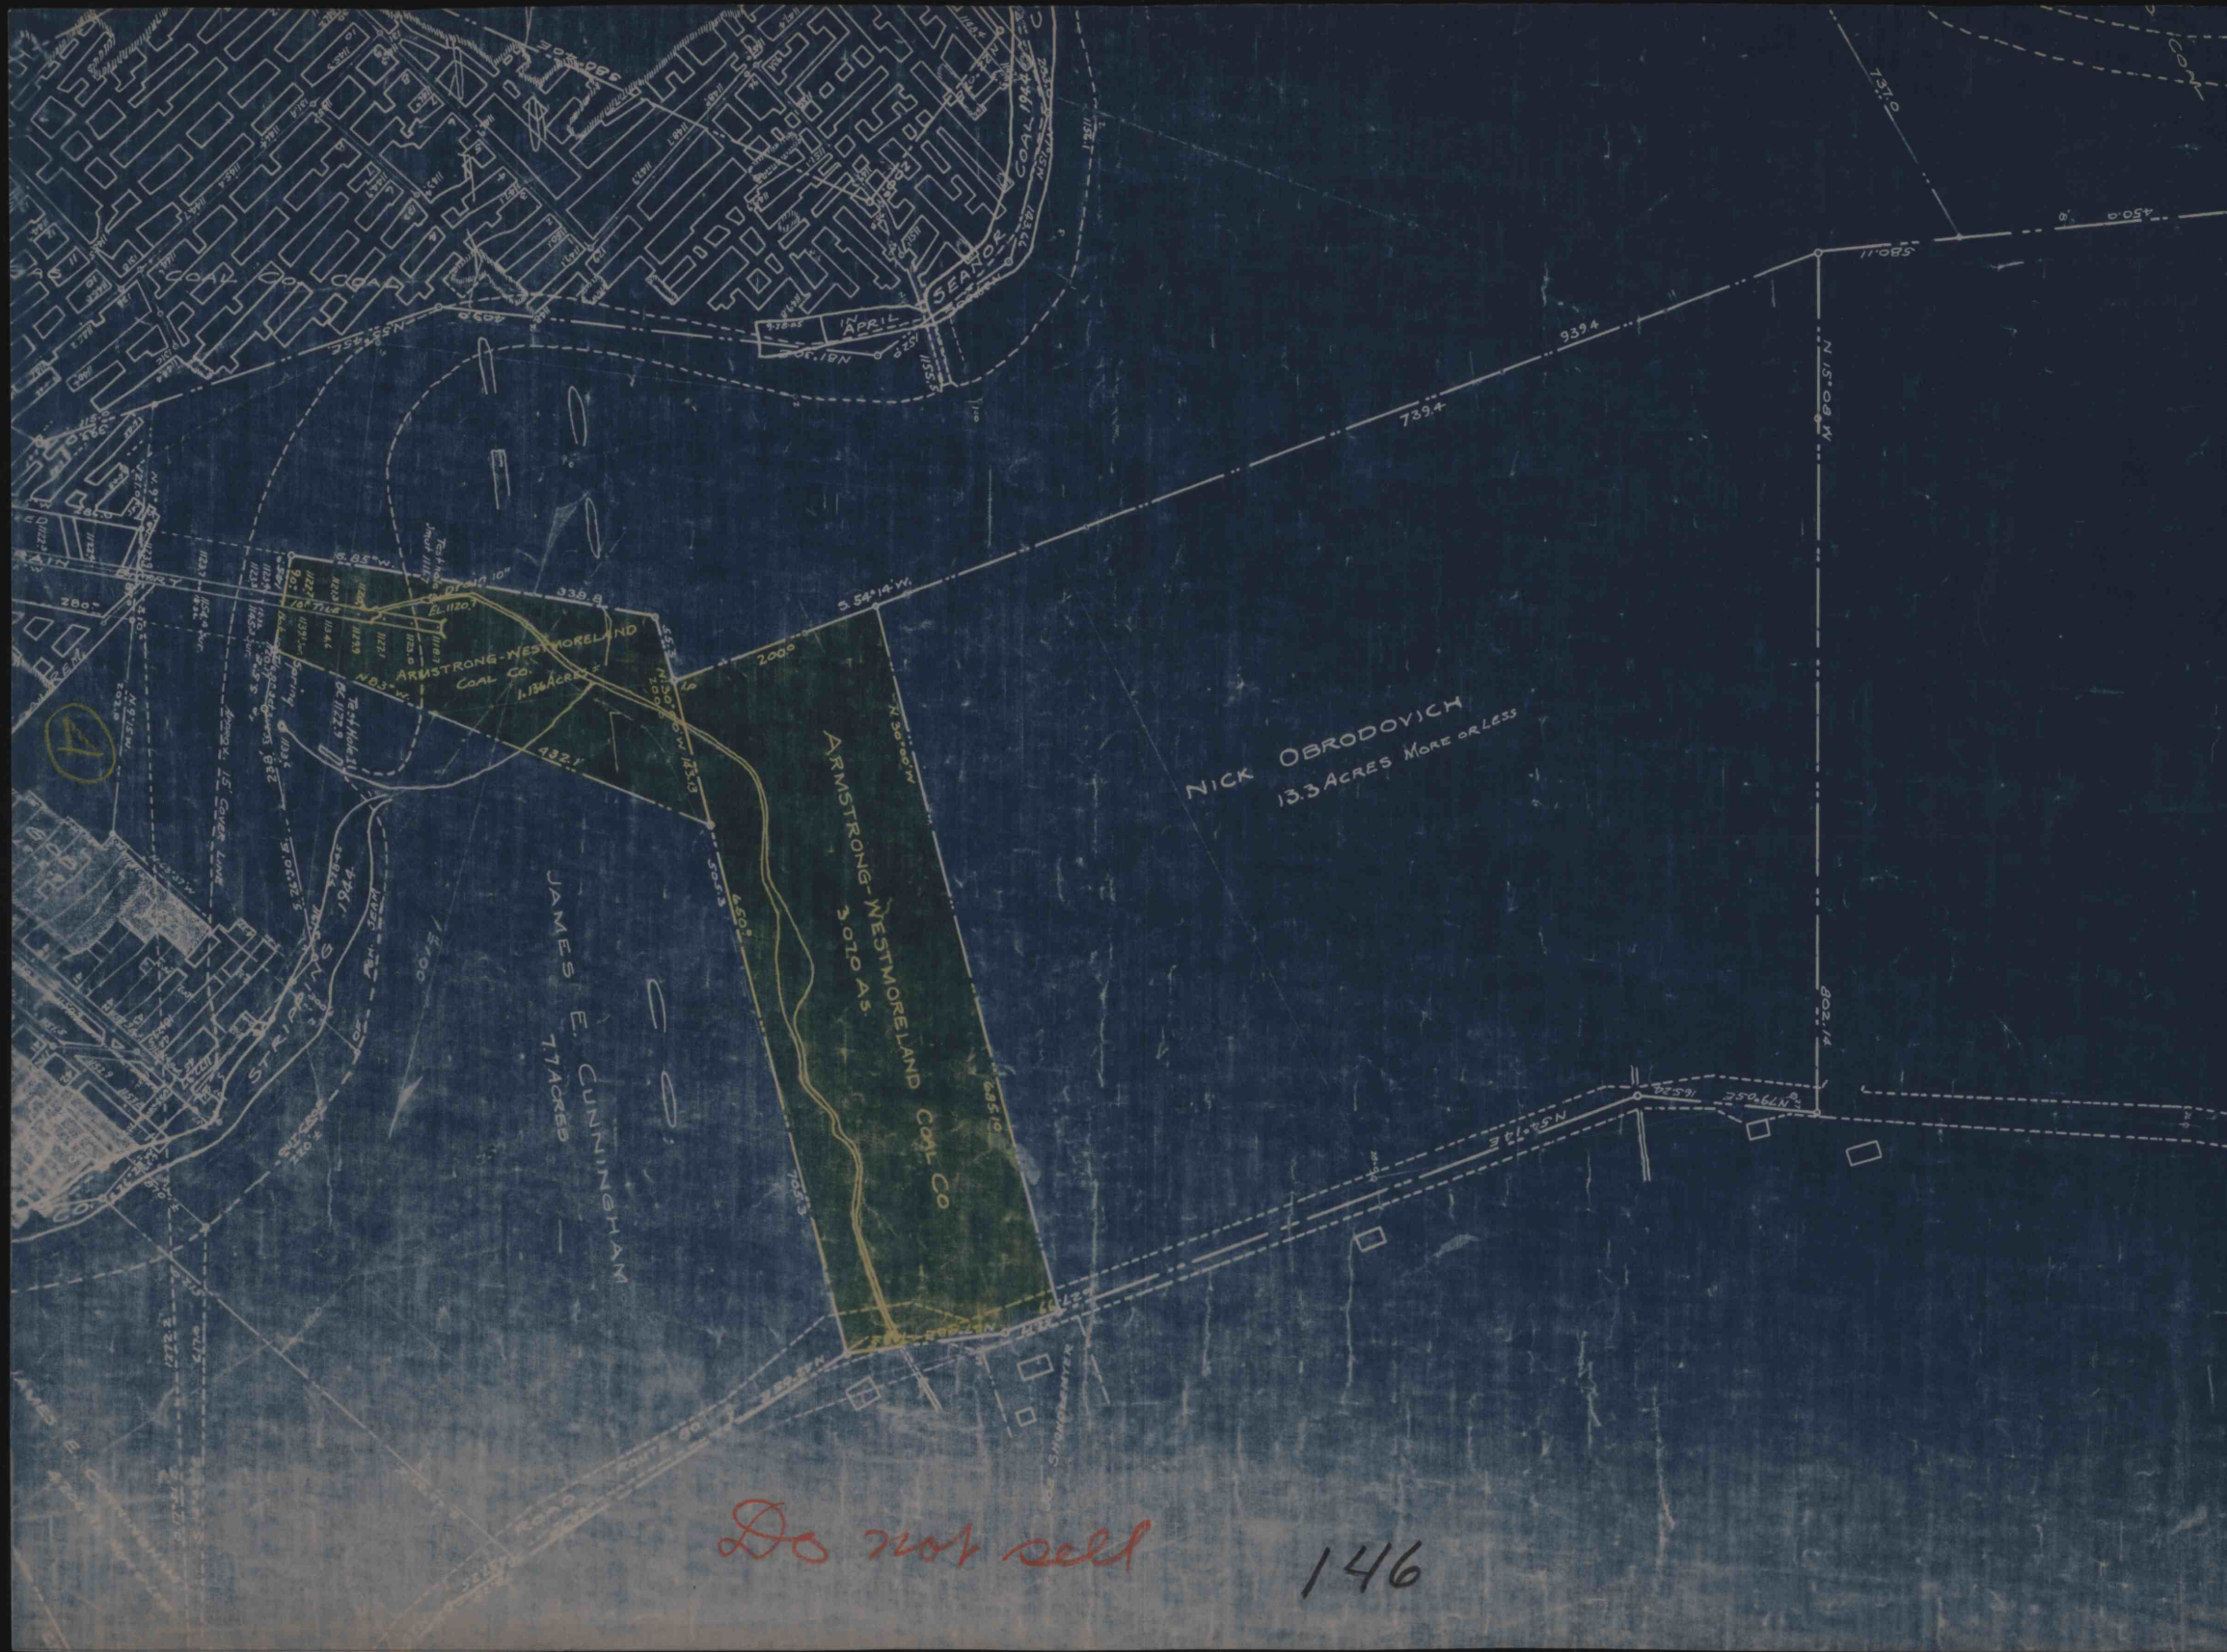

Do not sell

146