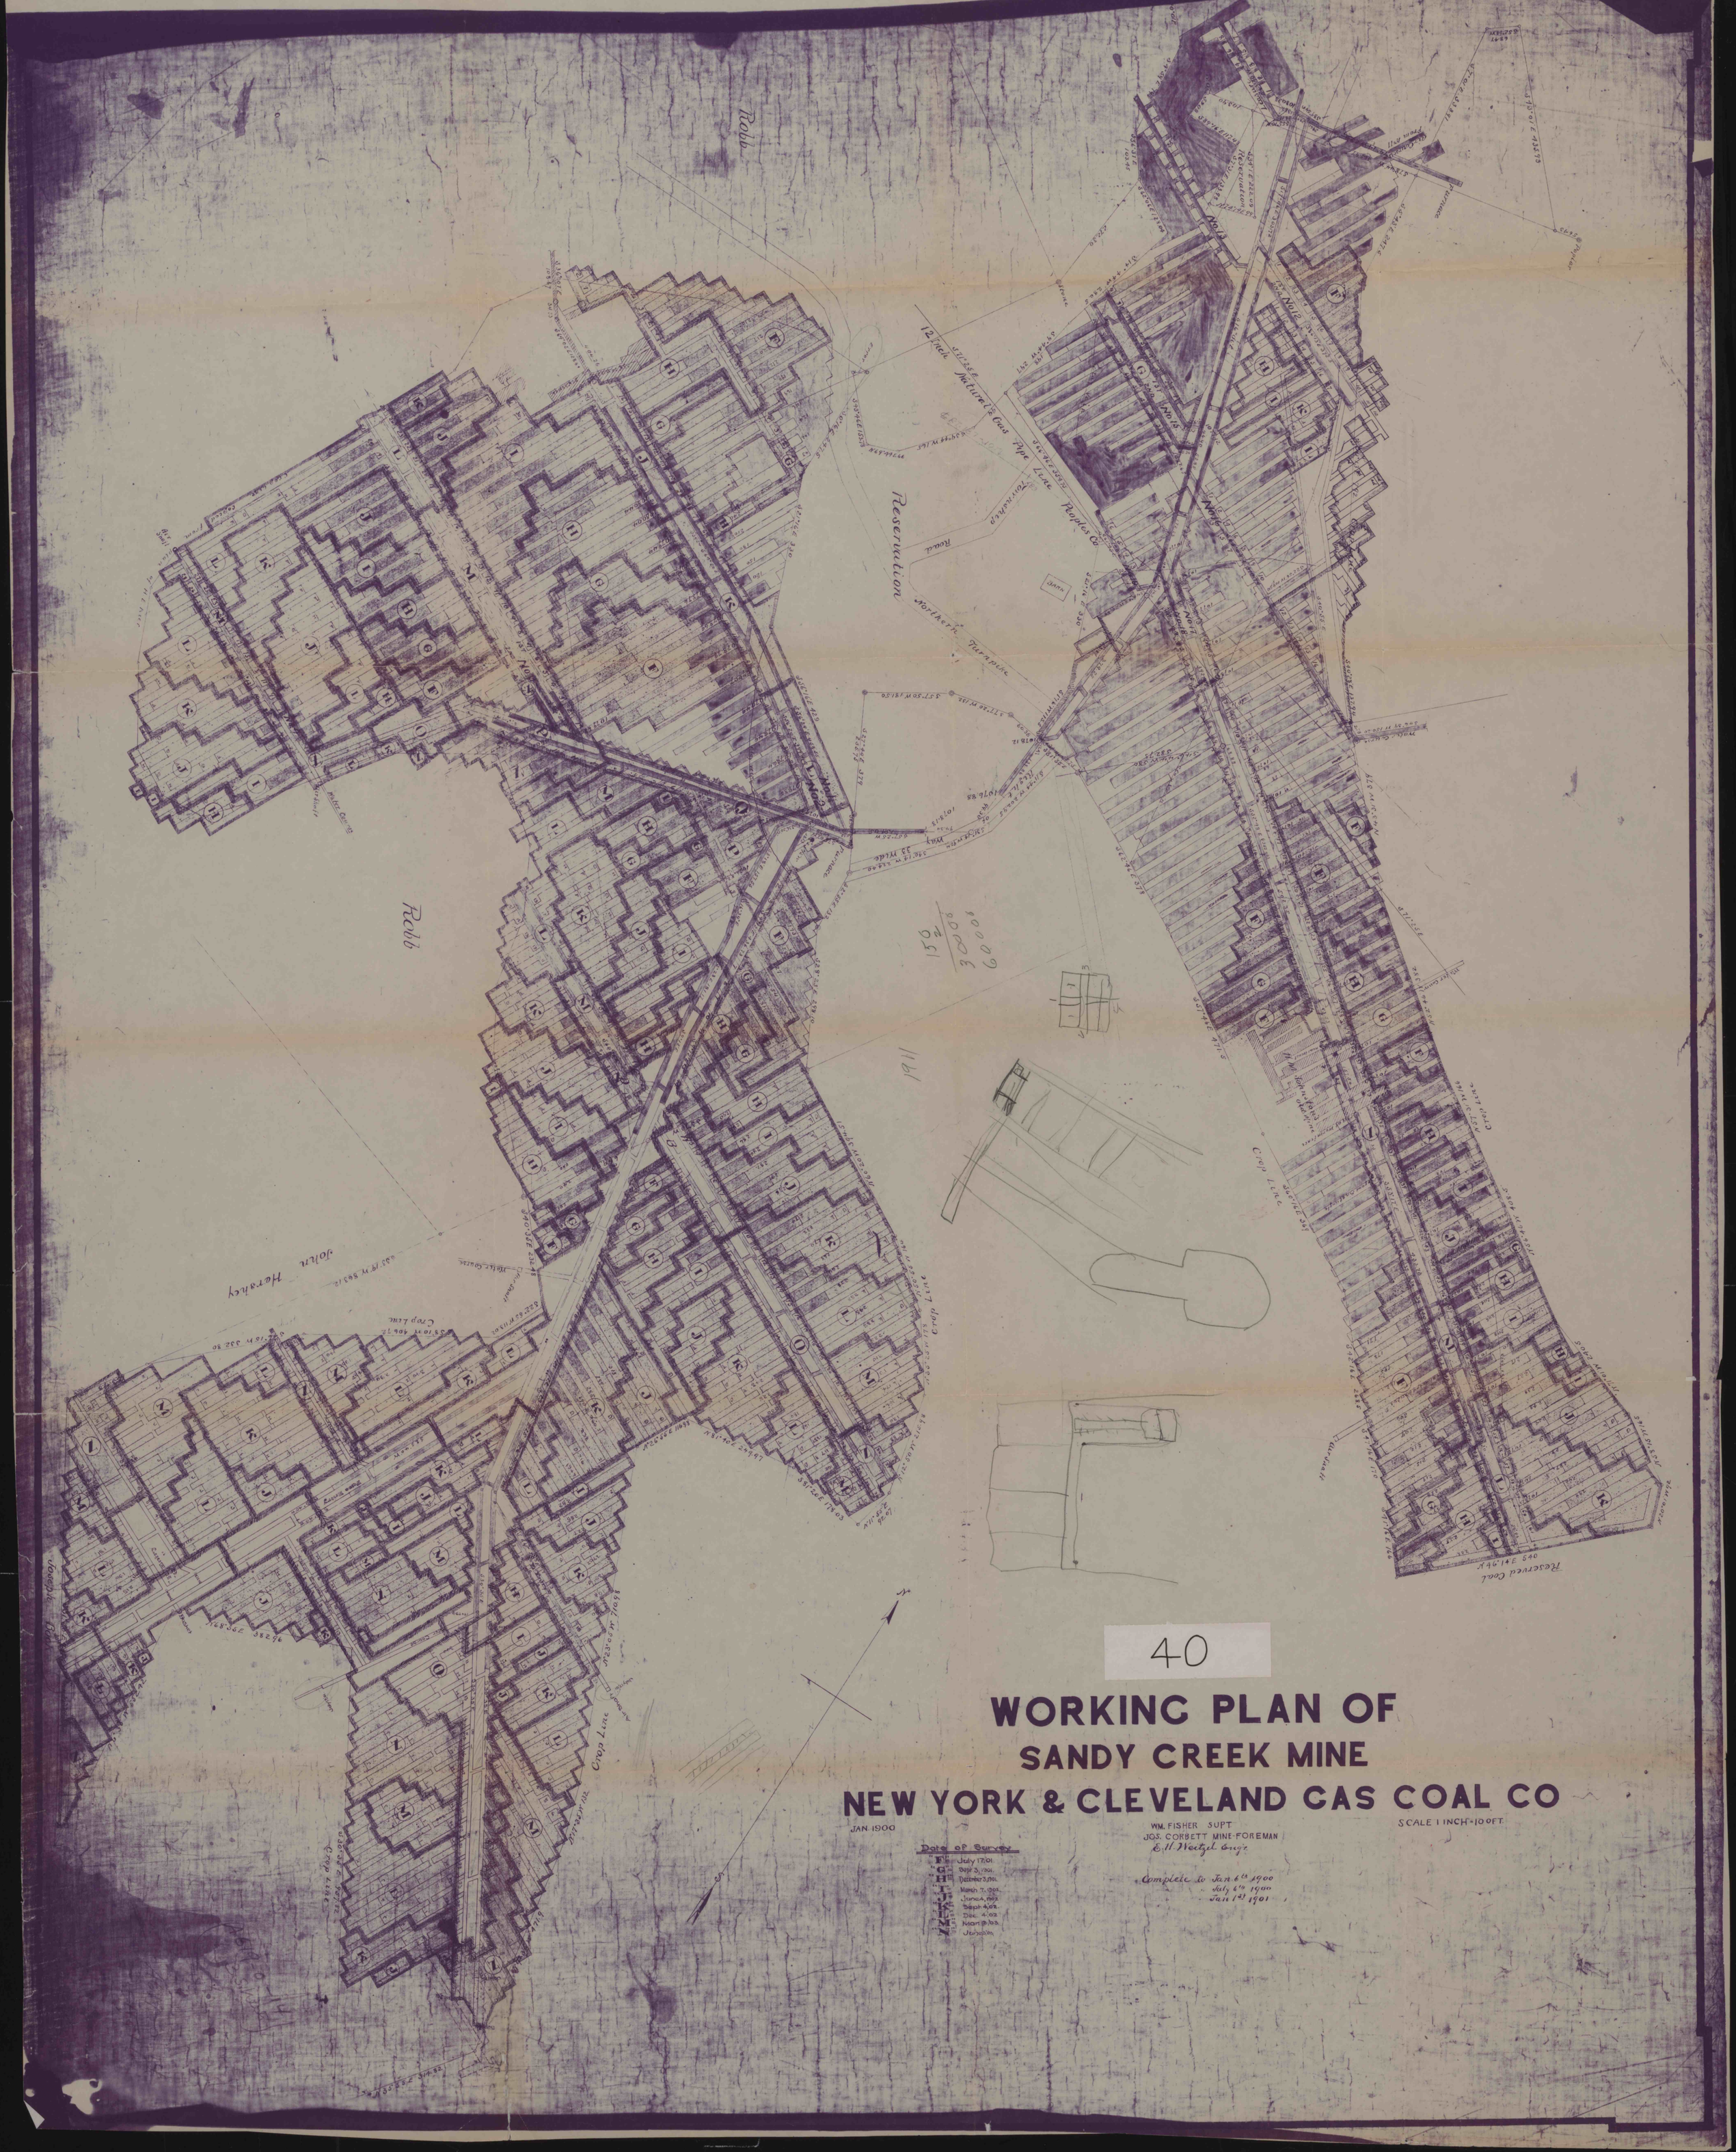
40
WORKING PLAN OF
SANDY CREEK MINE
NEW YORK & CLEVELAND GAS COAL CO
JAN 1900
WM. FISHER SUPT
JOS. CORBETT MINE-FOREMAN
E.H. Weitzel Engr
SCALE 1 INCH = 100 FT
Date of Survey
"E" July 17.01
"G" Sept 3, 1901
"H" December 3, 1901
"J" March 7, 1902
"K" June 4, 1902
"L" Sept 4, 02
"M" Dec 4, 02
"N" March 8, 03
"O" Unknown
Complete to Jan 6th 1900
" July 6th 1900
" Jan 1st 1901
Robb
Robb
John Harvey
Reservation
Northern Turnpike
Natural Gas Pipe Line
Rochester Co
Crop Line
Crop Line
Crop Line
Crop Line
Reserved Coal
Mine No 12
Mine No 13
Mine No 17
Mine No 18
