


23

SANDY CREEK WORKS.

N^o 1 TT.

B. Fullows M.E.
8th December 1875.

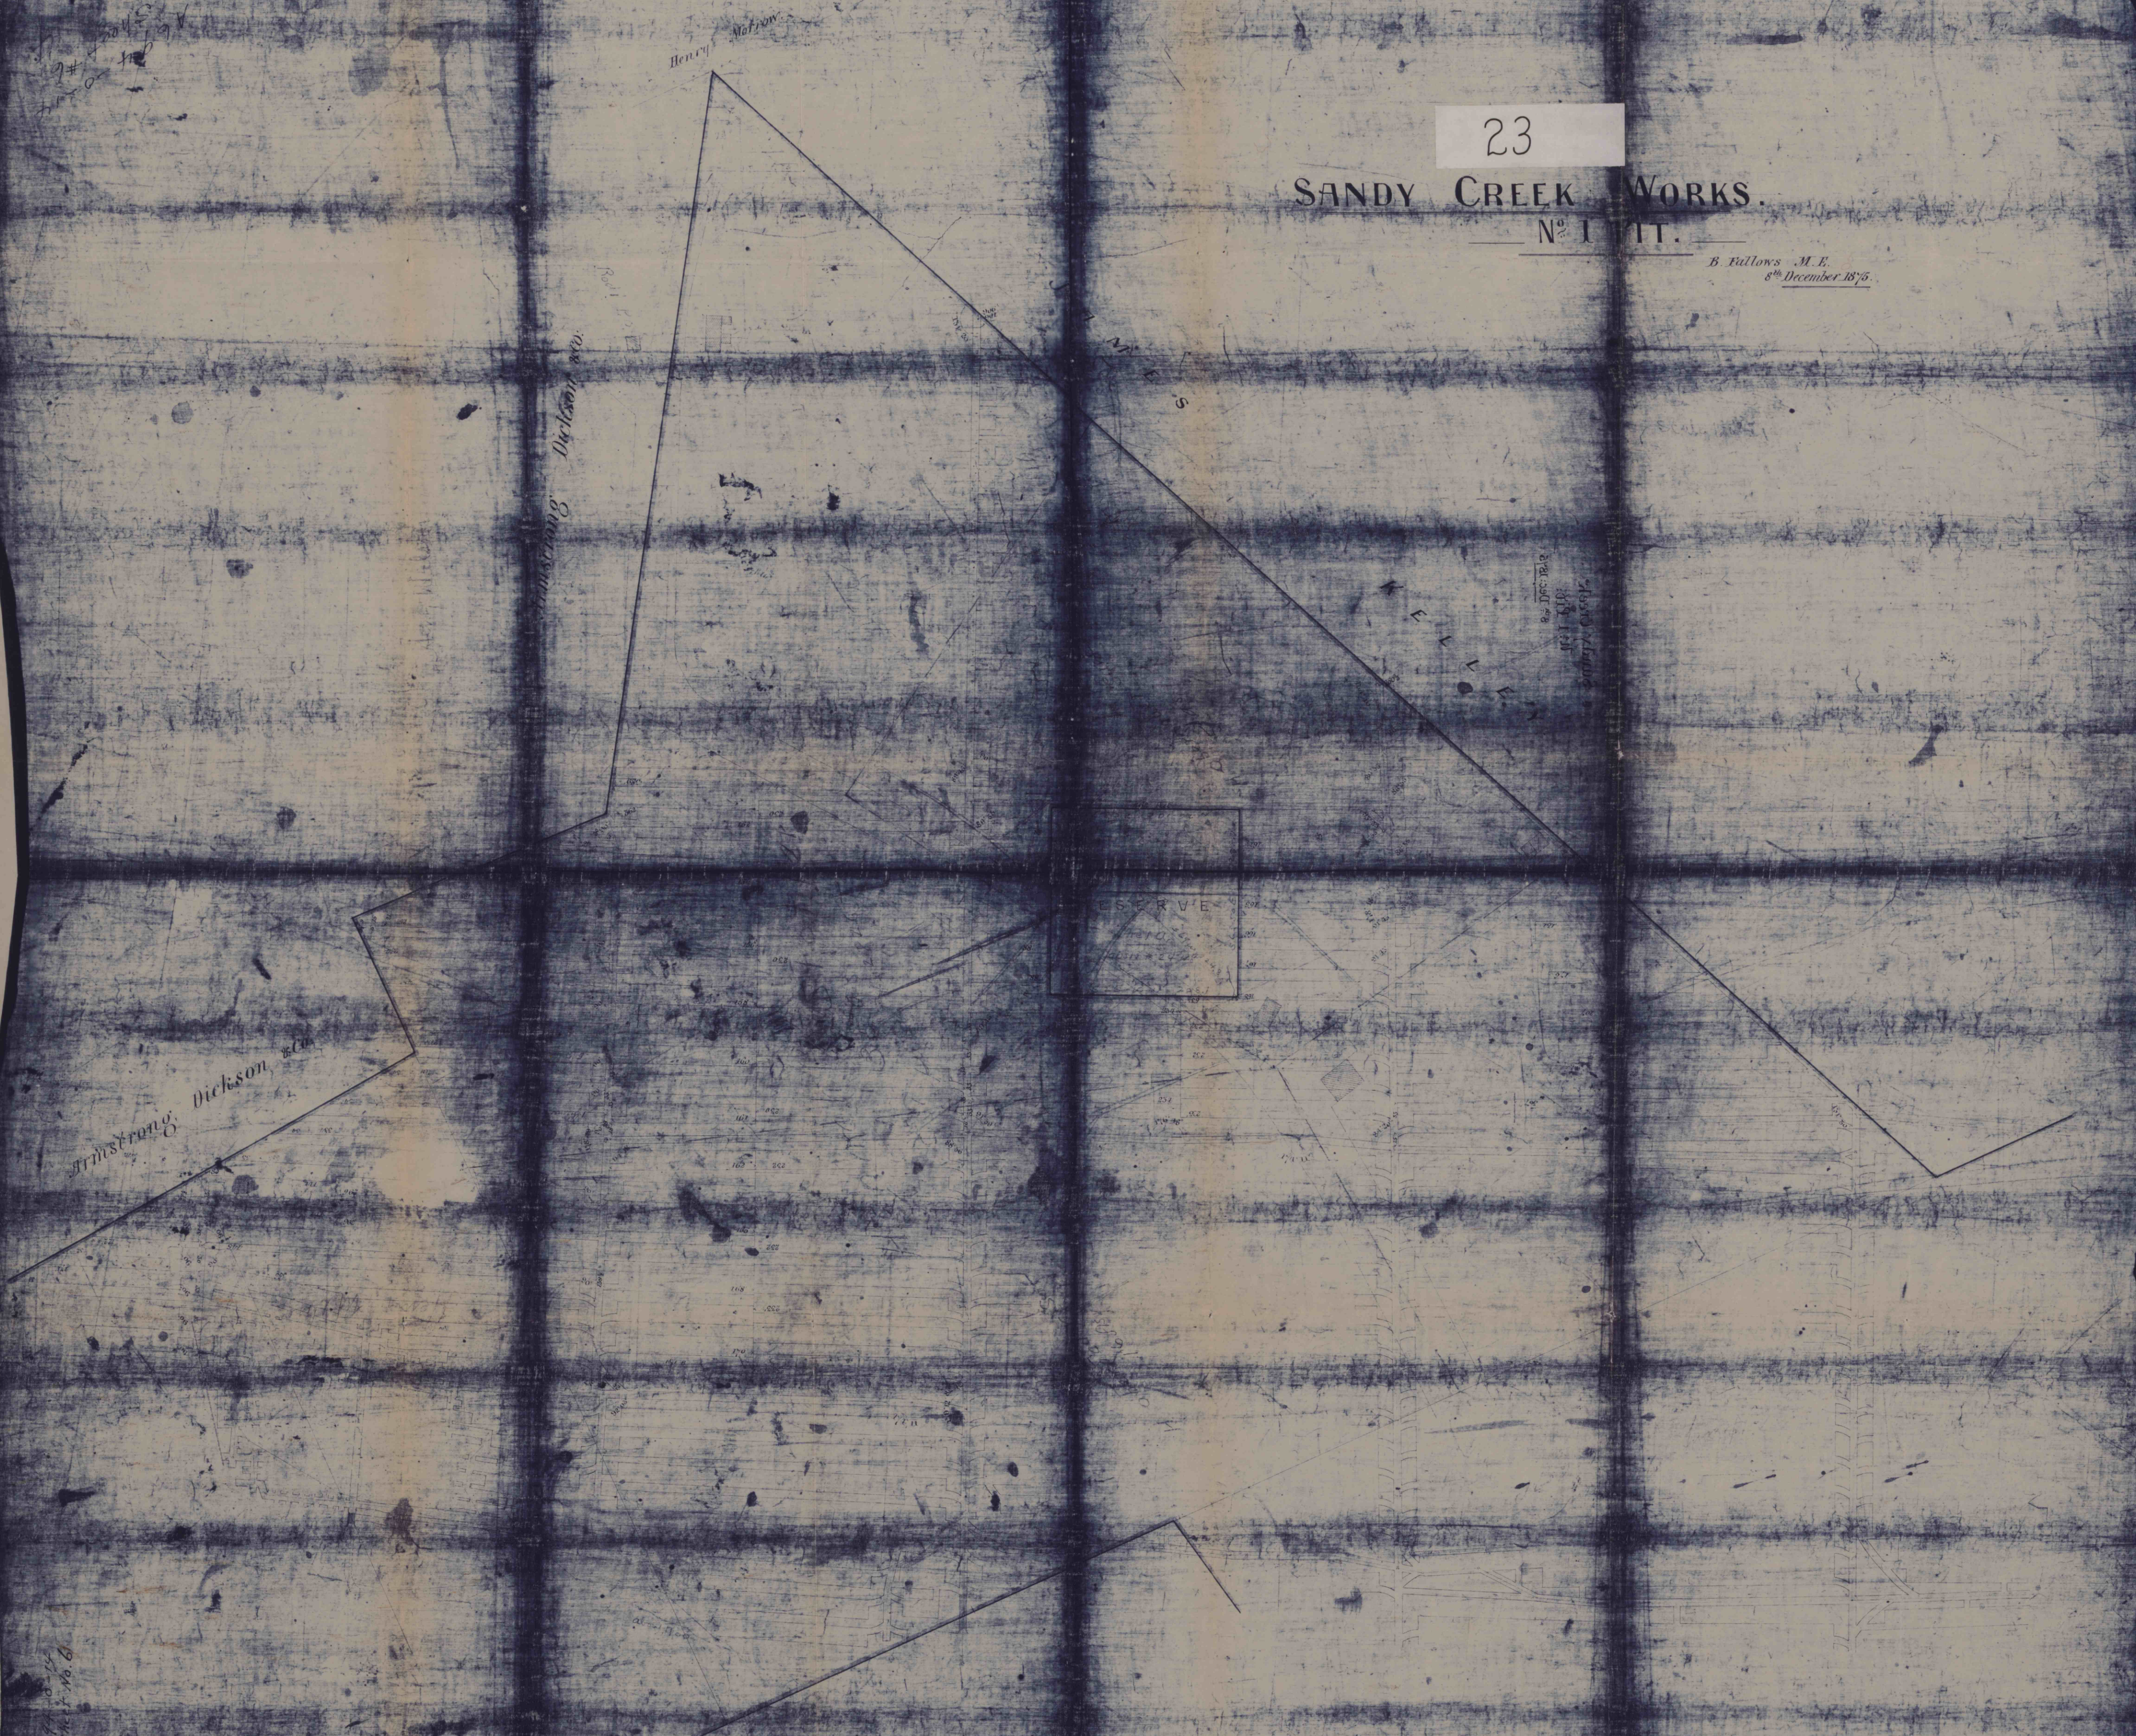

Scale - 60 feet to 1 inch